
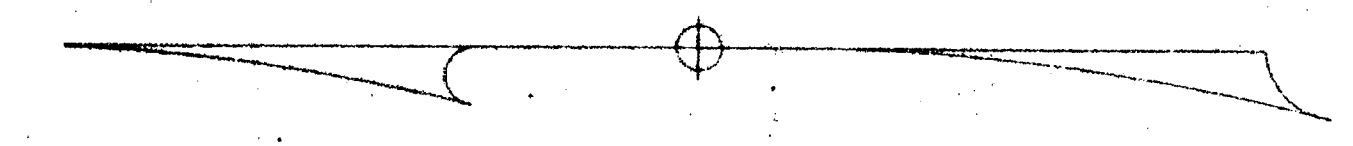


RECEIVED
HARTFORD, CONN.
SEP 16 10 31 AM '69
ROBERT J. GALLIVAN
TOWN & CITY CLERK
28015

The portion of Webster Street shown
on this plan is an established public
street of the City of Hartford.
Russell E. Long
Assistant City Engineer
Sept. 17, 1969

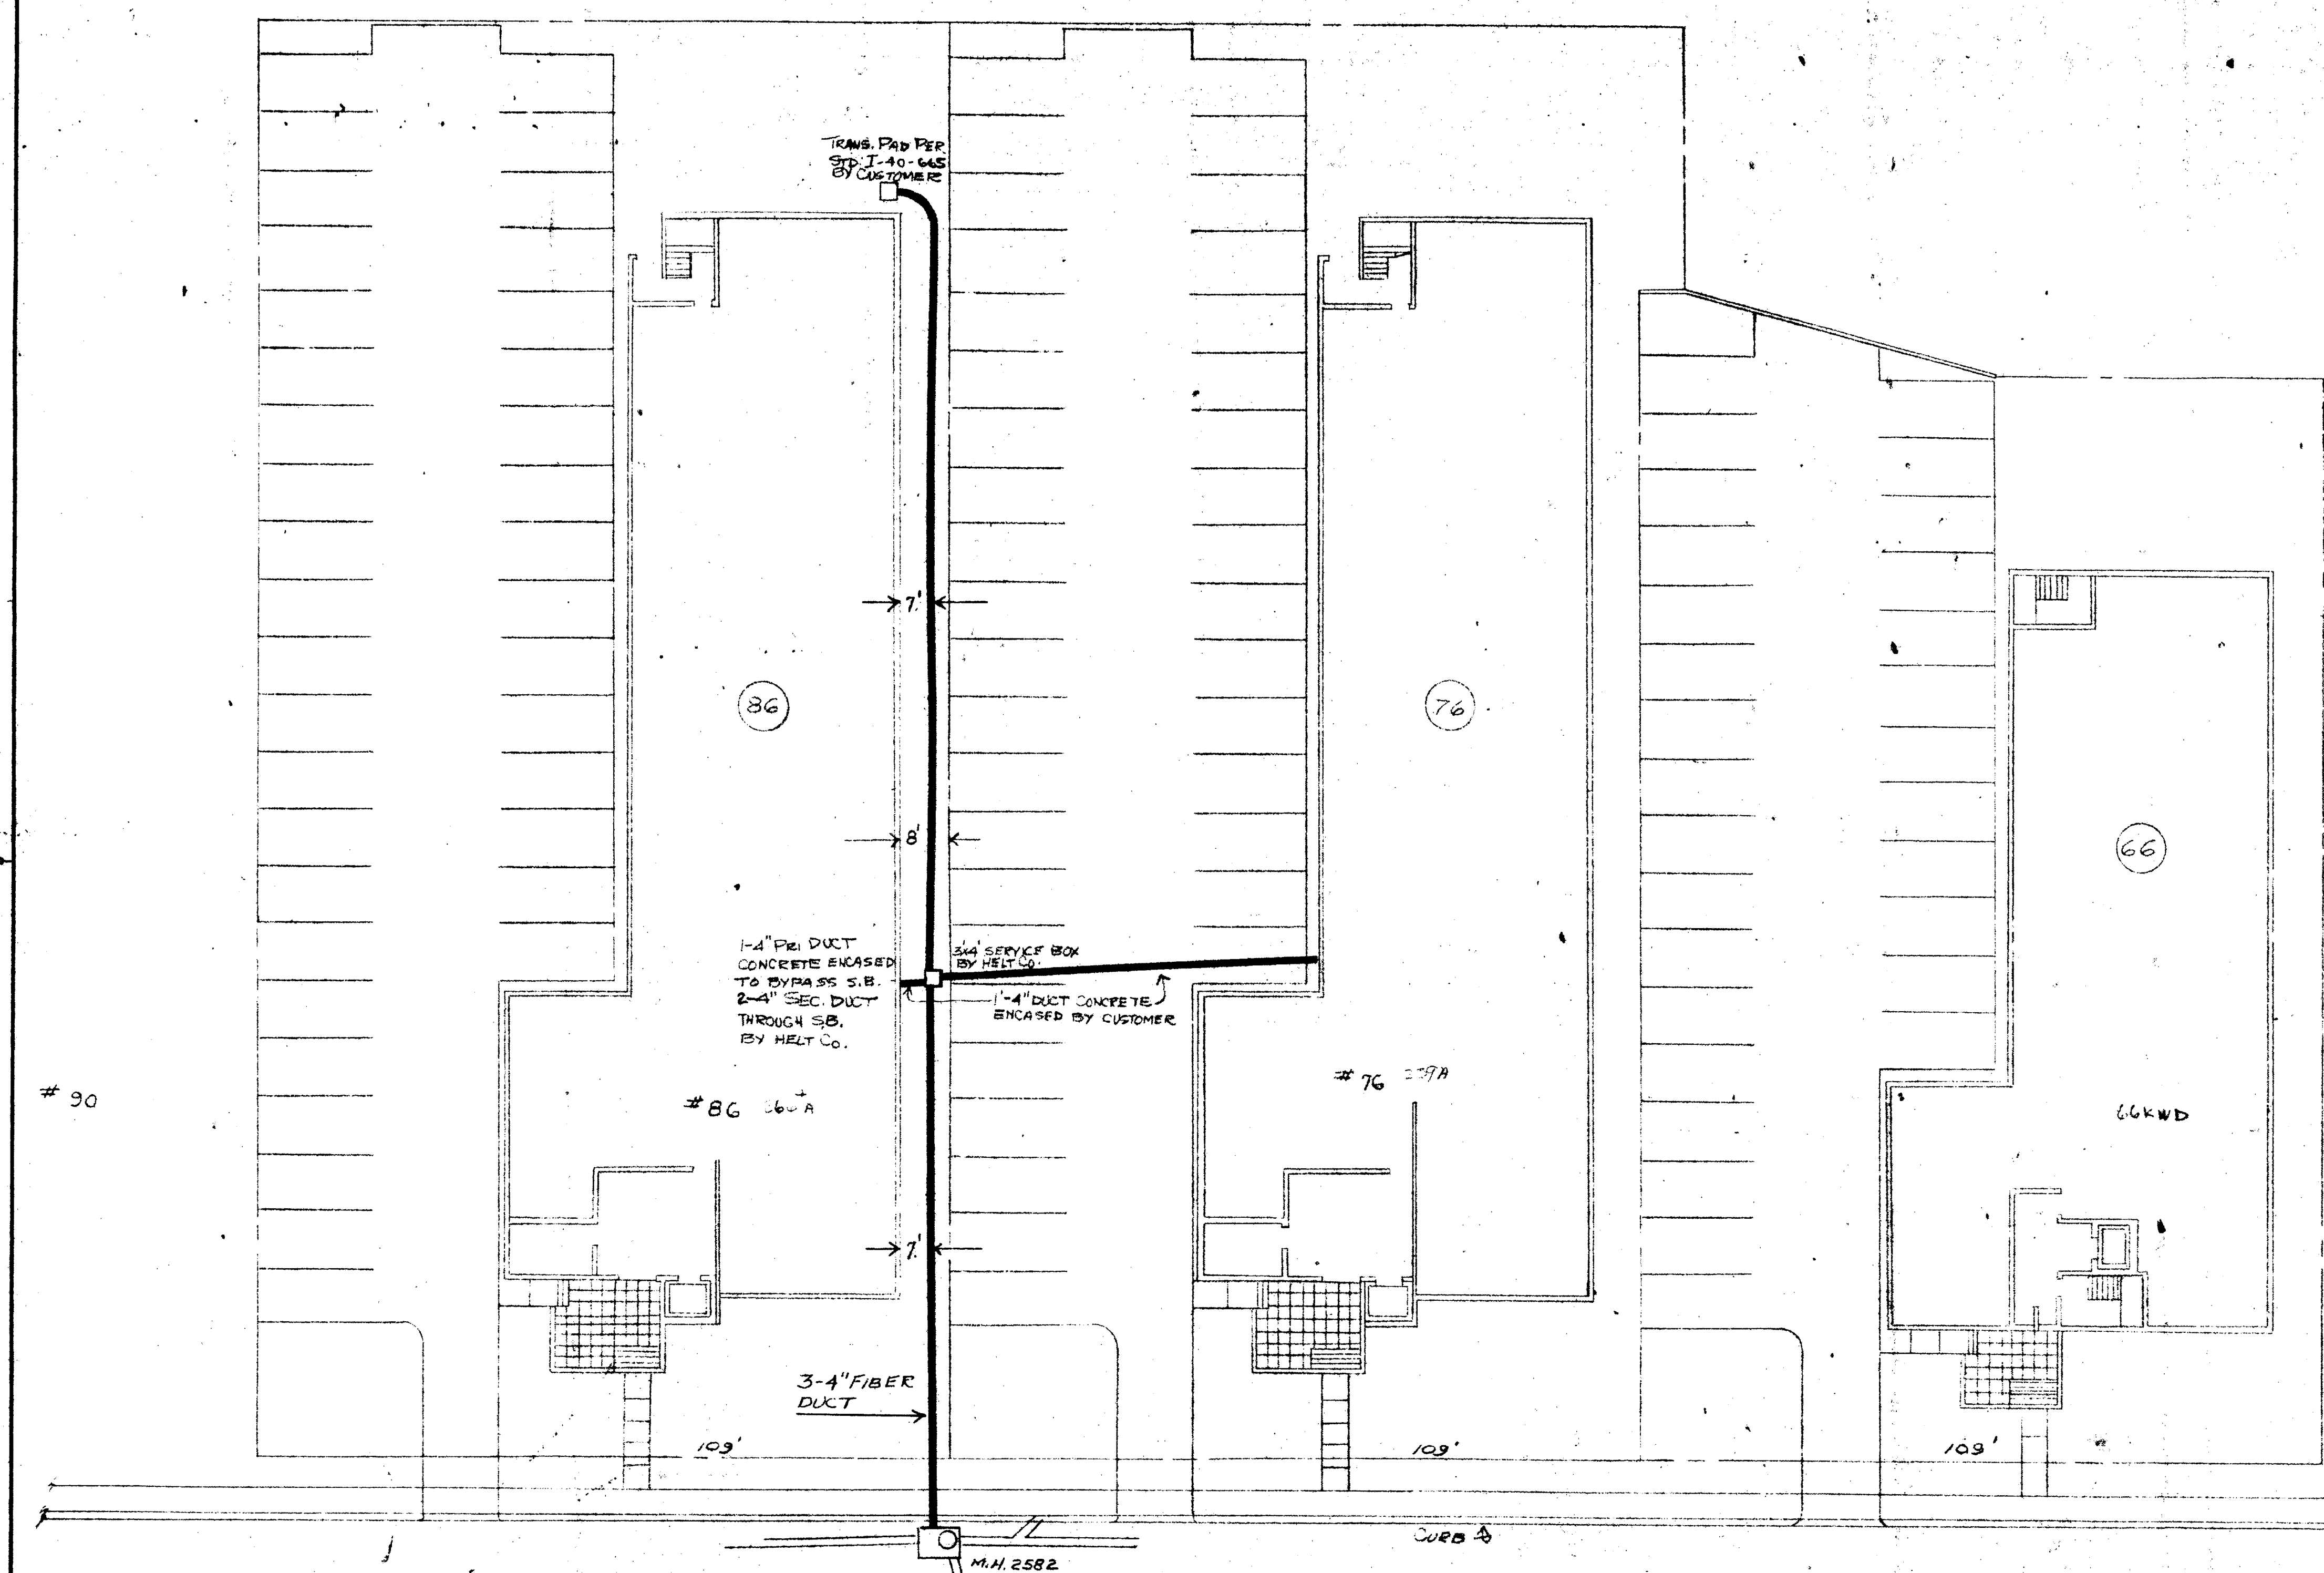

THE UNDERSIGNED UTILITY EMPLOYEE
CERTIFIES THIS MAP TO BE
SUBSTANTIALLY CORRECT AND IN
ACCORDANCE WITH PLANS OF THE
OFFICE OF THE CITY ENGINEER AND
THE HARTFORD ELECTRIC LIGHT COMPANY
SEP 17 1969

NOTE: THIS SKETCH COMPILED FROM A MAP ENTITLED
"SITE PLAN 66, 76 & 86 WEBSTER ST. HARTFORD CONN.
RAYMOND WISNIEWSKI ASSOCIATES, ARCHITECTS
5 ELM ST. WINDSOR, CONN. SCALE 1/4\"/>


WEBSTER STREET

FACILITIES OF THE HARTFORD ELECTRIC LIGHT
CO. ON THE PROPERTY OF VALENTINE FIGIELLI
76 AND 86 WEBSTER ST. HARTFORD, CONN.
SCALE 1/4\"/>

THE HARTFORD ELECTRIC LIGHT CO.
ELECTRIC OPERATIONS DEPARTMENT

DRAWN BY: _____ CHECKED BY: _____ APPROVED BY: _____
SCALE: _____ DATE: _____ NO. _____

NO.	DESCRIPTION	BY	APP. BY

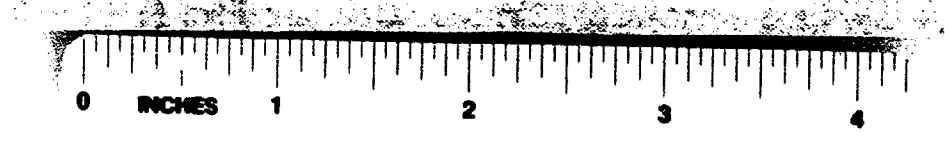

906
CH. 14