


The portions of  
Marin Road and Reserve  
Road shown on this plan are  
established public streets of  
the City of Hartford.  
Feb. 18, 1970

*George E. Neffner*  
City Engineer

RECEIVED  
HARTFORD, CONN.  
FEB 17 2 23 PM '70  
ROBERT J. GALLIVAN  
TOWN & CITY CLERK

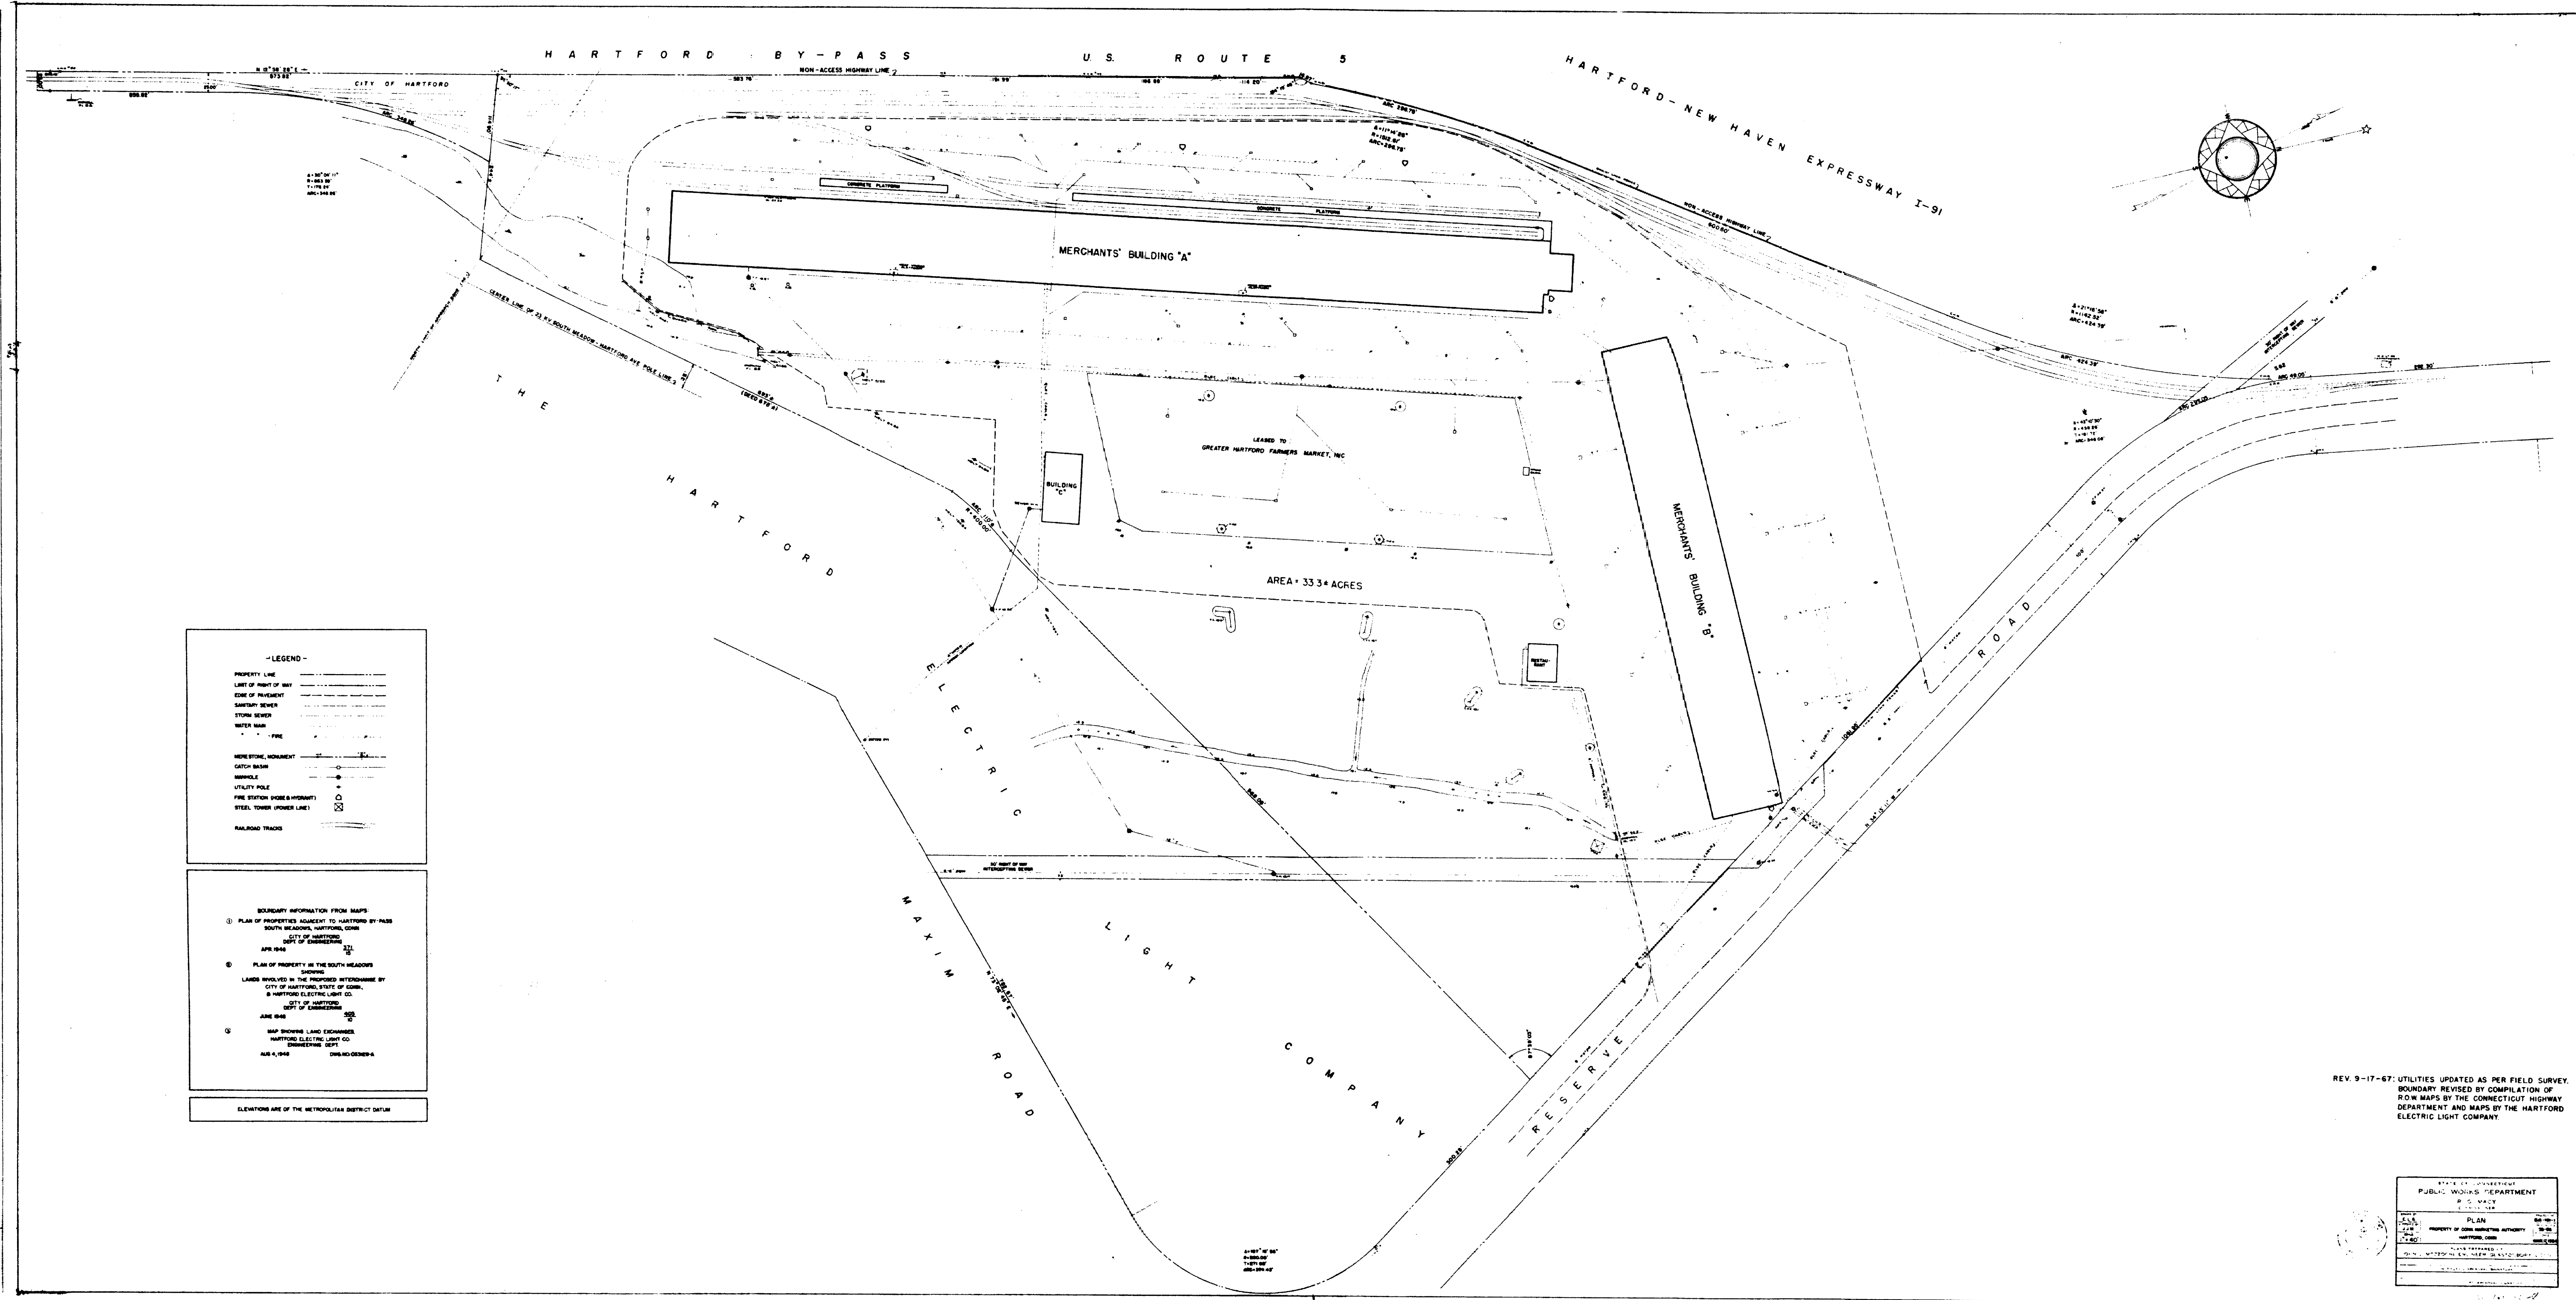

|     |  |
|-----|--|
| 911 |  |
|     |  |
|     |  |

REV. 9-17-67: UTILITIES UPDATED AS PER FIELD SURVEY  
BOUNDARY REVISED BY COMPILATION OF  
ROW MAPS BY THE CONNECTICUT HIGHWAY  
DEPARTMENT AND MAPS BY THE HARTFORD  
ELECTRIC LIGHT COMPANY.

|                                              |                                     |         |  |
|----------------------------------------------|-------------------------------------|---------|--|
| STATE OF CONNECTICUT                         |                                     |         |  |
| PUBLIC WORKS DEPARTMENT                      |                                     |         |  |

