Mortgage Survey for The Society for Savings

PROPERTY OF

HARTFORD LORRAINE C. DEMMA CONNECTICUT

SCALE: 1"=30' 8 BROOKFIELD STREET Feb., 16, 1970

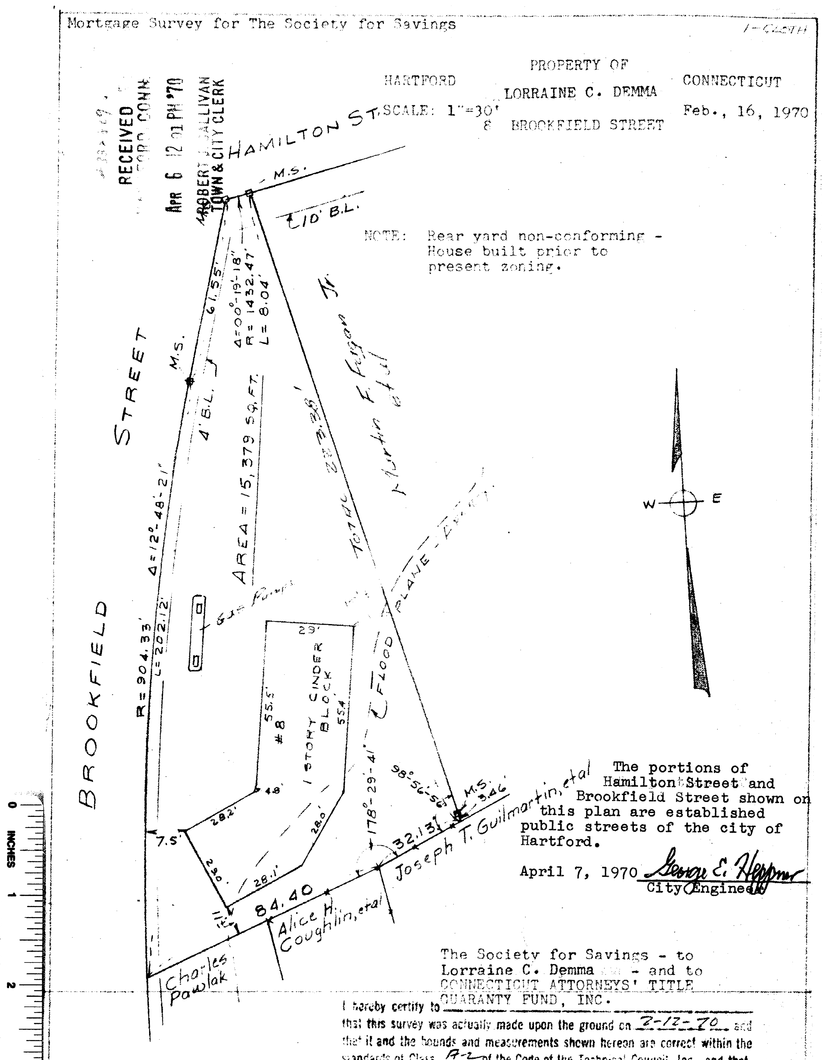

The portions of Hamilton Street and Brookfield Street shown on this plan are established public streets of the city of Hartford.

April 7, 1970 Leon E. Hoffman
City Engineer

The Society for Savings - to
Lorraine C. Demma - and to
CONNECTICUT ATTORNEYS' TITLE GUARANTY FUND, INC.

I hereby certify to _____ that this survey was actually made upon the ground on 2-12-70 and that it and the bounds and measurements shown hereon are correct within the standards of Class A-2 of the Code of the Technical Council, Inc., and that, unless otherwise shown, dead lines and lines of actual possession are the same, buildings are located as shown and do not encroach over or upon street, dead or building lines, there are no violations of zoning regulations with reference to the location of said buildings, and there are no easements or encroachments affecting this property apparent from a careful inspection of the same, other than those noted and depicted hereon.

STATE OF CONNECTICUT HANS B. JENSEN No. 2506 REGISTERED LAND SURVEYOR

(see note)

CLOSE, JENSEN & MILLER
CIVIL ENGINEERS & SURVEYORS
BY _____

EASY FILE CORP. IRVINE CA EFM 34

915