

EAST FILE CORP IRVINE CA EPH 34

|     |  |
|-----|--|
| 921 |  |
|-----|--|

921-3


RECEIVED  
HARTFORD, CONN  
JUL 2 10 21 AM '70  
ROBERT J. SALLIVAN  
TOWN & CITY CLERK

NO. 188 SIGOURNEY STREET  
HARTFORD, CONN.



71.9 71.5 71.3  
SIGOURNEY STREET

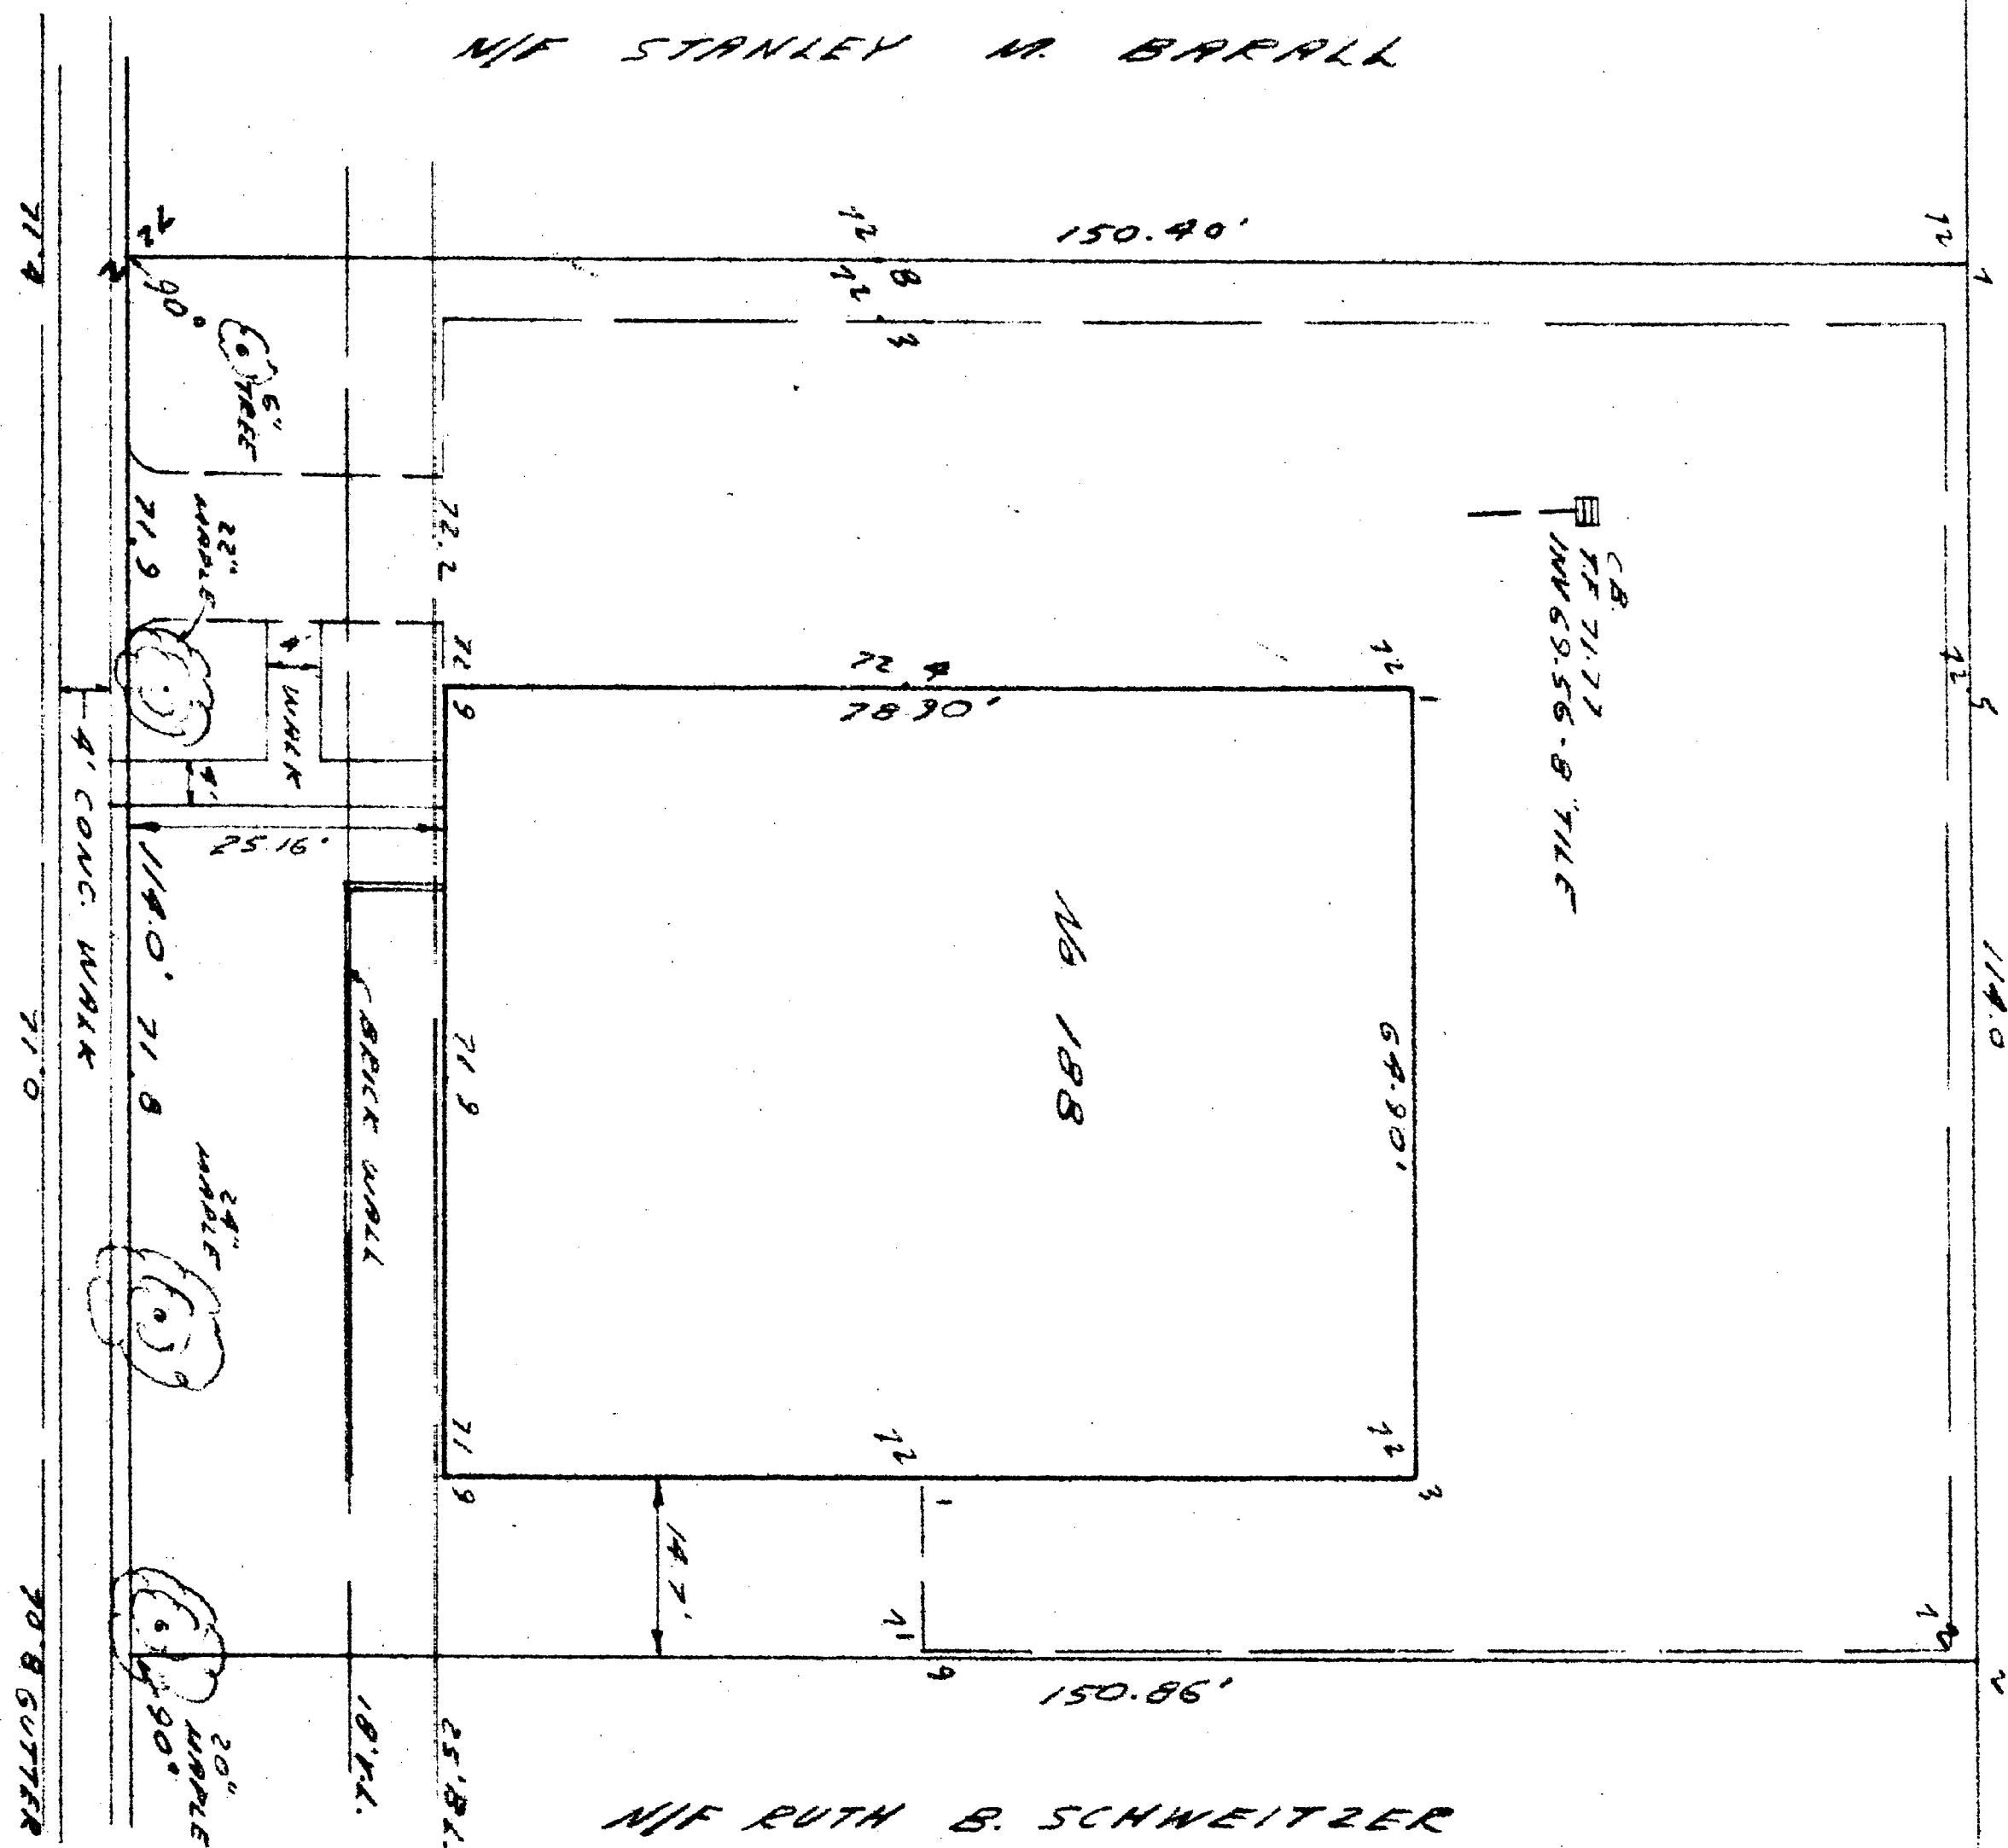


The portion of Sigourney Street shown on this plan is an established public street of the City of Hartford.

PLAT PLAN FOR  
ZONING AUTHORITY  
CITY OF HARTFORD,  
CONNECTICUT.

July 2, 1970

*Joseph S. Higgins*  
City Engineer

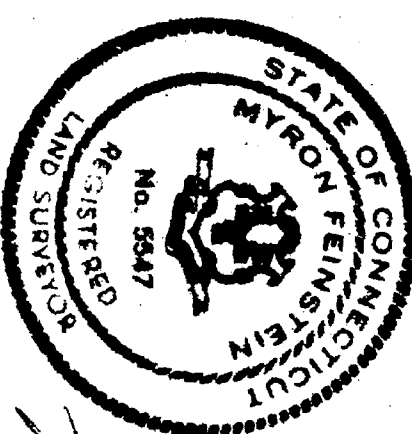

I HEREBY CERTIFY THIS PLAN TO BE SUBSTANTIALLY CORRECT and no zoning regulations have been violated.

*Myron Feinstein*

MYRON FEINSTEIN ASSOCIATES  
LAND SURVEYING & LAND PLANNING  
ENGINEERING  
WEST HARTFORD  
CONNECTICUT

| SCALE  | DATE    | REVISED | COMM. NO. |
|--------|---------|---------|-----------|
| 1"=20' | 5.12.70 |         | 7043      |