


The portion of Locust Street shown on this plan is an established public street of the City of Hartford
March 19, 1971

Serge E. Hopper
City Engineer

341007-341010
RECEIVED
HARTFORD, CONN.
MAR 19 10 15 AM '71
ROBERT J. SULLIVAN
TOWN & CITY CLERK

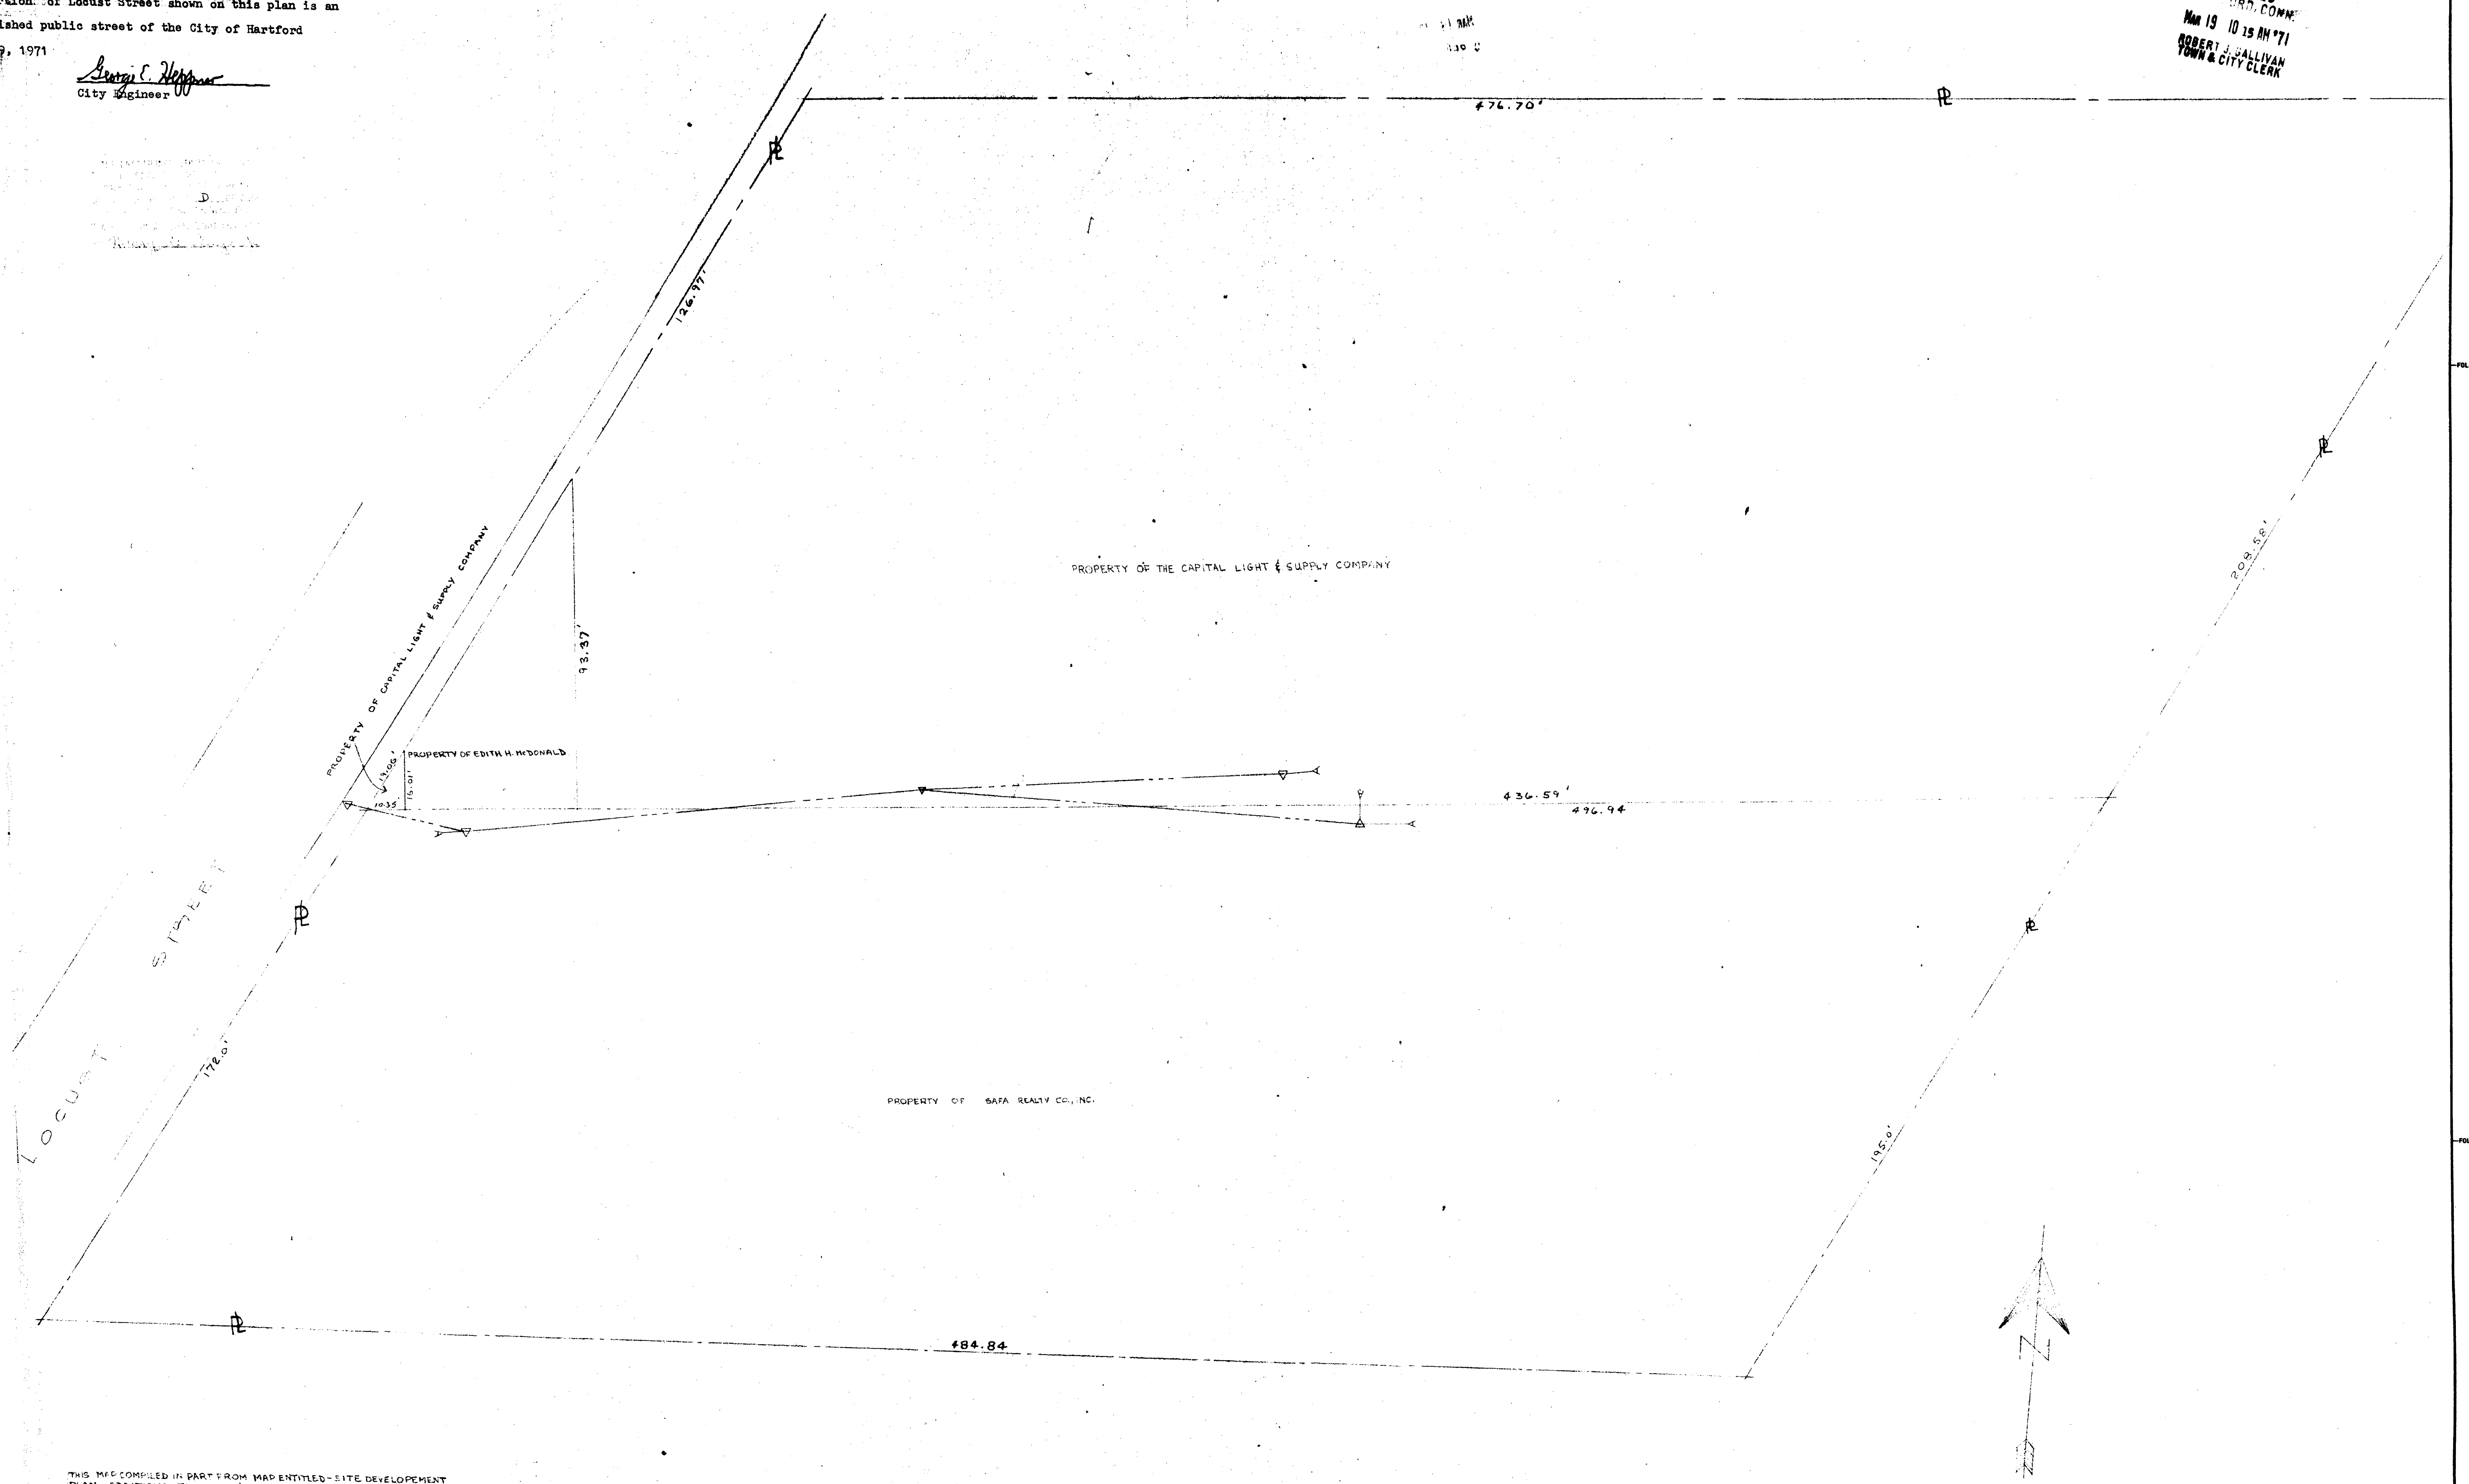

THIS MAP COMPILED IN PART FROM MAP ENTITLED "SITE DEVELOPMENT PLAN" ADDITIONS TO SMITH & FAZZINA, LOCUST STREET, HARTFORD, CONN., R.J. DICORCIA ASSOCIATES, ARCHITECTS AND PLANNERS, MANCHESTER, CONNECTICUT, SCALE 1"=20.0', 12-14-70, SHEET NO. A-1, ALSO FROM CITY OF HARTFORD LAND RECORDS

LEGEND

- ▲— ANCHOR GUY
- ▲ POLE
- OVERHEAD CONDUCTORS

HELCO FACILITIES ON THE PROPERTY OF THE CAPITAL LIGHT & SUPPLY COMPANY AND SARA REALTY CO., INC. OF LOCUST ST. HARTFORD, CONNECTICUT.

THE HARTFORD ELECTRIC LIGHT CO.
ELECTRIC OPERATIONS DEPARTMENT

DRAWN BY H. G. S. S. CHECKED BY _____
SCALE 1"=20'
DATE 3-4-71 NO. D014522

NO.	DATE	DESCRIPTION	BY	APP. BY



PLAN FILED
926
ENCL.