


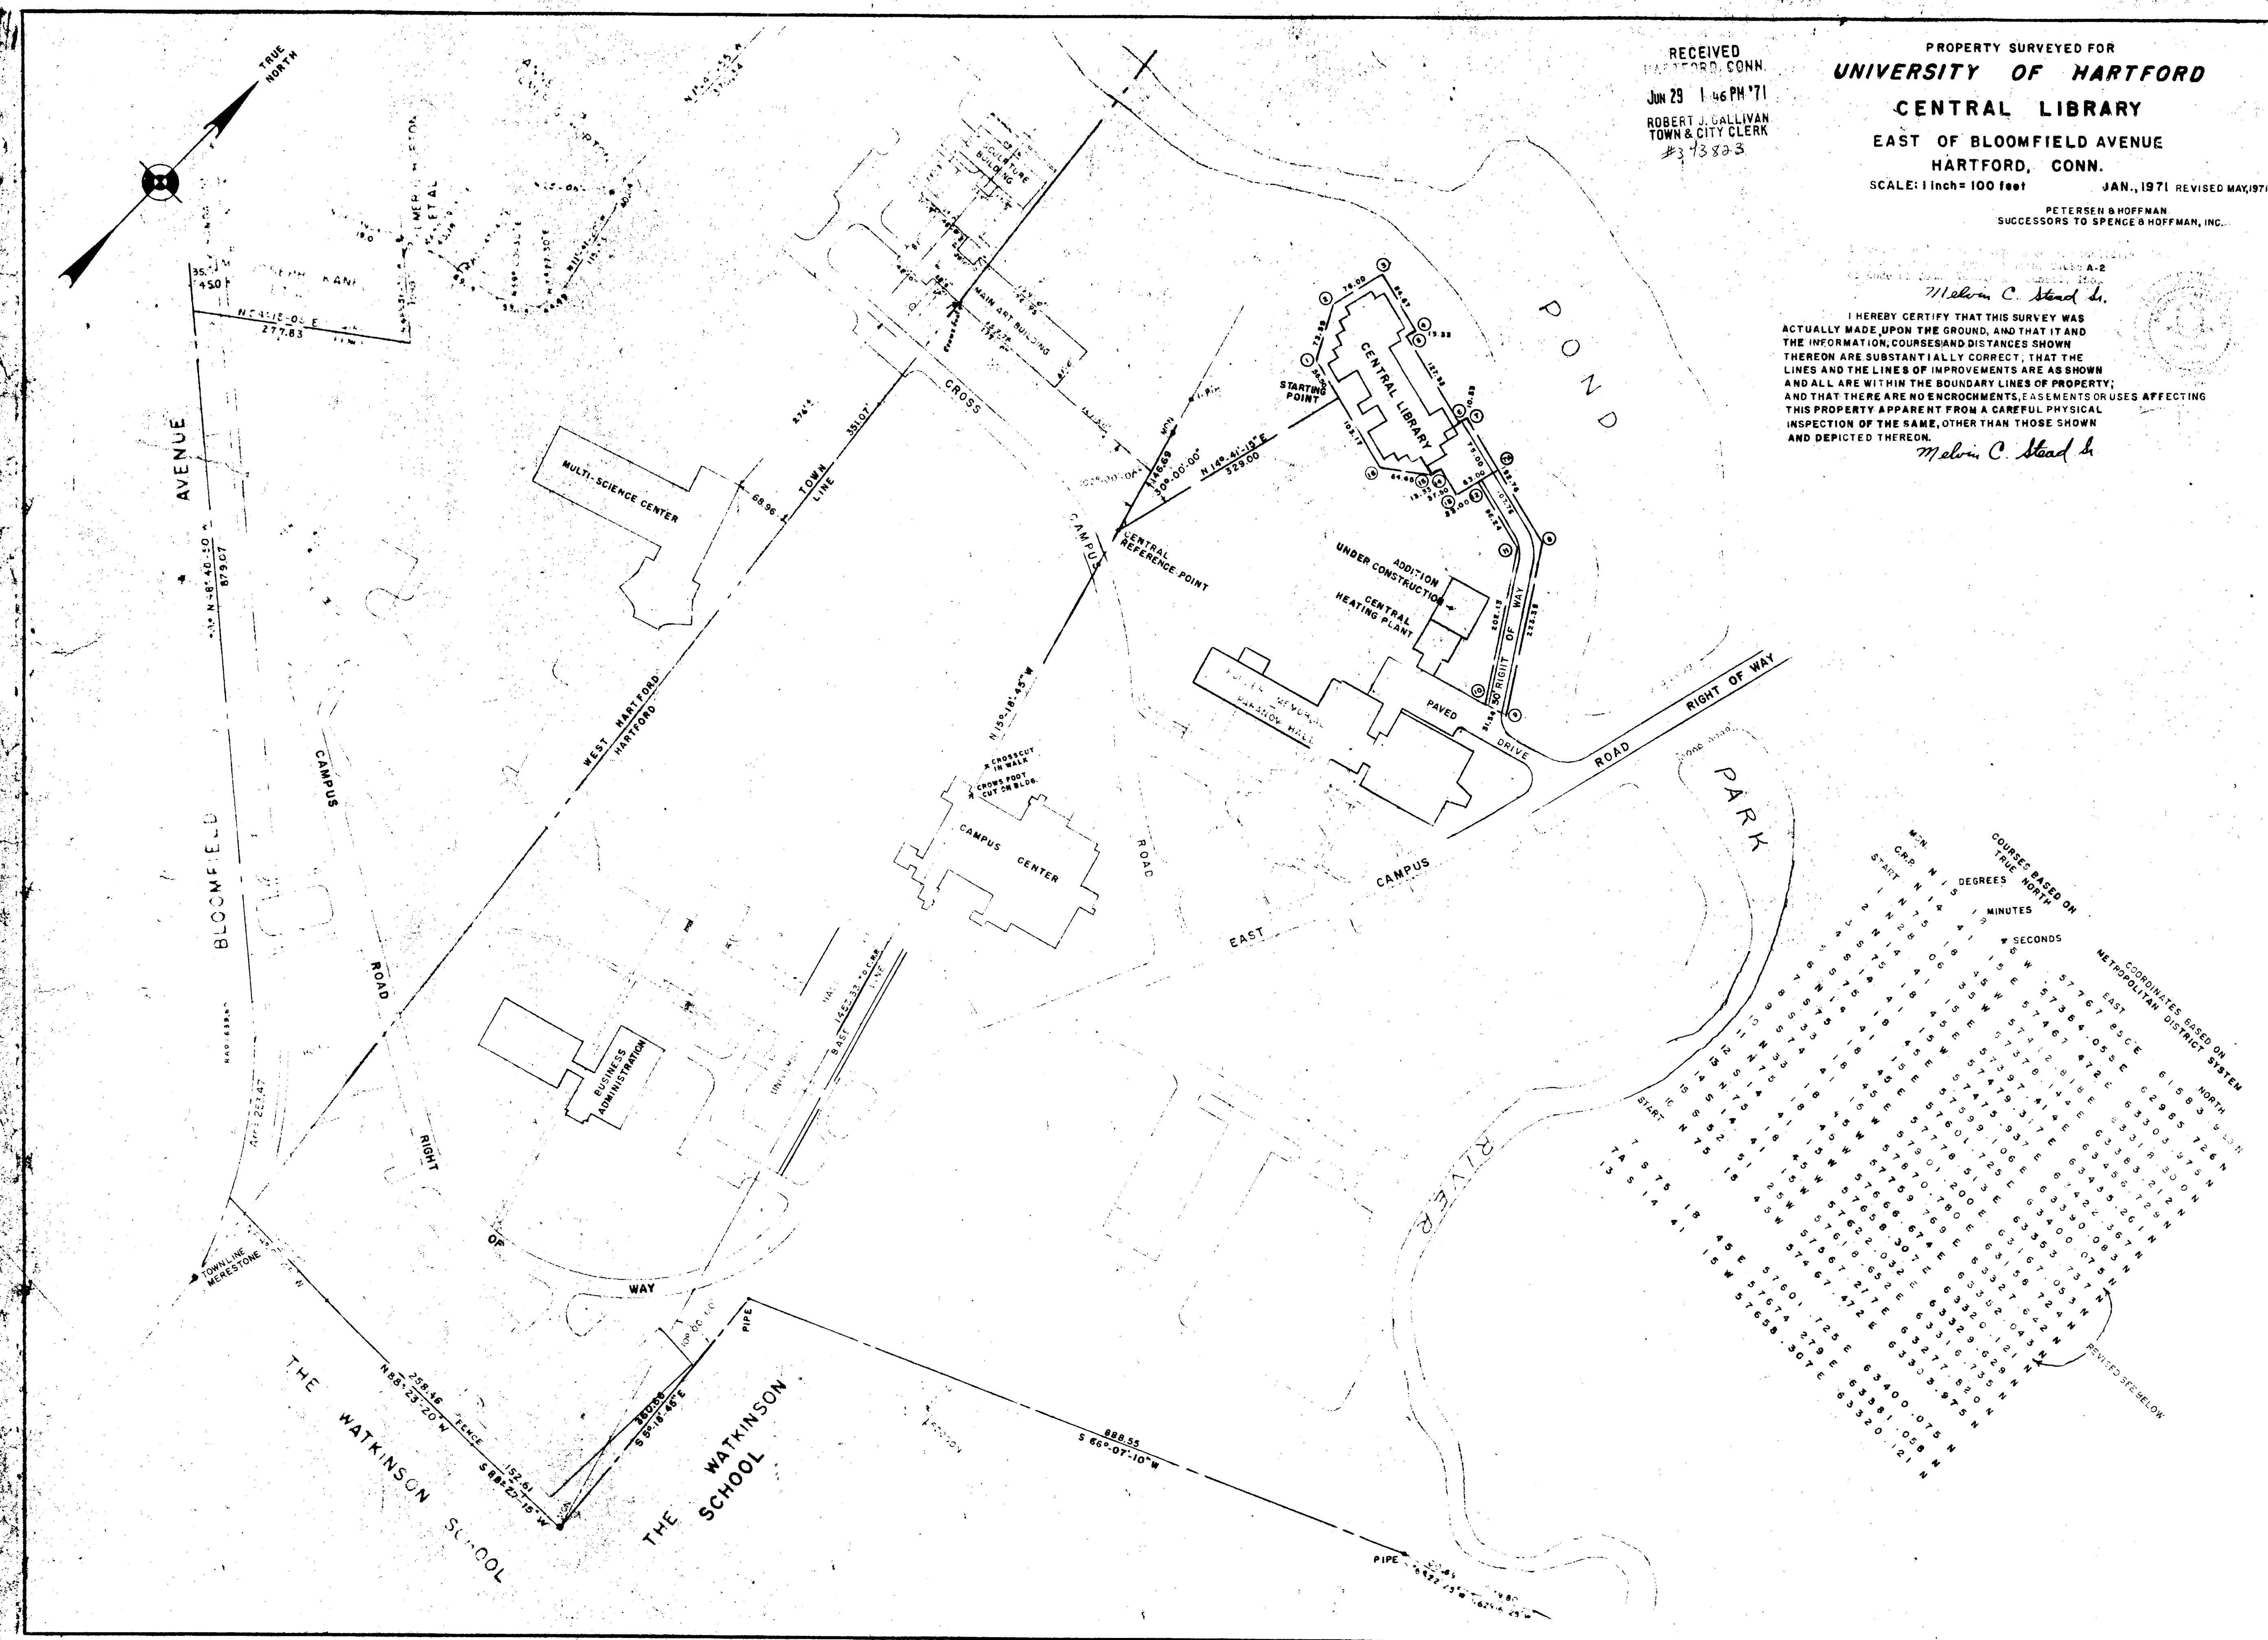

RECEIVED
HARTFORD, CONN.
JUN 29 1 46 PM '71
ROBERT J. GALLIVAN
TOWN & CITY CLERK
#373823

PROPERTY SURVEYED FOR
UNIVERSITY OF HARTFORD
CENTRAL LIBRARY
EAST OF BLOOMFIELD AVENUE
HARTFORD, CONN.
SCALE: 1 inch = 100 feet
JAN., 1971 REVISED MAY, 1971
PETERSEN & HOFFMAN
SUCCESSORS TO SPENCE & HOFFMAN, INC.

Melvin C. Stead Jr.
I HEREBY CERTIFY THAT THIS SURVEY WAS
ACTUALLY MADE UPON THE GROUND, AND THAT IT AND
THE INFORMATION, COURSES AND DISTANCES SHOWN
THEREON ARE SUBSTANTIALLY CORRECT; THAT THE
LINES AND THE LINES OF IMPROVEMENTS ARE AS SHOWN
AND ALL ARE WITHIN THE BOUNDARY LINES OF PROPERTY;
AND THAT THERE ARE NO ENCROACHMENTS, EASEMENTS OR USES AFFECTING
THIS PROPERTY APPARENT FROM A CAREFUL PHYSICAL
INSPECTION OF THE SAME, OTHER THAN THOSE SHOWN
AND DEPICTED THEREON.
Melvin C. Stead Jr.

COURSES BASED ON			COORDINATES BASED ON		
TRUE NORTH			METROPOLITAN DISTRICT SYSTEM		
START	DEGREES	MINUTES	EAST	NORTH	
933

