

RECEIVED
HARTFORD, CONN.
JUL 21 10 23 AM '71
ROBERT J. SULLIVAN
TOWN & CITY CLERK

THE UNAPPROVED WATER SERVICE
CENTERS THIS MAP TO BE
"SUBSTANTIALLY ACCURATE" AND IN
ACCORDANCE WITH THE CITY OF HARTFORD
OF HARTFORD, CONNECTICUT, AND
THE HARTFORD ELECTRIC LIGHT CO.
AND HARTFORD WATER CO.

PROPERTY OF THE CAPITAL LIGHT & SUPPLY COMPANY

PROPERTY OF CAPITAL LIGHT & SUPPLY COMPANY

PROPERTY OF EDITH H. McDONALD

PROPERTY OF SARA REALTY CO., INC.

STREET

184.84


436.59
496.94

208.58

155.0

LEGEND

ANCHOR GUY
POLE
OVERHEAD CONDUCTORS

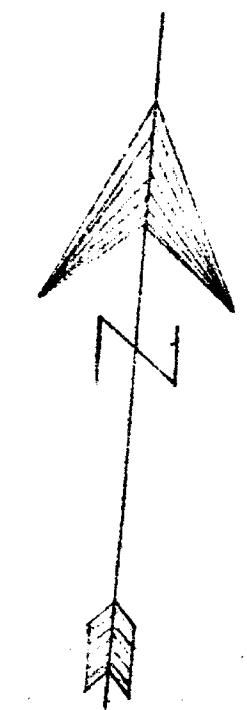


HELCO FACILITIES ON THE PROPERTY OF THE CAPITAL
LIGHT & SUPPLY COMPANY AND SARA REALTY CO., INC. OF
LOCUST ST. HARTFORD, CONNECTICUT.

THE HARTFORD ELECTRIC LIGHT CO.
ELECTRIC OPERATIONS DEPARTMENT

DRAWN BY H.G.S.33 CHECKED BY _____ APPROVED BY _____
SCALE 1" = 20'
DATE 3-4-71 NO. D014522

NO.	DATE	ADDED POLE NUMBER	DESCRIPTION	BY	APP. BY
1	6-29-71				

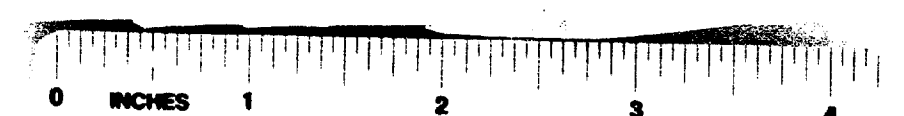

938