


The portion of Newfield Ave. shown on this plan is an established public street of the City of Hartford, Conn.
Oct. 15, 1971
James E. Higgins
City Engineer

RECEIVED
HARTFORD, CONN.
Oct 15 10 50 AM '71
ROBERT J. GALLIVAN
TOWN & CITY CLERK

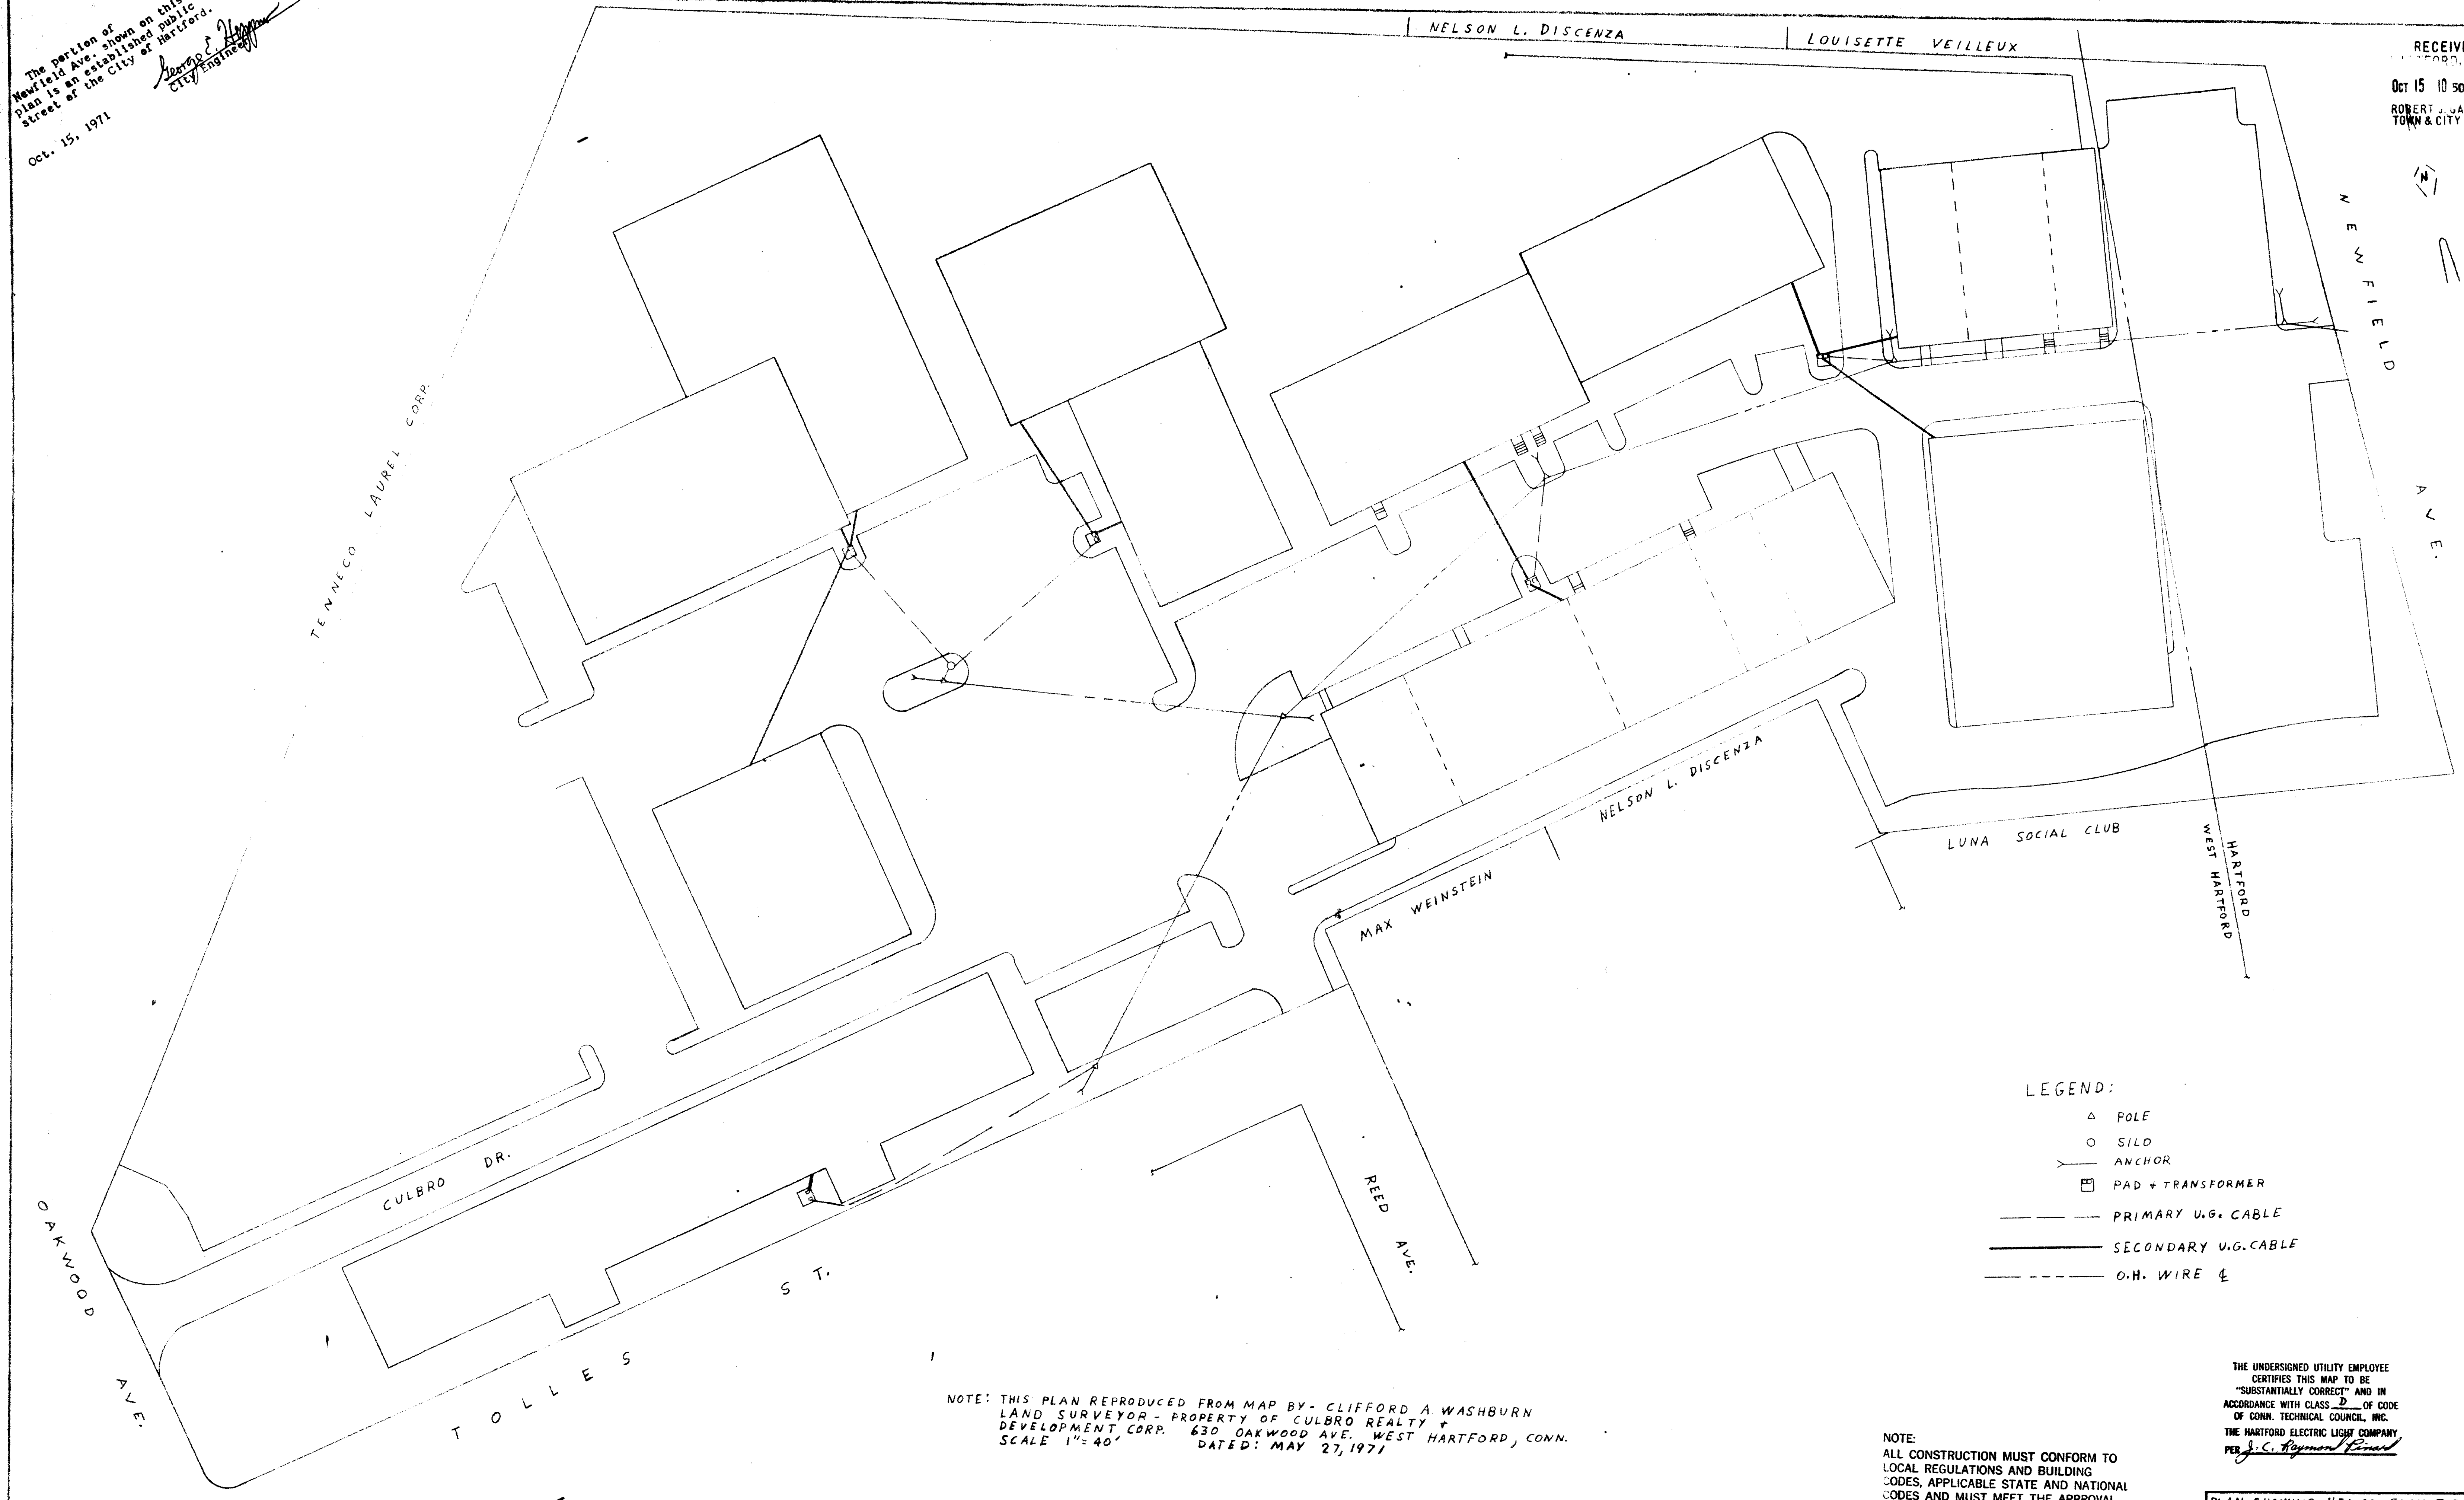

- LEGEND:
- △ POLE
 - SILO
 - ⊙ ANCHOR
 - PAD + TRANSFORMER
 - PRIMARY U.G. CABLE
 - - - SECONDARY U.G. CABLE
 - · - · - O.H. WIRE

NOTE: THIS PLAN REPRODUCED FROM MAP BY - CLIFFORD A. WASHBURN
LAND SURVEYOR - PROPERTY OF CULBRO REALTY & DEVELOPMENT CORP.
630 OAKWOOD AVE. WEST HARTFORD, CONN.
SCALE 1" = 40' DATED: MAY 27, 1971

NOTE:
ALL CONSTRUCTION MUST CONFORM TO
LOCAL REGULATIONS AND BUILDING
CODES, APPLICABLE STATE AND NATIONAL
CODES AND MUST MEET THE APPROVAL
OF THE APPROPRIATE LOCAL AUTHORITY.

THE UNDERSIGNED UTILITY EMPLOYEE
CERTIFIES THIS MAP TO BE
"SUBSTANTIALLY CORRECT" AND IN
ACCORDANCE WITH CLASS D OF CODE
OF CONN. TECHNICAL COUNCIL, INC.
THE HARTFORD ELECTRIC LIGHT COMPANY
PER *J. C. Raymond*

PLAN SHOWING HELCO FACILITIES ON THE
PROPERTY OF CULBRO REALTY & DEVELOPMENT
CORP. 630 OAKWOOD AVE. WEST HARTFORD,
AND NEWFIELD AVE. HARTFORD, CONN.
SCALE 1" = 40' 10-23-71 FILE # DC14728

THE HARTFORD ELECTRIC LIGHT CO.
ELECTRIC OPERATIONS DEPARTMENT

DRAWN BY *JCRP* CHECKED BY *JWS* APPROVED BY *JWS*
SCALE 1" = 40' DATE 10-23-71 NO. DC14728

NO.	DATE	DESCRIPTION	BY	APP. BY



14b
10 INCHES 1 2 3 4