


RECEIVED
HARTFORD, CONN.
MAR 16 9 37 AM '72
ROBERT J. GALLIVAN
TOWN & CITY CLERK

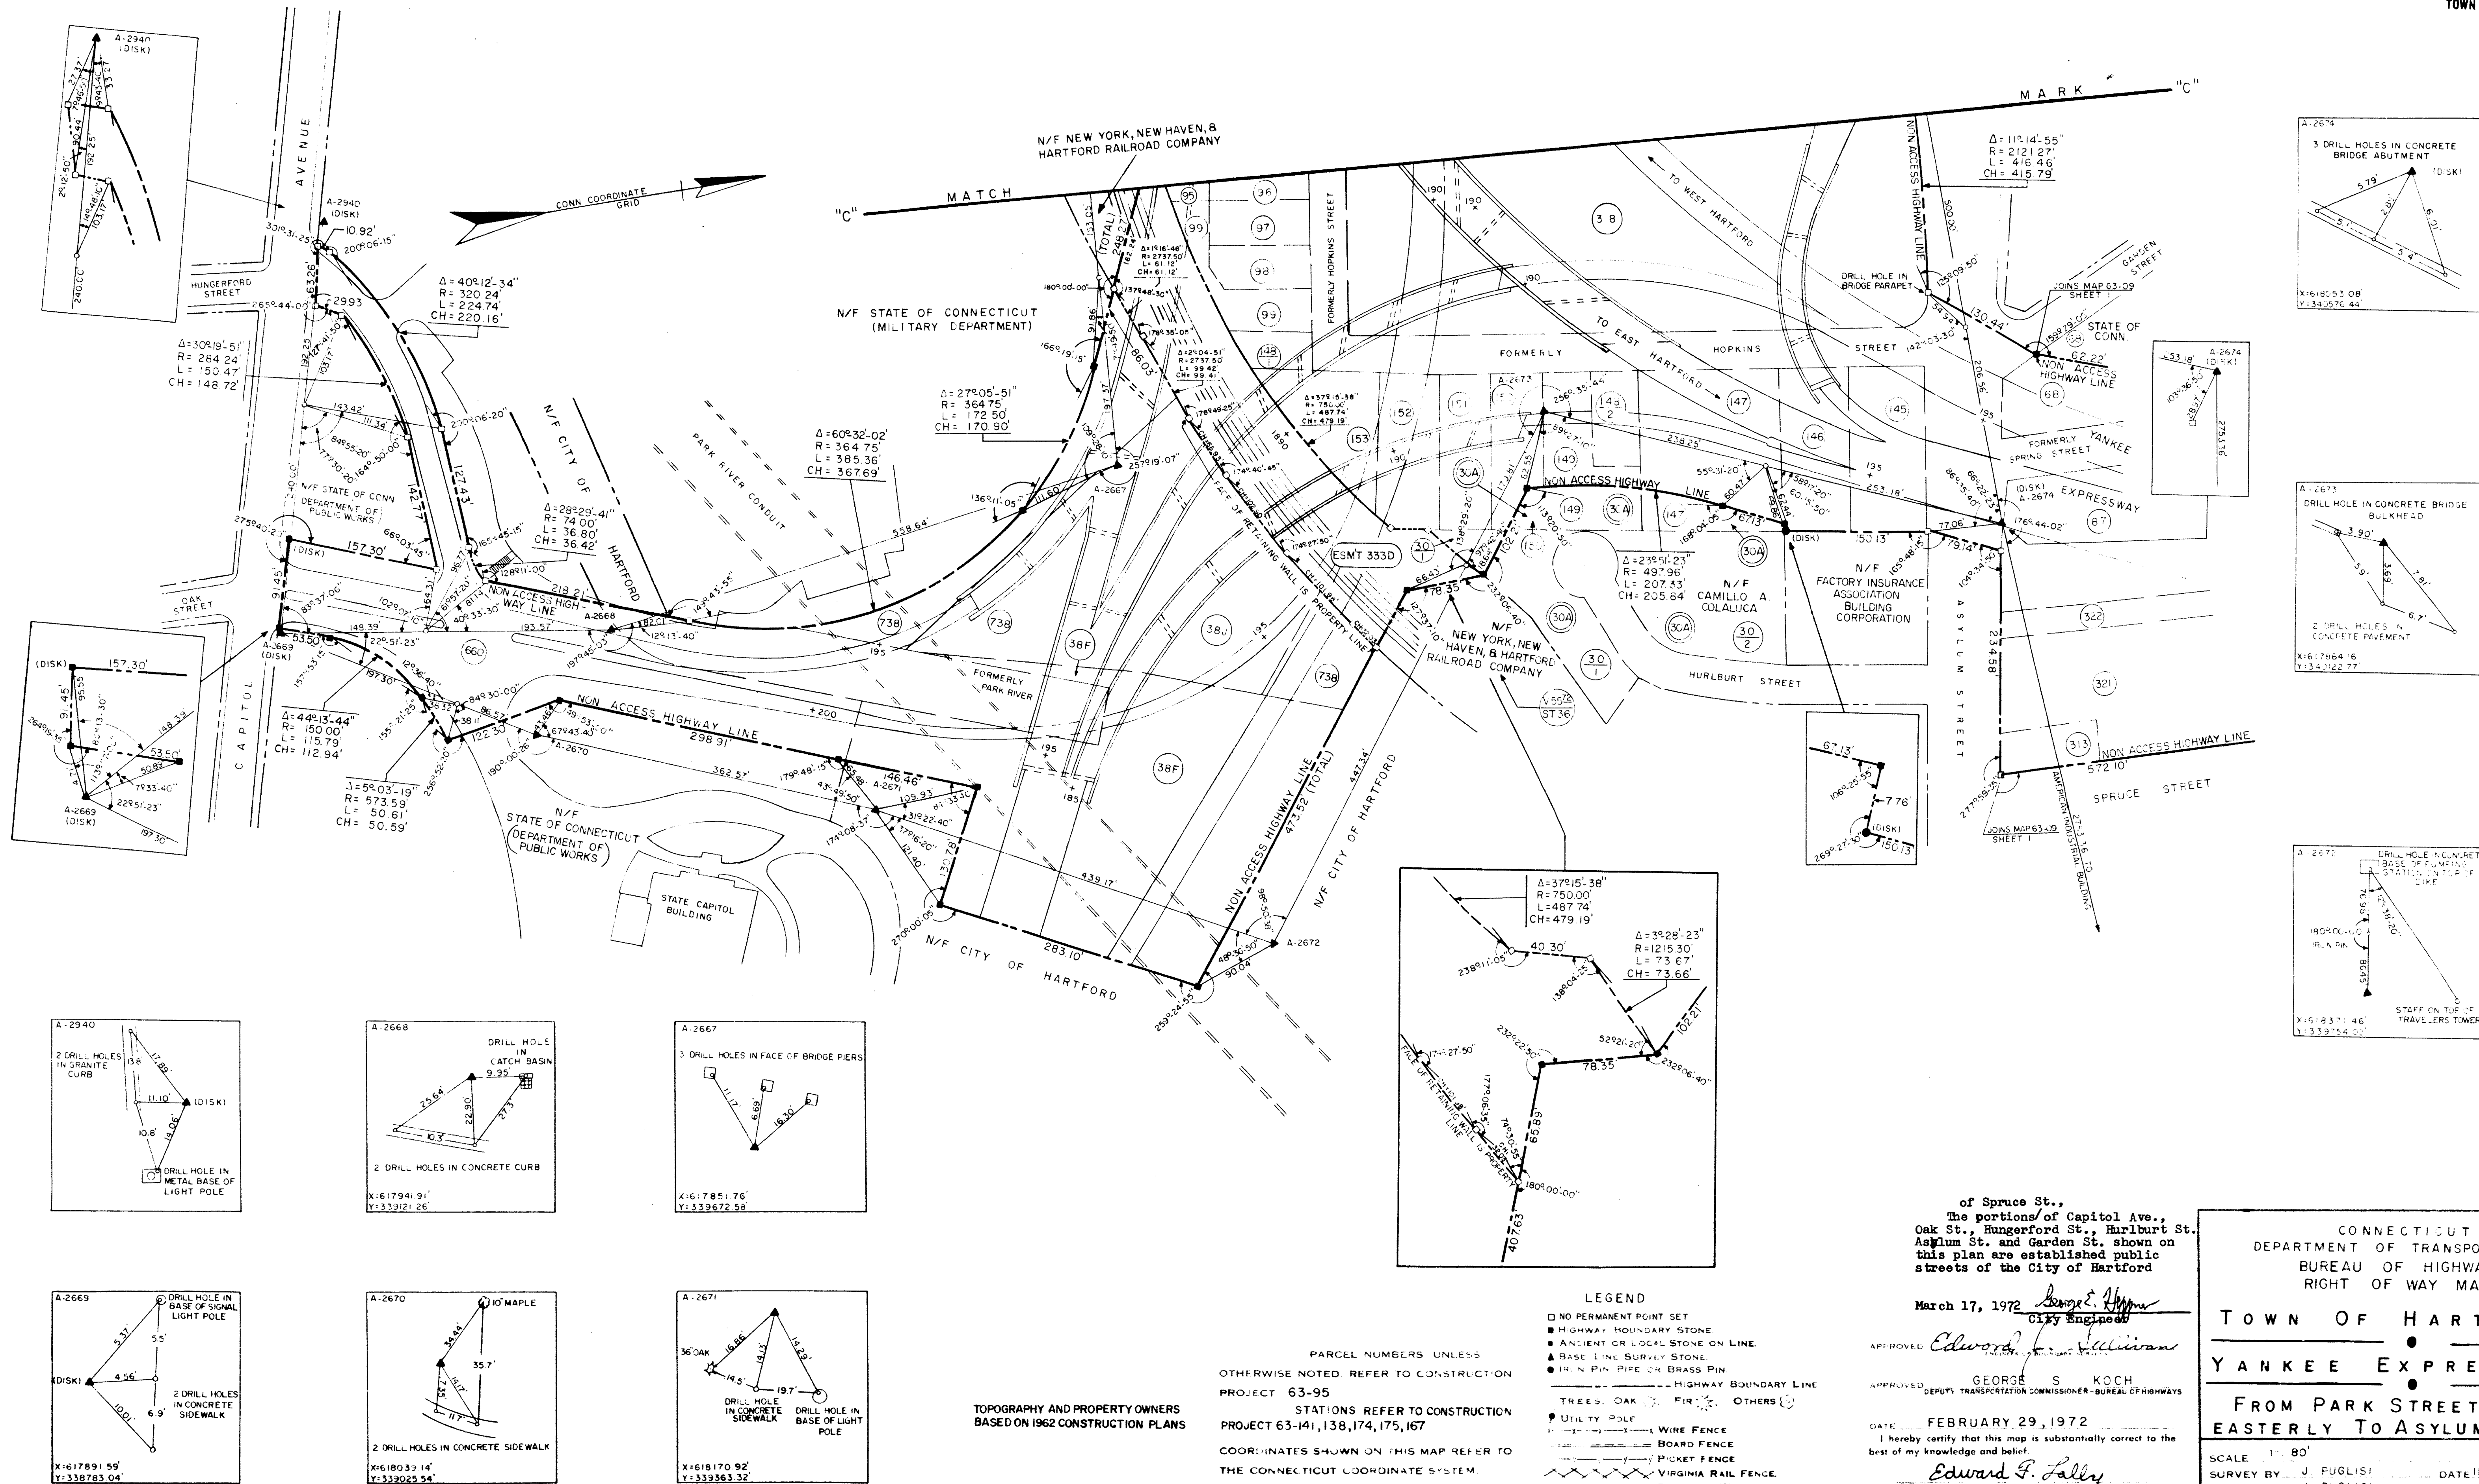

NOT FOR CONSTRUCTION