


EAST FILE CORP. IRVINE, CA

957

957-1

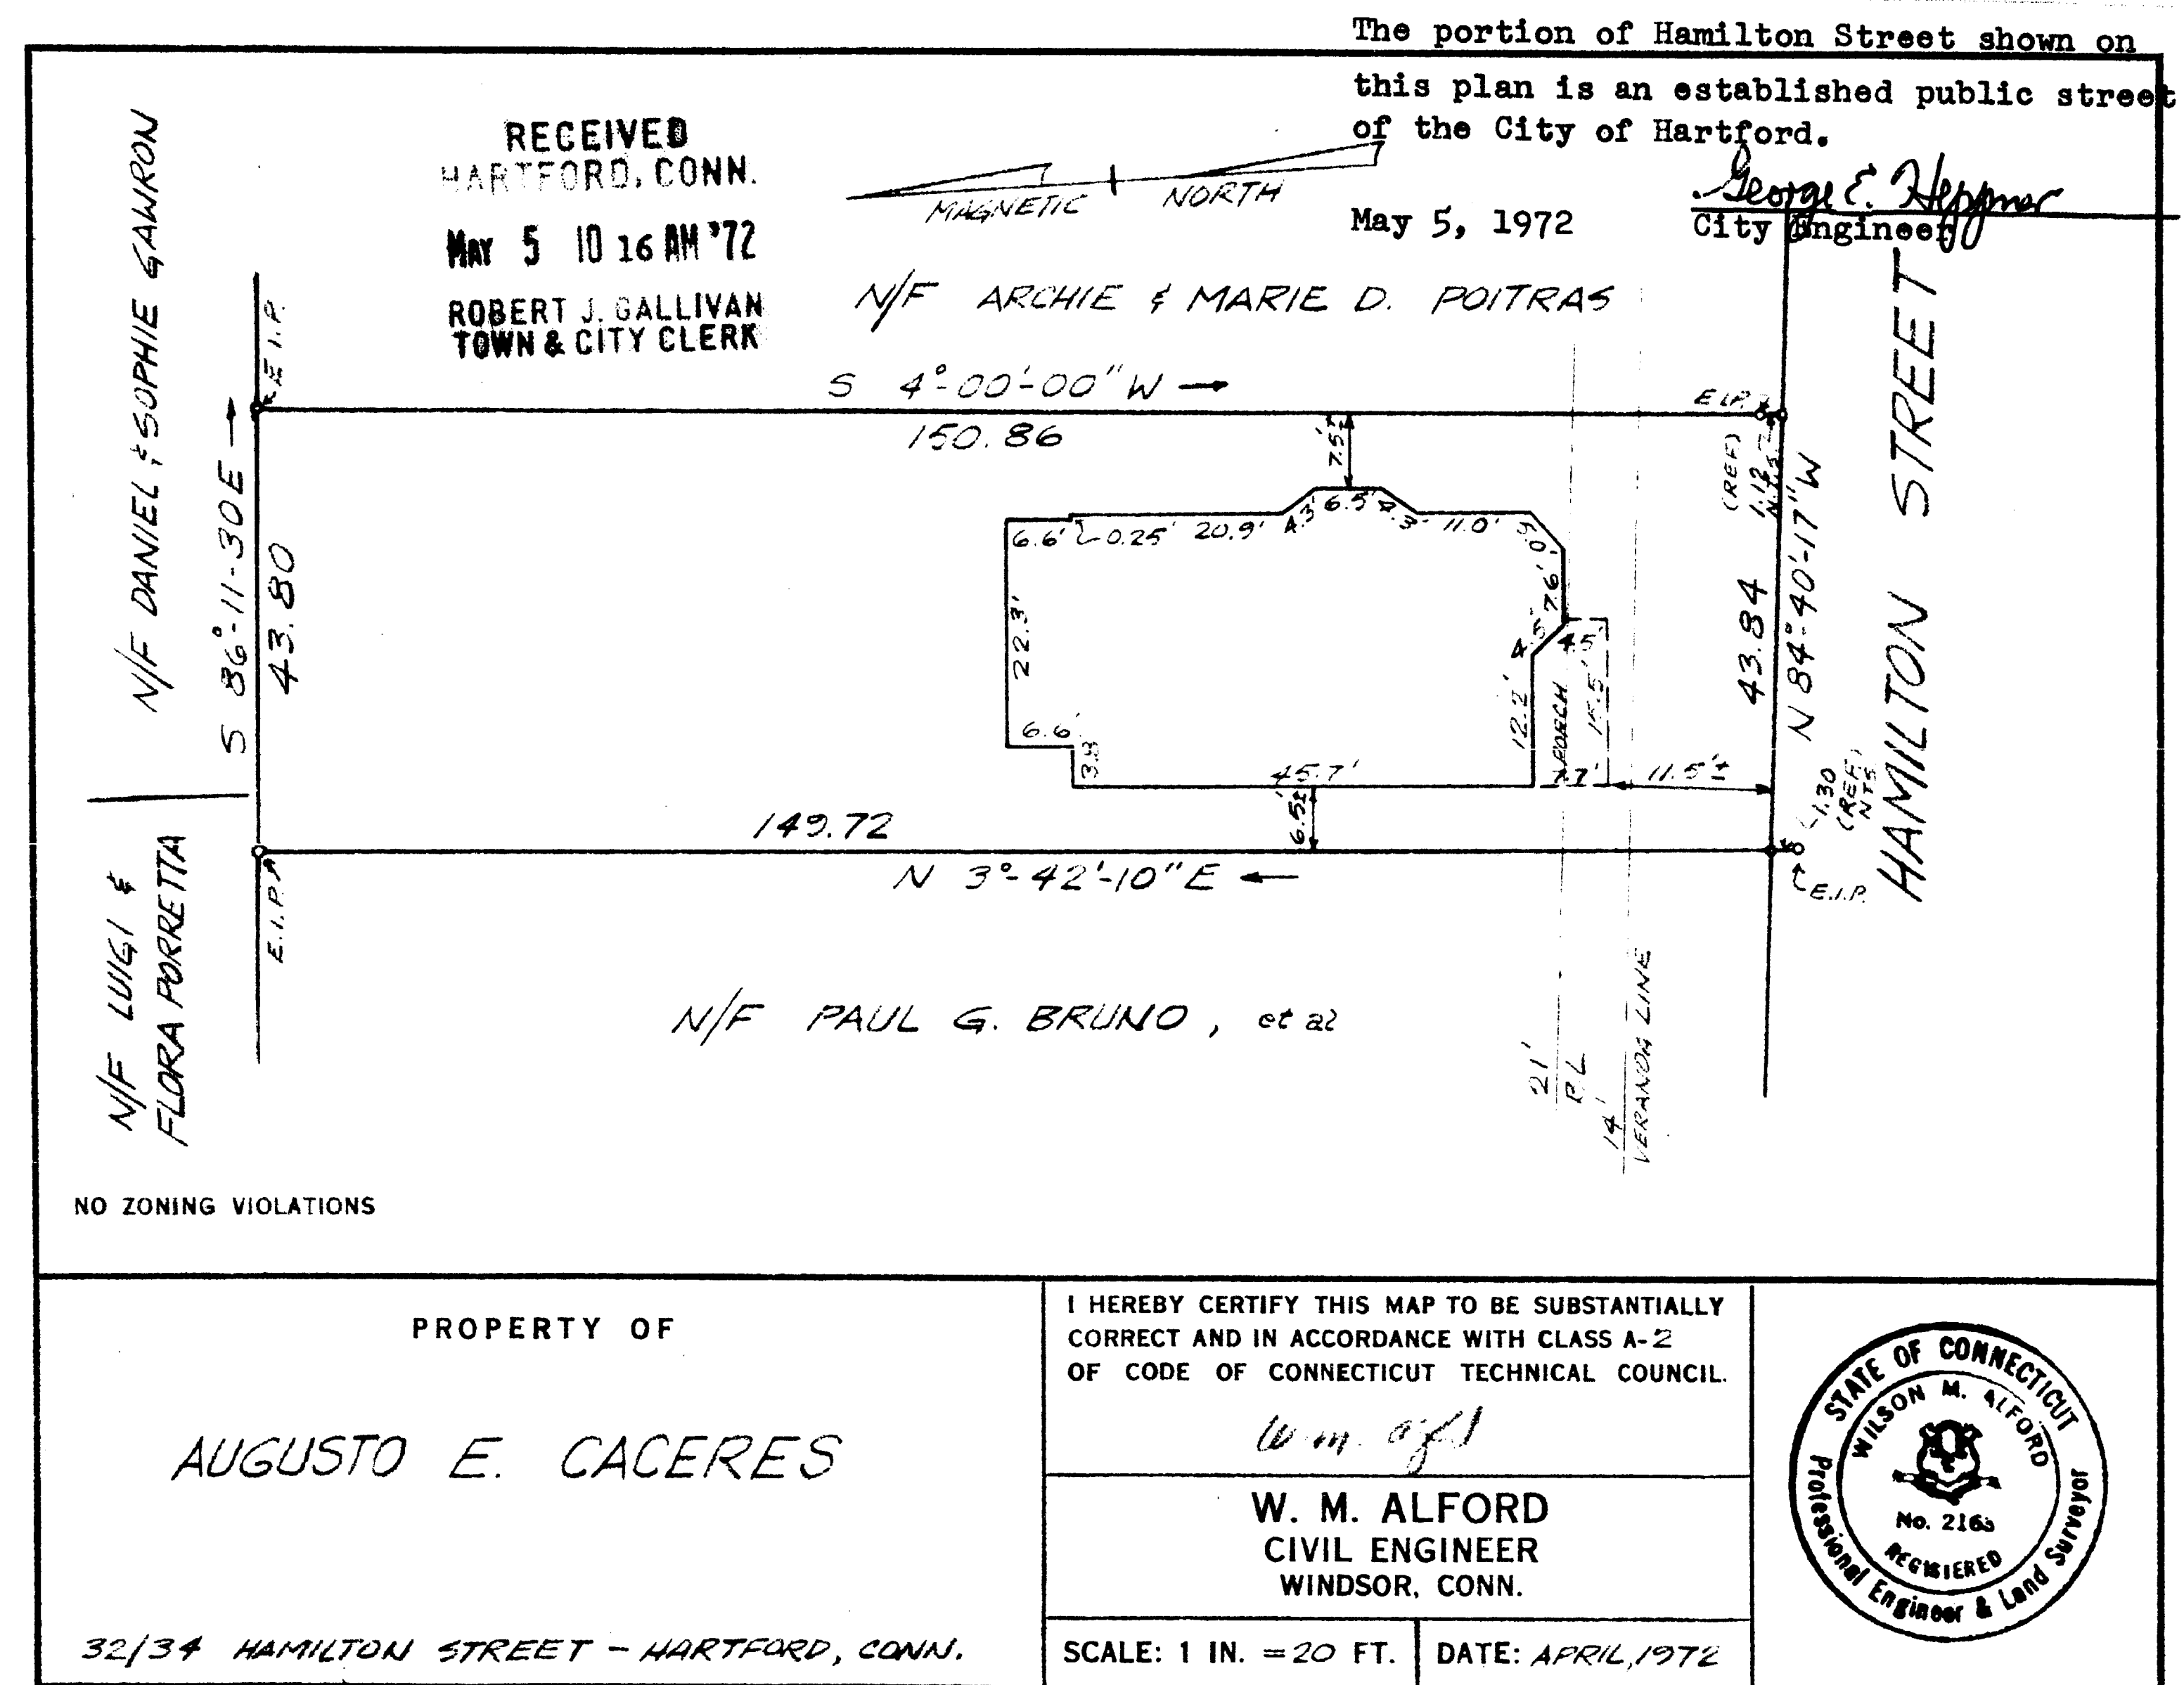

DIETZGEN 198M Ageproof Tracing Vellum 6574

