

957-2


#355144
RECEIVED
HARTFORD, CONN.
SEP 7 1 40 PM '72
ROBERT J. GALLIVAN
TOWN & CITY CLERK

PROPERTY OF
NICHOLAS & ADA GALLICCHIO
1450 ALBANY AVENUE
CONNECTICUT
AUGUST 17, 1972

The portion of Albany Ave. shown on this plan is an established public street of the City of Hartford.


Sept. 8, 1972

George E. Albright
City Engineer

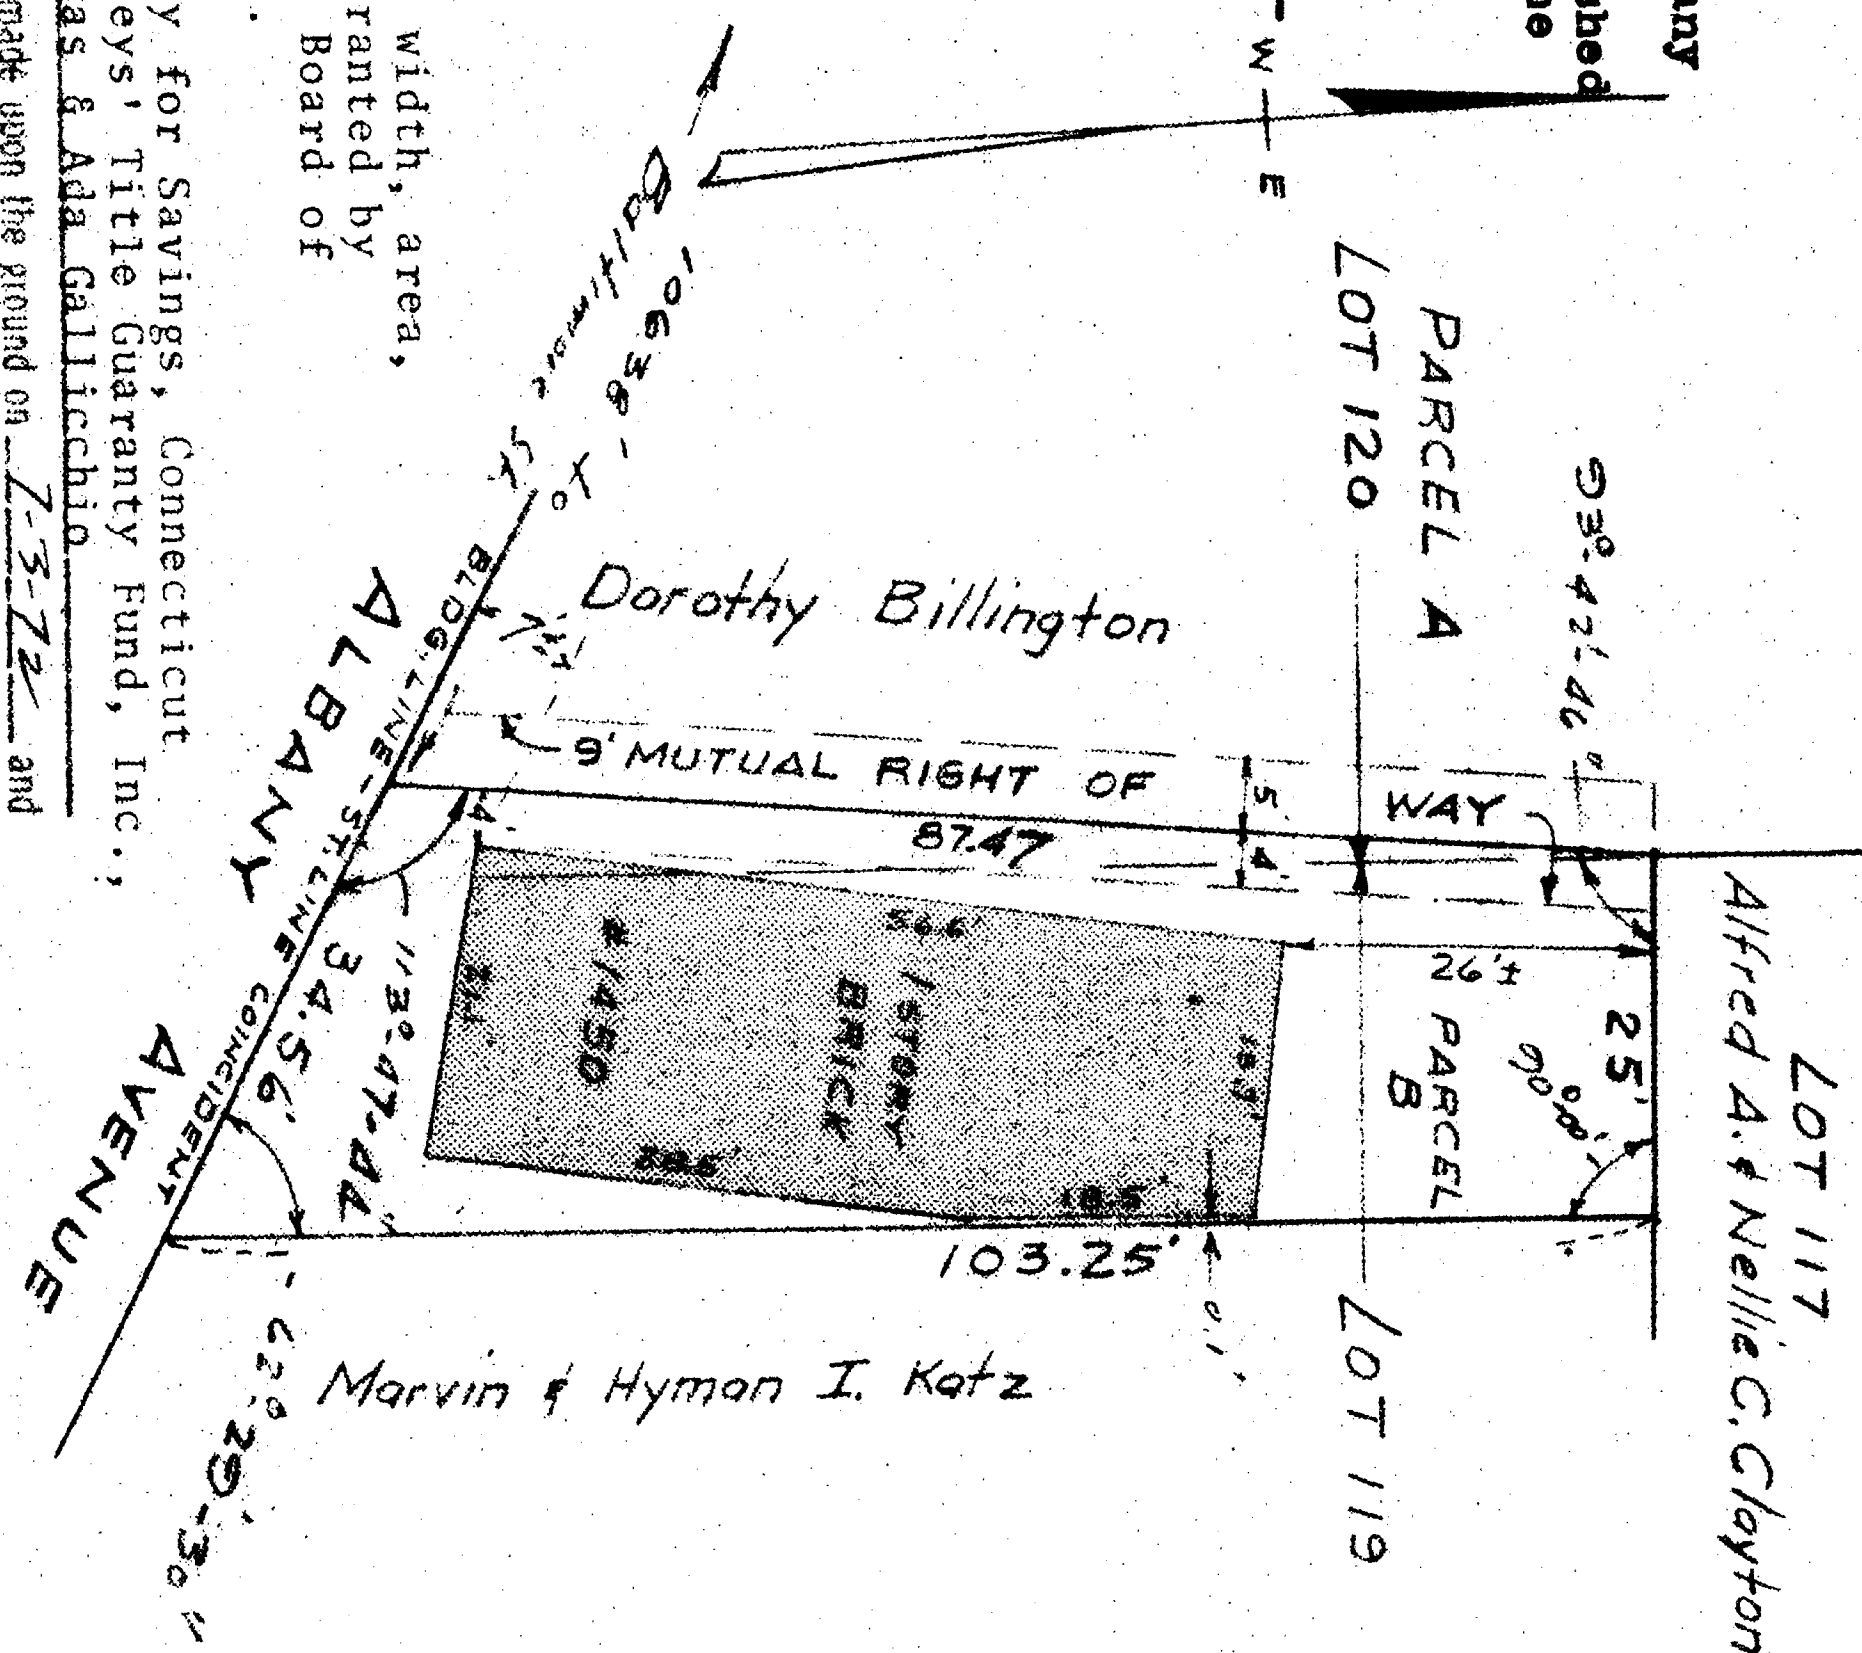


NOTE:
Variance re lot width, area,
and sideyards granted by
Hartford Zoning Board of
Appeals 7-11-72.

Society for Savings, Connecticut
Attorneys Title Guaranty Fund, Inc.,
I hereby certify that this survey was actually made upon the ground on 7-3-72 and that it and the books and measurements shown herein are correct within the standards of Class 12 of the Code of the Technical Council, Inc., and that, unless otherwise shown, dead lines and lines of actual possession are the same. Buildings are located as shown and do not encroach over or upon street, drive or building lines, there are no violations of zoning regulations with reference to the location of said buildings, and there are no easements or encroachments affecting this property apparent from a careful inspection of the same, other than those noted and depicted herein.

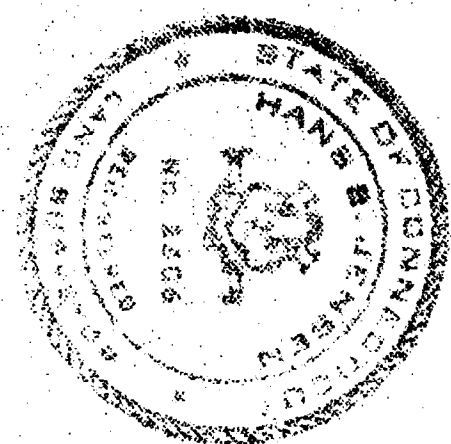


by [Signature]

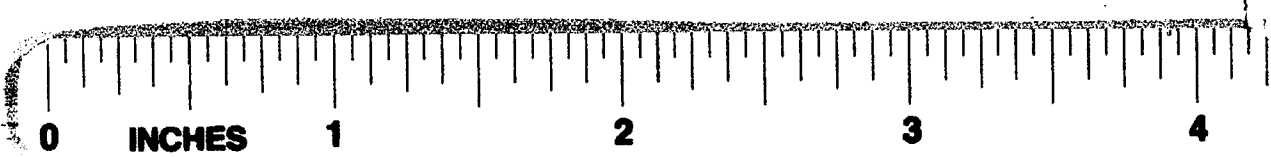

LSb
LASH FILE CORP., NEWARK, CA
SEP 34