

GPM 34

962

9 6 2 - 3

SURVEY OF LOT NO. 8

PROPERTY OF
ANGELA DICENSO
AND LOCATED AT
ORLANDO

NO. 43 ANSONIA STREET
HARTFORD, CONN.

SCALE 1" = 20'

DATE: JUNE, 1973

DATE: JUNE, 1973

N/E ANGELO & EMILIA SCALISE
I.P.

CITY OF HARTFORD

1.00	50.00	90
------	-------	----

06

LOT 17

N/F K.C. PEASE
MEAGLEY

153.66'

155.50

N/F PASQUALE & ELEANOR MAIDA
BERNARDO T. & EMILIA DONATO
LOT 26

The portion of Ansonia Street shown on this plan is an established public street of the City of Hartford.

July 16, 1973

George E. Heppner
CITY ENGINEER

ANSONIA STREET

Street line 11.92° 06'


50.03

87.54

150.10' to East Monroe Street

Building to be constructed. *None*

Building to be constructed. *None*
I hereby certify that this map is substantially correct and that the zoning ordinances of the town of *Hartford*, Conn., have not been violated.

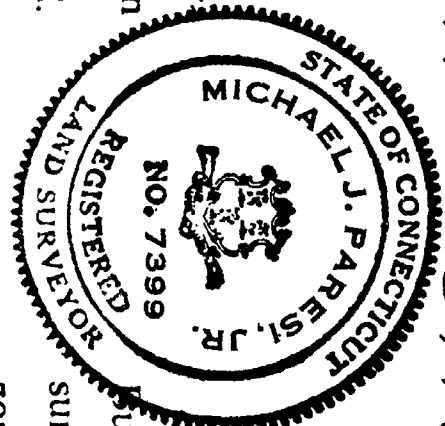

Building completed as shown in sketch and survey is hereby re-certified as correct and zoning regulations not violated.

RECEIVED
HASTINGS
JUL 16 12 14 PM '73
ROBERT J. COLEMAN
TOWN & CITY
CLERK

LIC. LAND SURVEYOR
Reg # 7399

Reg # 7399

LIC. LAND SURVEYOR

A horizontal ruler with markings from 0 to 4 inches. The markings are in inches, with major ticks every inch and minor ticks every millimeter. The word "INCHES" is printed below the ruler.