


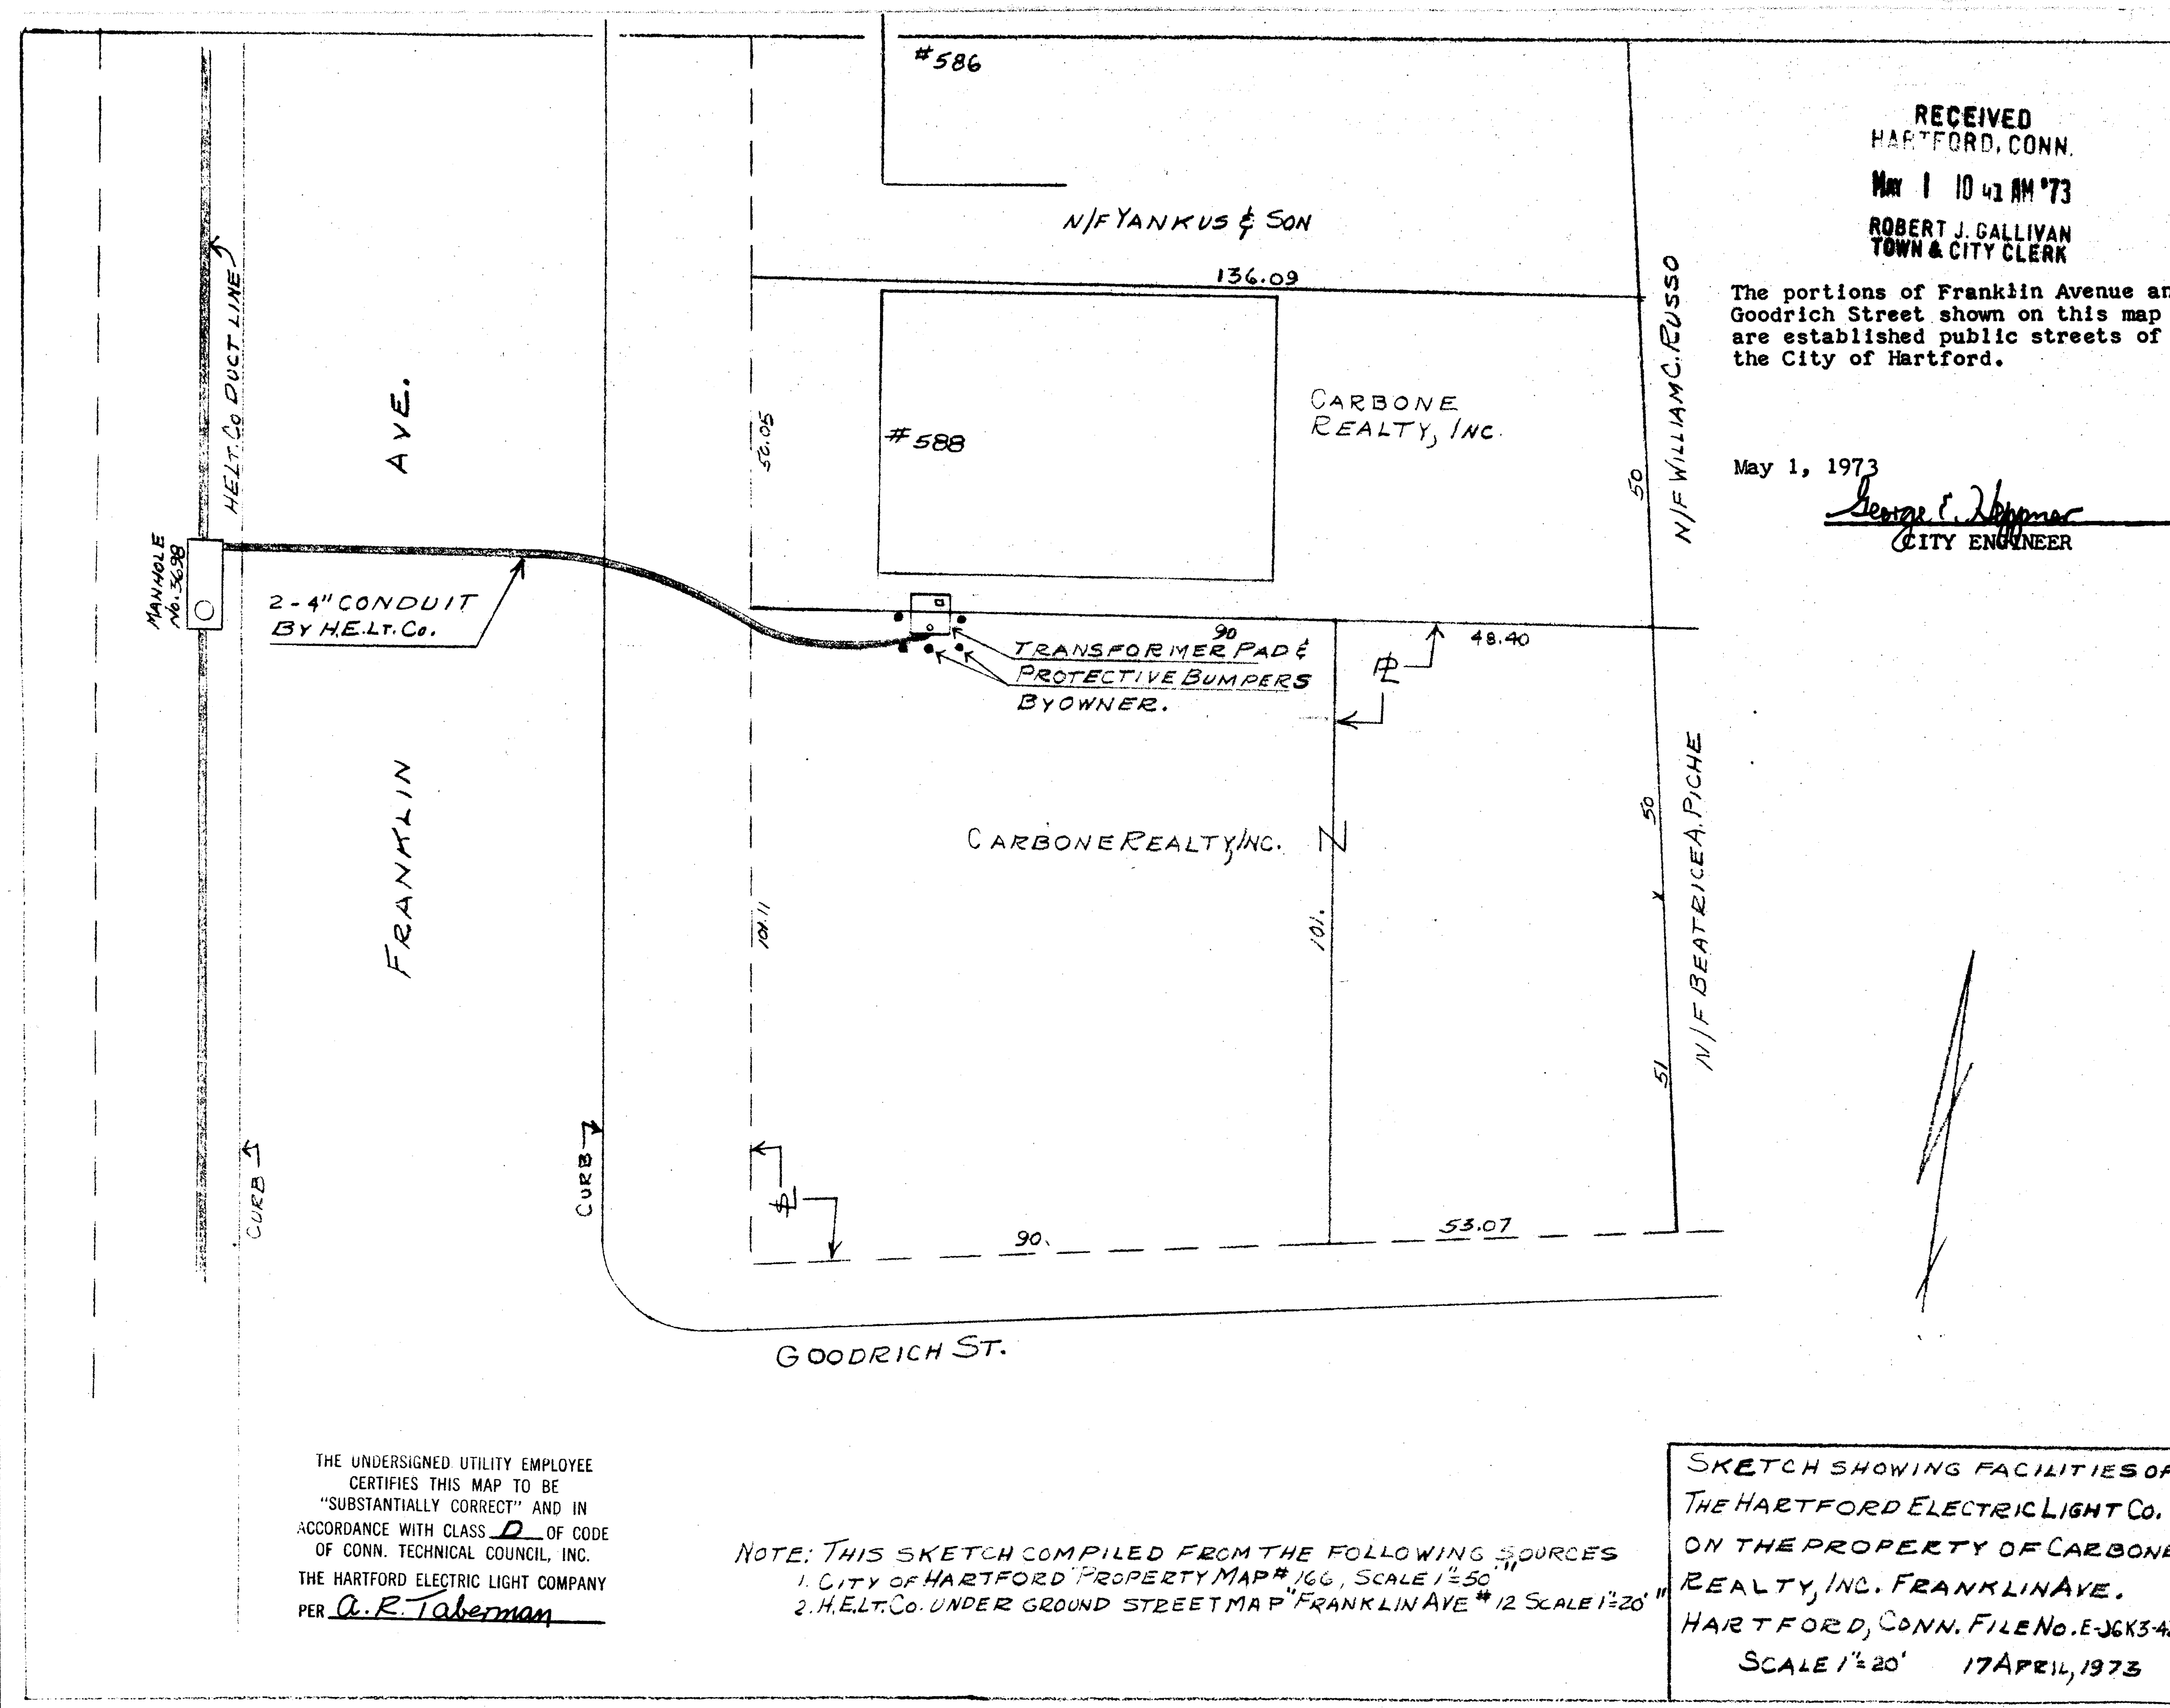

RECEIVED  
 HARTFORD, CONN.  
 MAY 1 10 41 AM '73  
 ROBERT J. GALLIVAN  
 TOWN & CITY CLERK

The portions of Franklin Avenue and  
 Goodrich Street shown on this map  
 are established public streets of  
 the City of Hartford.

May 1, 1973

*George E. Taberman*  
 CITY ENGINEER

THE UNDERSIGNED UTILITY EMPLOYEE  
 CERTIFIES THIS MAP TO BE  
 "SUBSTANTIALLY CORRECT" AND IN  
 ACCORDANCE WITH CLASS D OF CODE  
 OF CONN. TECHNICAL COUNCIL, INC.  
 THE HARTFORD ELECTRIC LIGHT COMPANY  
 PER A. R. Taberman

NOTE: THIS SKETCH COMPILED FROM THE FOLLOWING SOURCES  
 1. CITY OF HARTFORD PROPERTY MAP #166, SCALE 1"=50'  
 2. H.E.L.T. CO. UNDER GROUND STREET MAP "FRANKLIN AVE" #12 SCALE 1"=20'

SKETCH SHOWING FACILITIES OF  
 THE HARTFORD ELECTRIC LIGHT CO.  
 ON THE PROPERTY OF CARBONE  
 REALTY, INC. FRANKLIN AVE.  
 HARTFORD, CONN. FILE NO. E-36K3-42  
 SCALE 1"=20' 17 APRIL, 1973

