
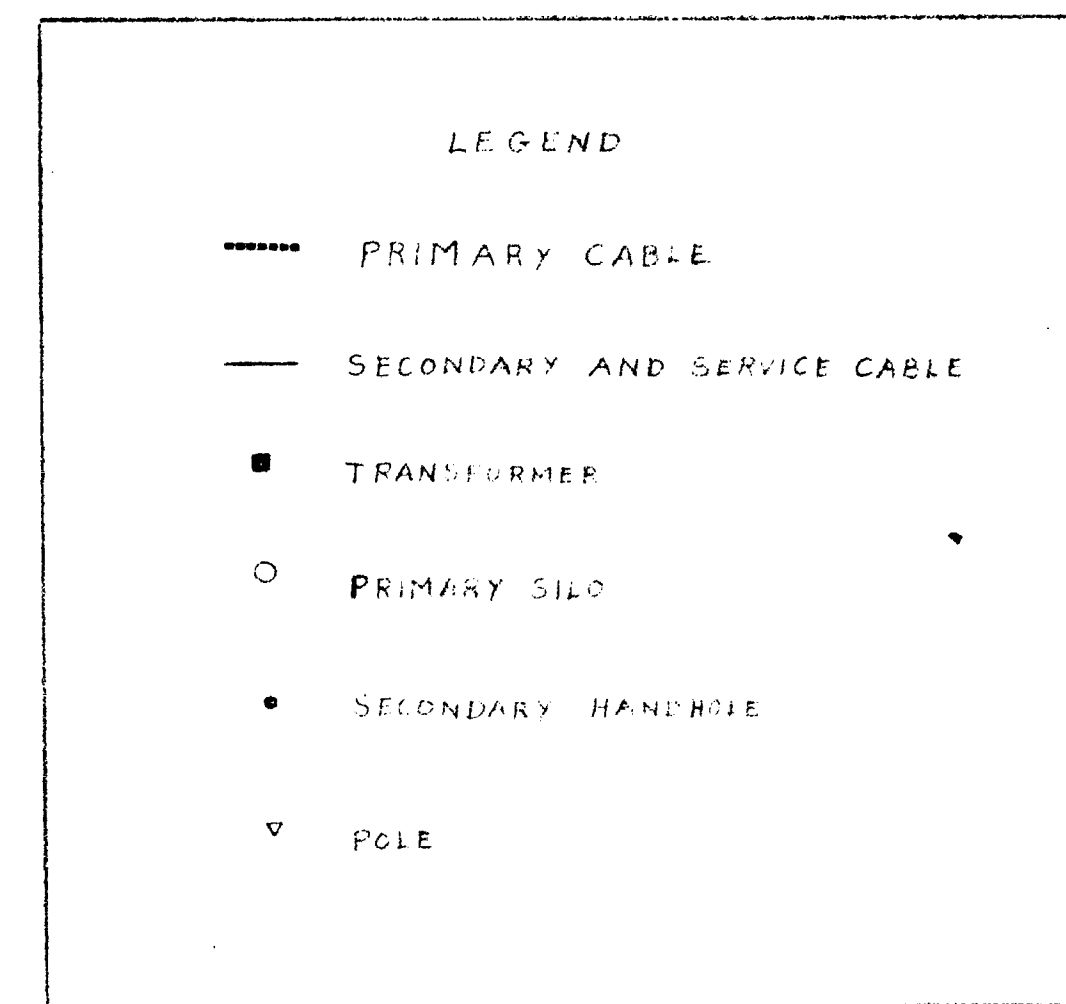


The portions of Cleveland Avenue, Garden, Barbour, Charlotte, Waverly, "A", "B" and "C" Streets are established public streets of the City of Hartford.

June 26, 1973

George E. Higgins
City Engineer

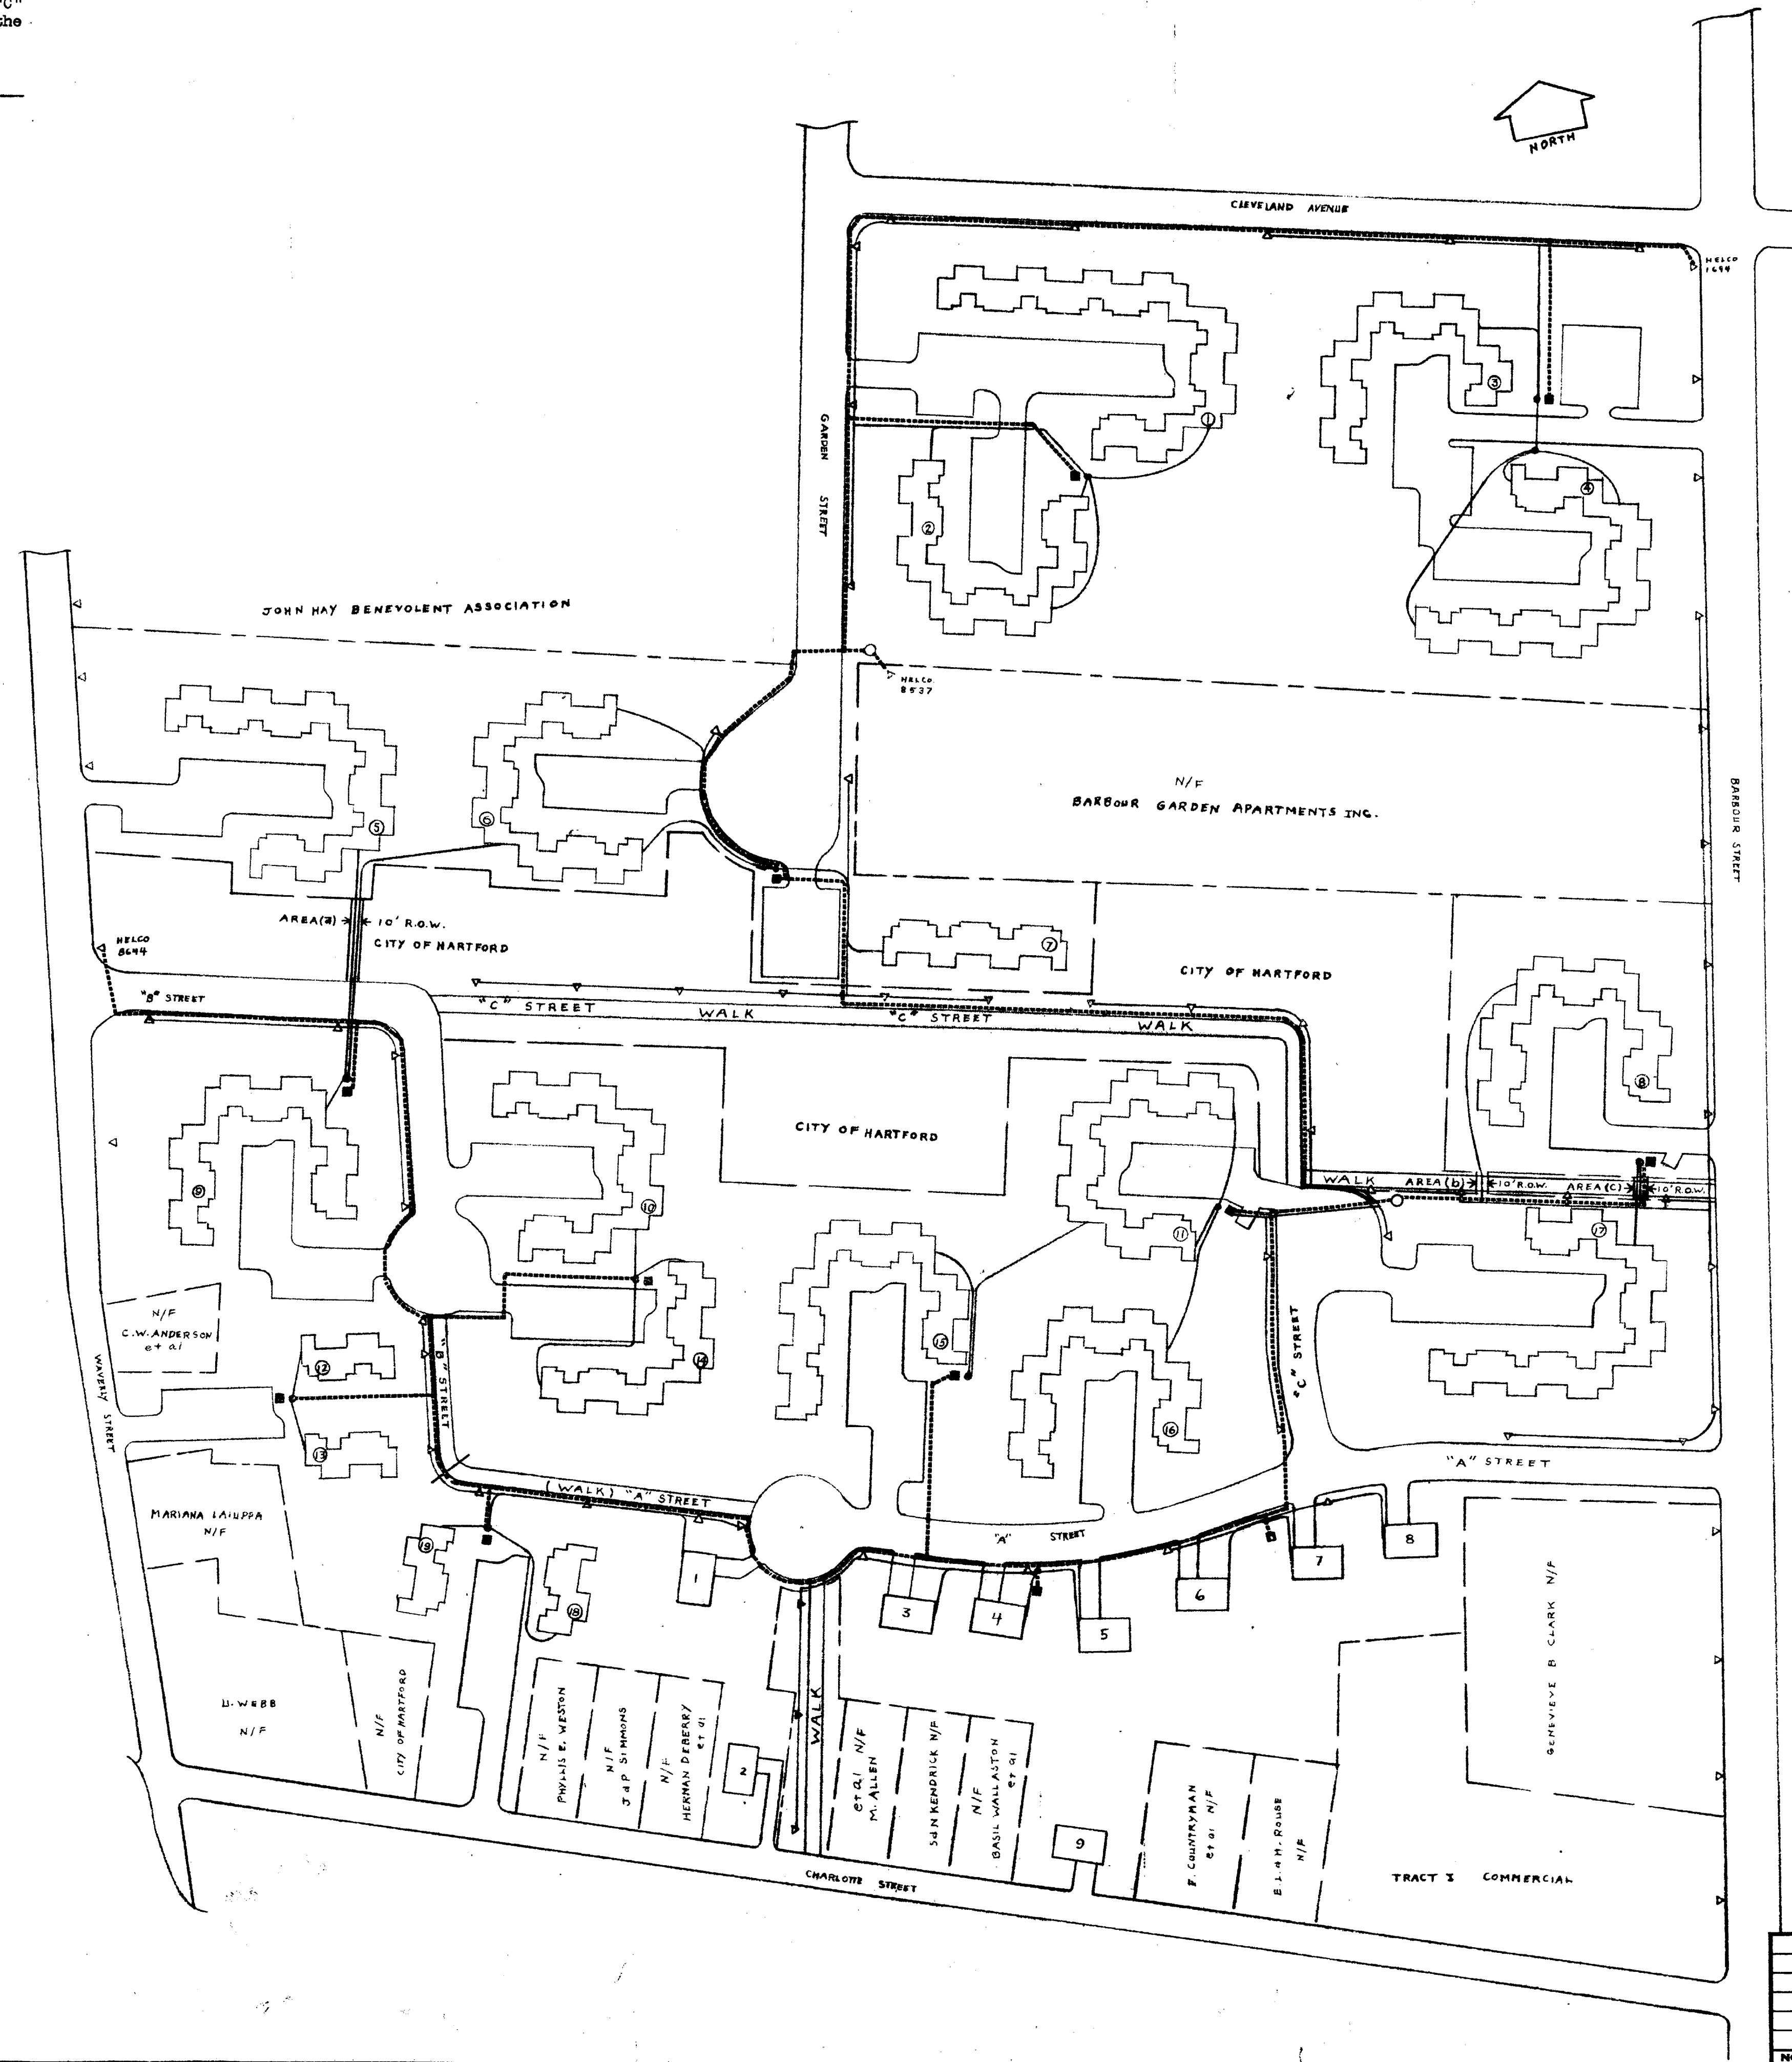

NOTE: THIS SKETCH COMPILED FROM MAPS ENTITLED:
BARBOUR-CHARLOTTE-GARDEN-WAVERLY
REDEVELOPMENT PROJECT, HARTFORD, CONN.
DRAWING NO. L-3 AND L-4 DATED 3-27-72
DRAWING NO. L-5 AND L-5A DATED 3-27-72

RECEIVED
JUN 26 9 56 AM '73
ROBERT J. ALLAN
TOWN & CITY CLERK

SKETCH SHOWING DISTRIBUTION ELECTRIC
FACILITIES OF THE HARTFORD ELECTRIC
LIGHT CO. ON THE PROPERTY OF THE
B.C. DEVELOPMENT CORP., INC. AND THE
CITY OF HARTFORD, HARTFORD, CONN.

DRAWN BY *D.E.P.* CHECKED BY *J.W.R.* APPROVED BY *X*
SCALE 1"=80'
DATE 6-12-73 NO. E75K326

NO.	DATE	DESCRIPTION	BY	APP. BY

968
EAS FILE CORP. JUNE 26
JUN 26

