


The portions of Cleveland Avenue, Garden, Barbours, Charlotte, Waverly, "A", "B" and "C" Streets are established public streets of the City of Hartford.

June 26, 1973

George J. Hopper
City Engineer

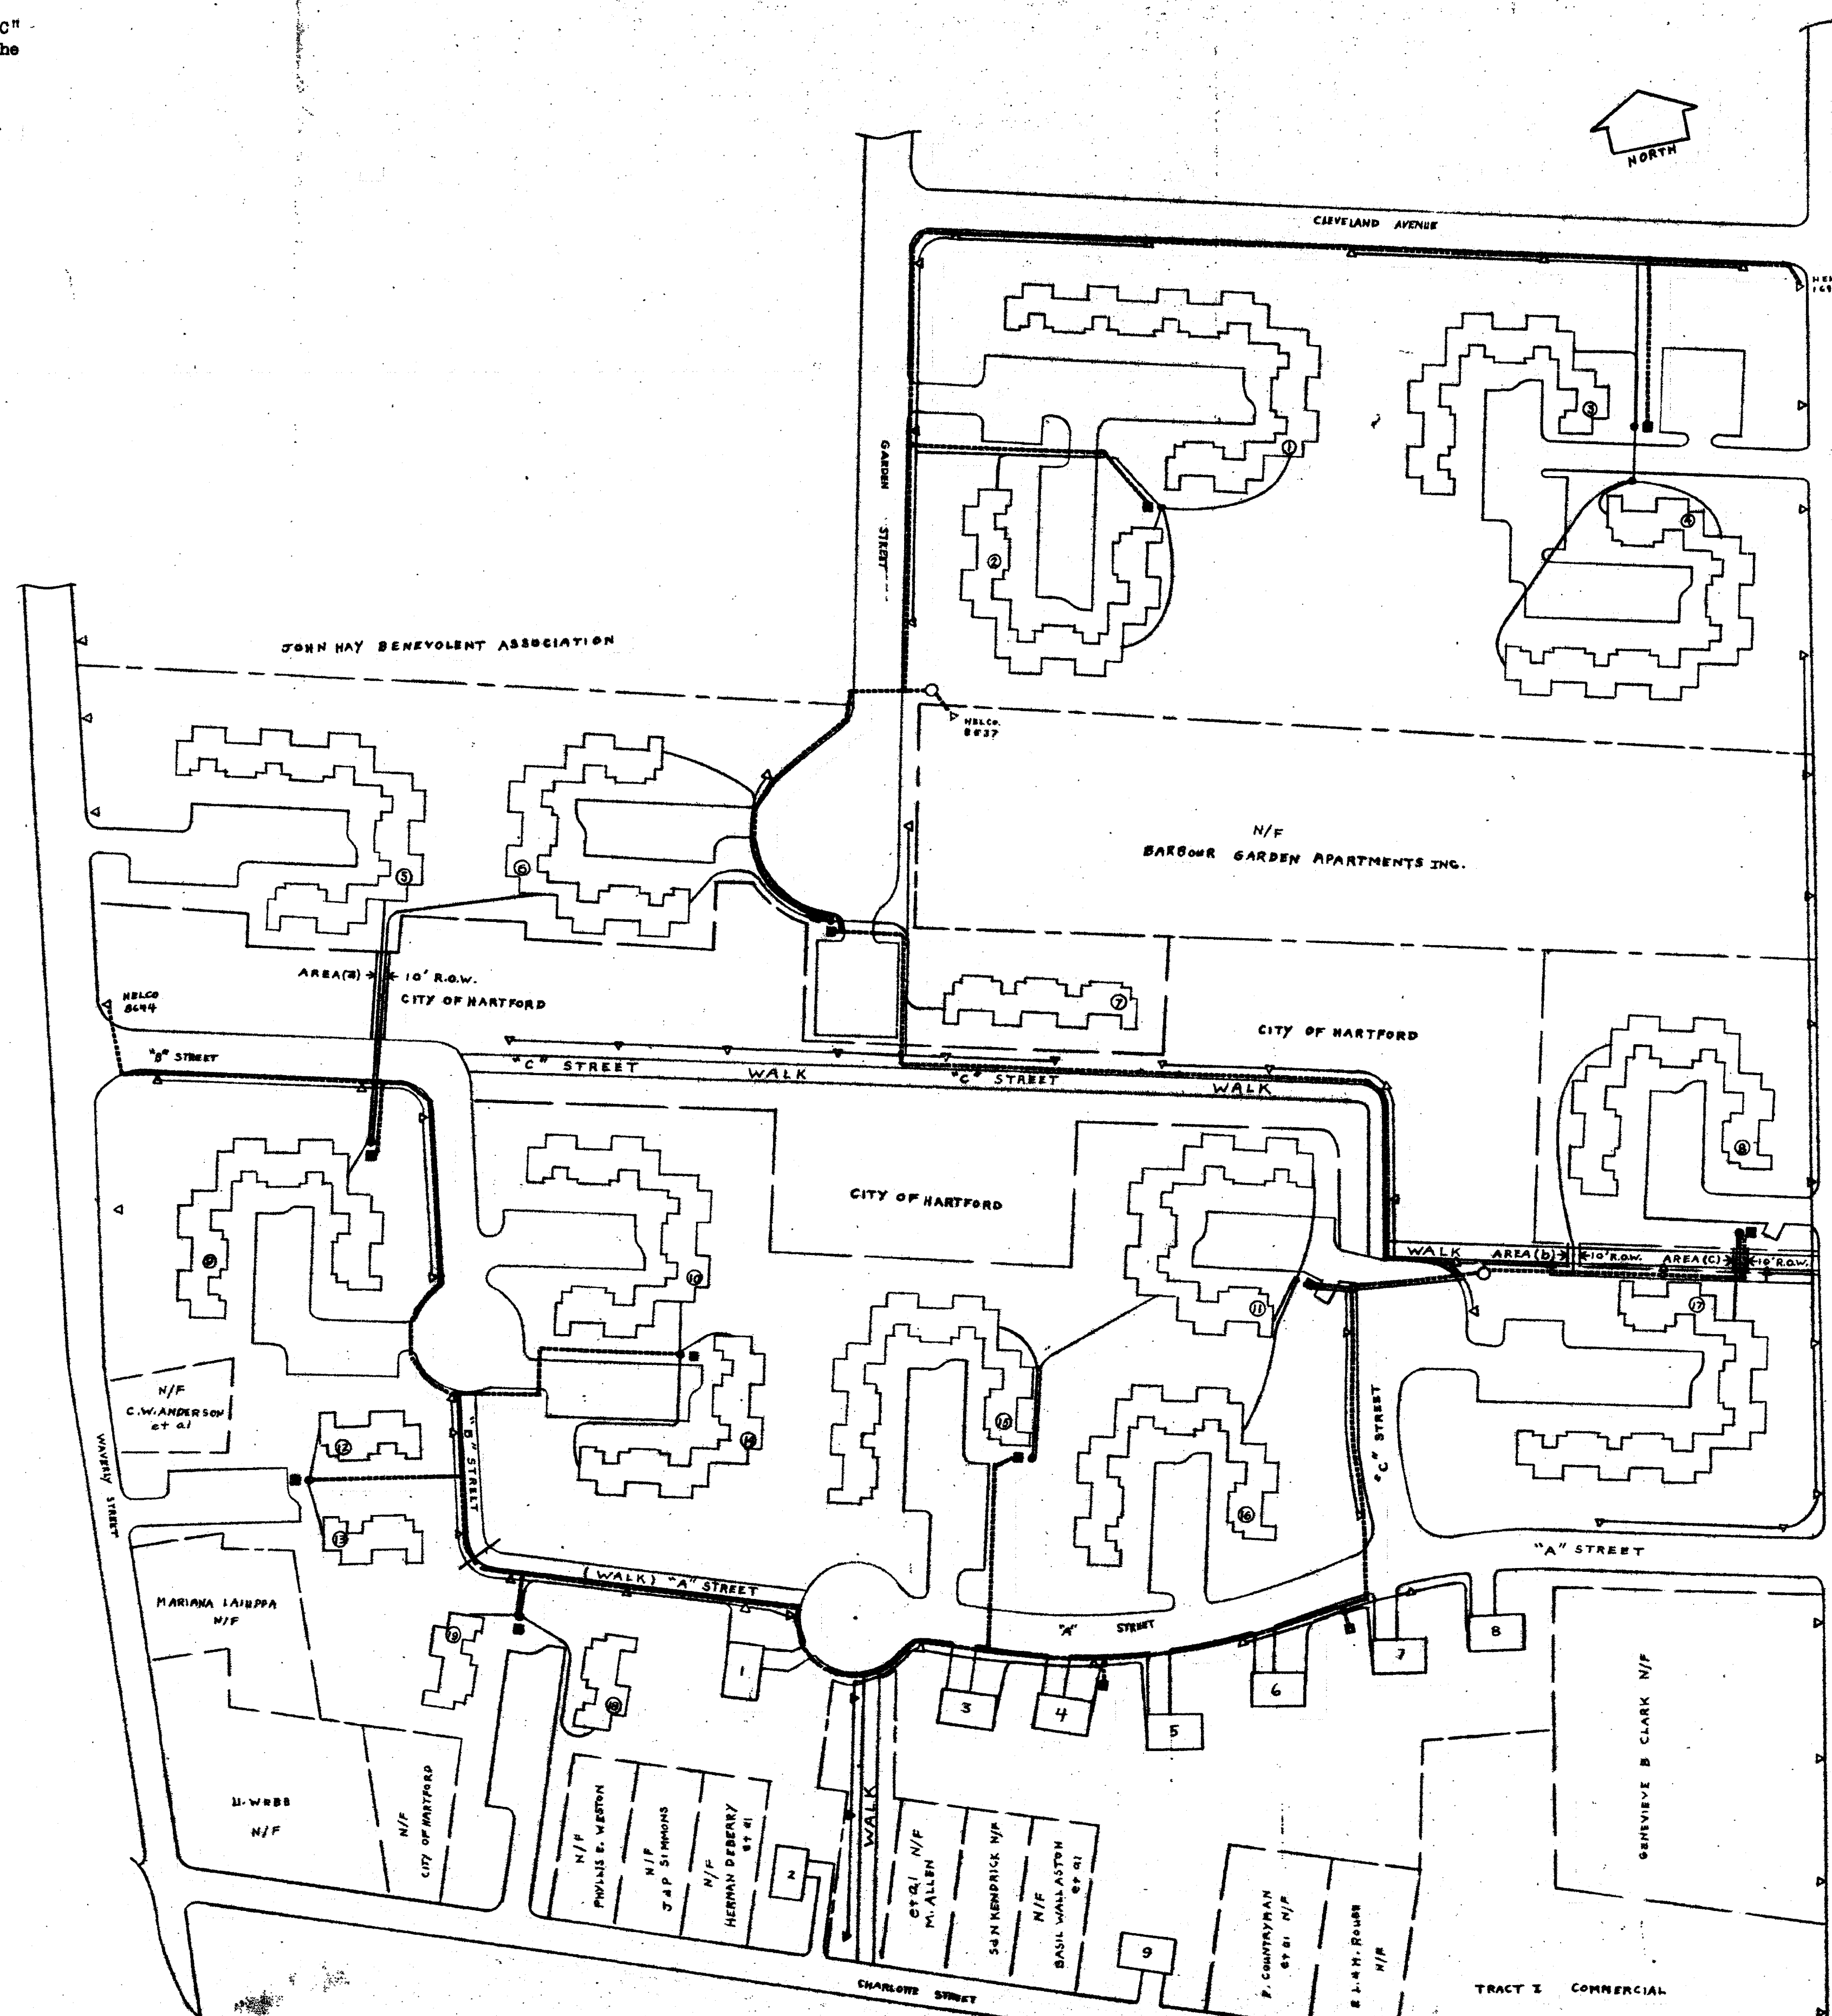

LEGEND

- PRIMARY CABLE
- SECONDARY AND SERVICE CABLE
- TRANSFORMER
- PRIMARY SILO
- SECONDARY HANDHOLE
- ▽ POLE

NOTE: THIS SKETCH COMPILED FROM MAPS ENTITLED:
BARBOUR - CHARLOTTE - GARDEN - WAVERLY
REDEVELOPMENT PROJECT, HARTFORD, CONN.
DRAWING NO. L-3 AND L-4 DATED 3-27-72
DRAWING NO. L-5 AND L-5A DATED 3-27-72

THE UNDERSIGNED HEREBY CERTIFIES THAT THIS SKETCH IS A TRUE AND CORRECT REPRESENTATION OF THE FACILITIES SHOWN THEREON.
FOR THE HARTFORD ELECTRIC LIGHT COMPANY
PER *Donald F. Polansky*

RECEIVED
HARTFORD, CONN.
JUN 26 9 57 AM '73
ROBERT J. SULLIVAN
TOWN & CITY CLERK

SKETCH SHOWING DISTRIBUTION ELECTRIC FACILITIES OF THE HARTFORD ELECTRIC LIGHT CO. ON THE PROPERTY OF THE B.C. DEVELOPMENT CORP., INC. AND THE CITY OF HARTFORD, HARTFORD, CONN.

DRAWN BY *D.F.P.* CHECKED BY *M.R.A.* APPROVED BY *J.C.*
SCALE 1" = 80'
DATE 6-12-73 NO. E75K226

NO.	DATE	DESCRIPTION	BY	APP. BY

469