


The portions of Ledyard Street and Locust Street shown on this plan are established public streets of the City of Hartford.

November 20, 1973

George C. Thompson
City Engineer

RECEIVED
HARTFORD, CONN.
Nov 20 10 34 AM '73
ROBERT J. GALLIVAN
TOWN & CITY CLERK

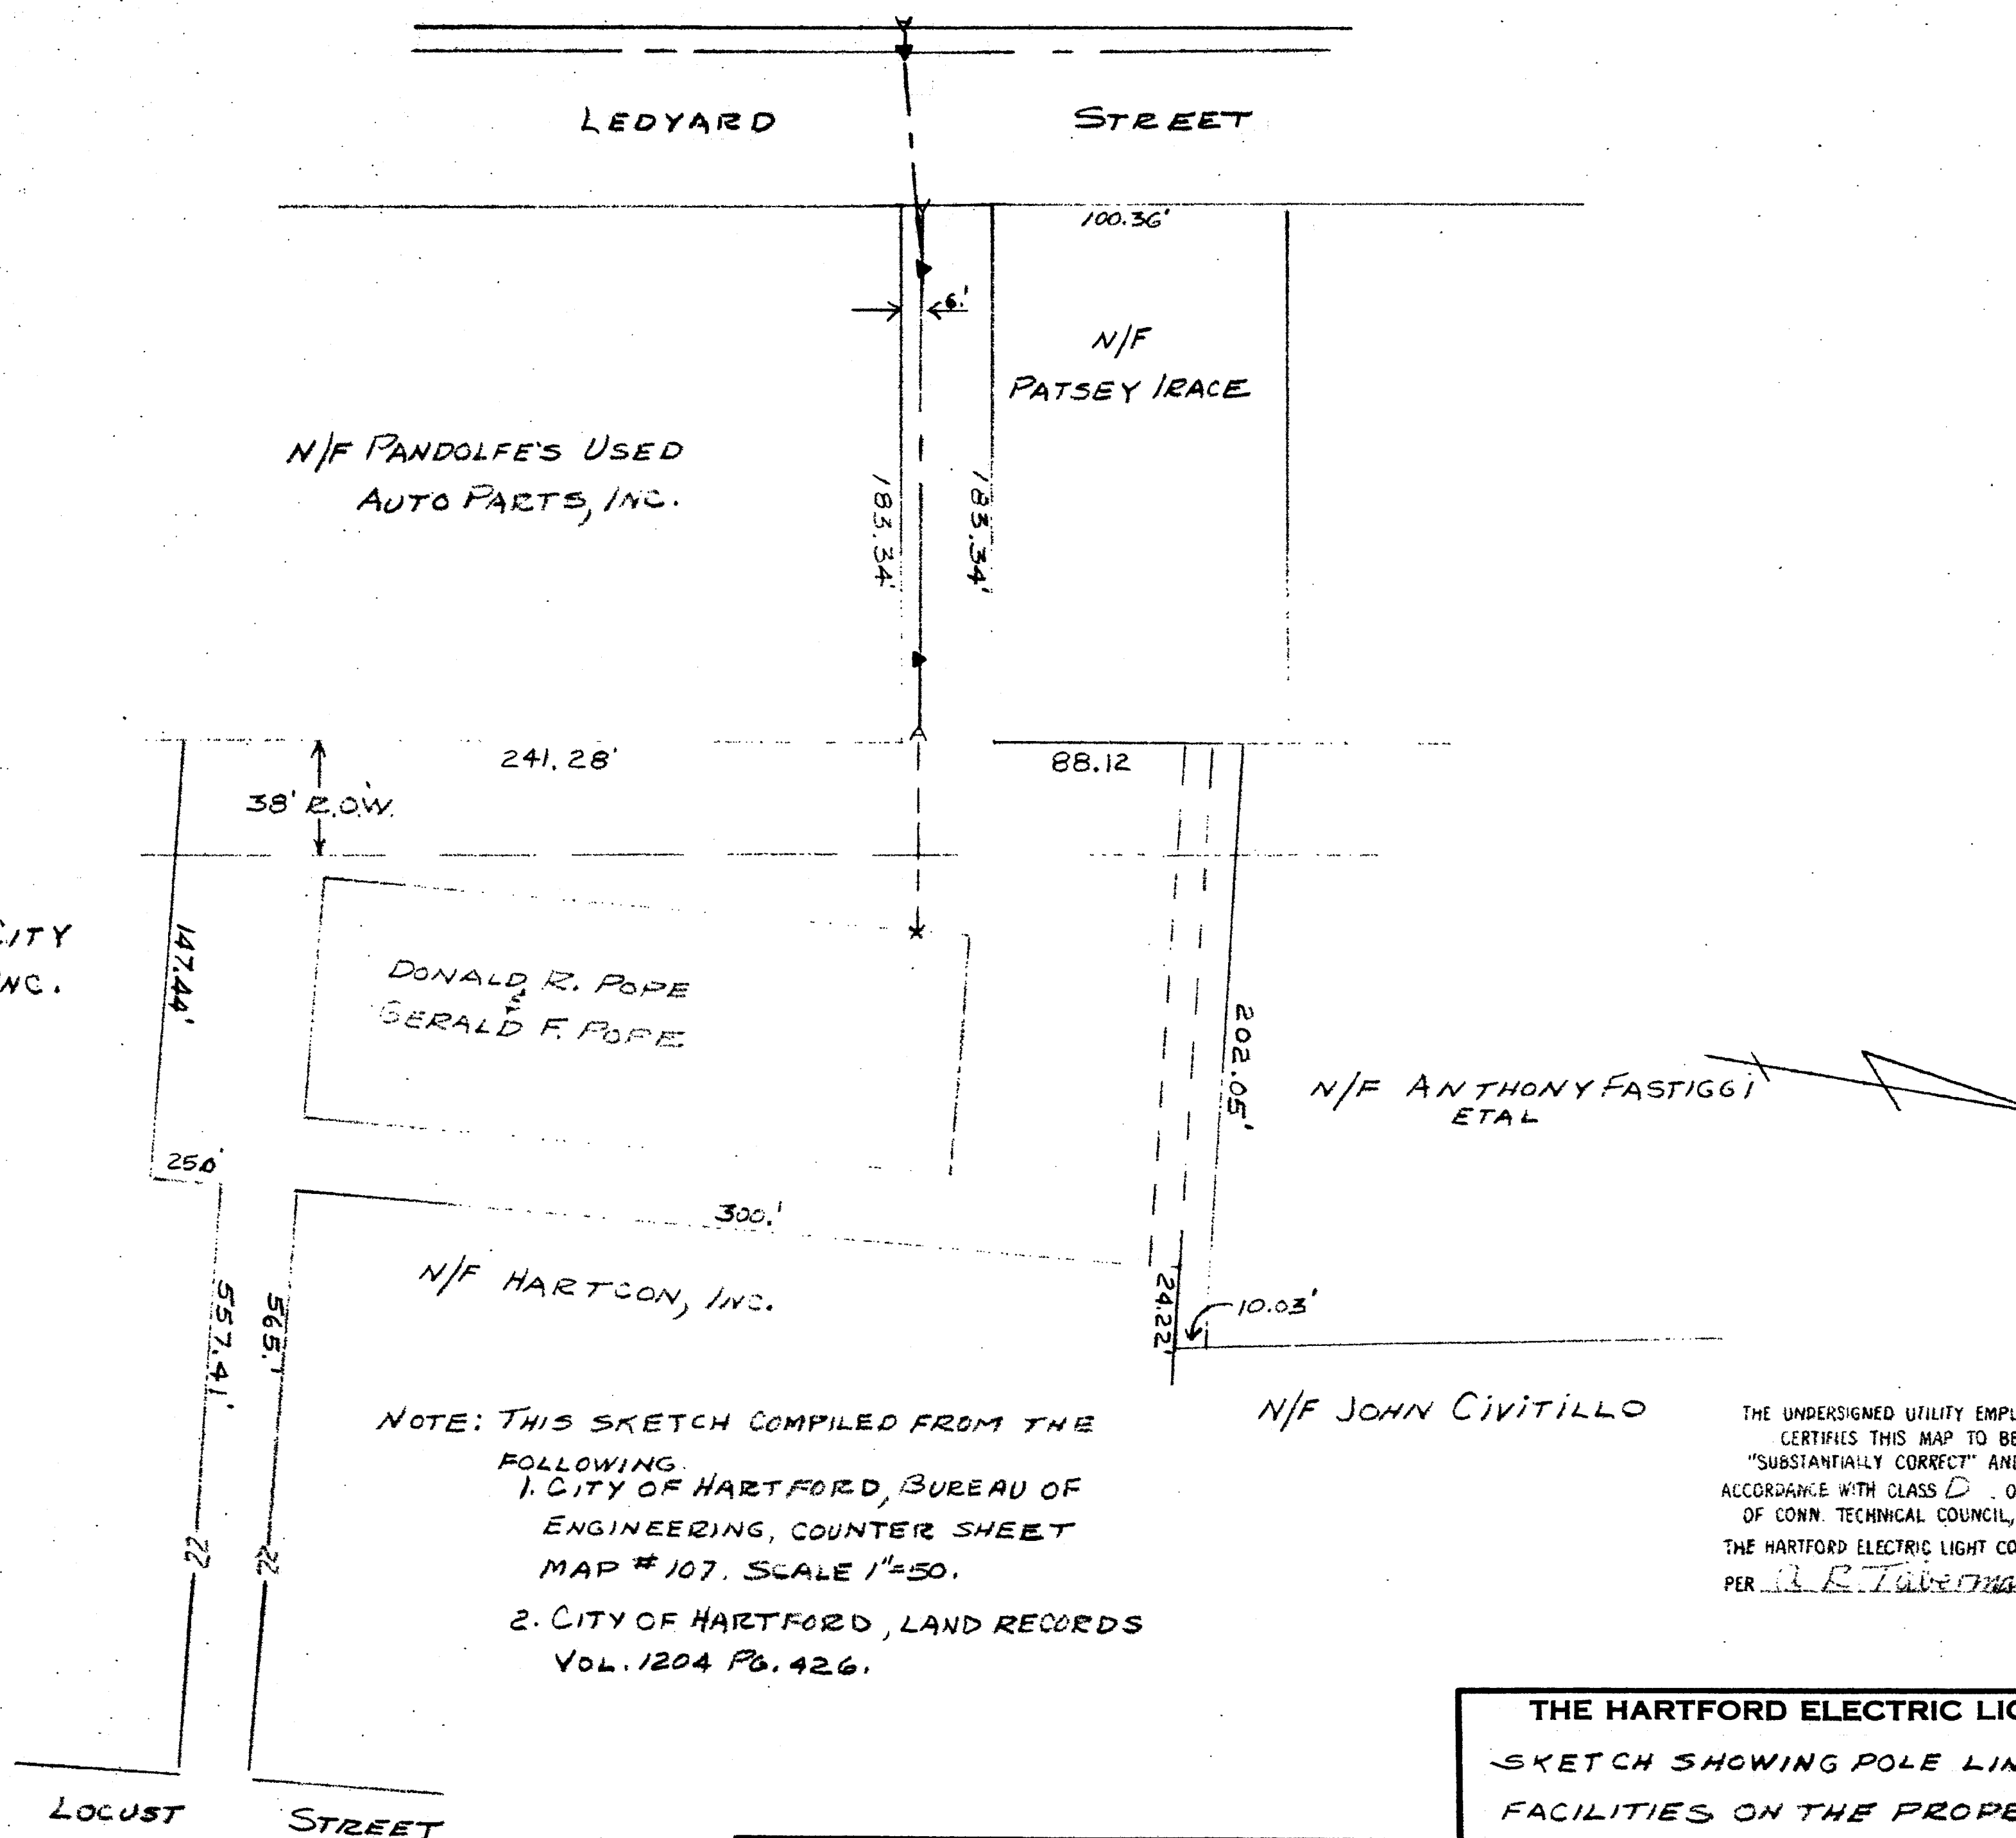

LEGEND:
▲ POLE LOCATION
—▲ ANCHOR GUY
— CENTER LINE OF POLE LINE
--- SERVICE CONDUCTORS

NOTE: THIS SKETCH COMPILED FROM THE FOLLOWING:
1. CITY OF HARTFORD, BUREAU OF ENGINEERING, COUNTER SHEET MAP # 107, SCALE 1"=50.
2. CITY OF HARTFORD, LAND RECORDS VOL. 1204 PG. 426.

THE UNDERSIGNED UTILITY EMPLOYEE CERTIFIES THIS MAP TO BE "SUBSTANTIALLY CORRECT" AND IN ACCORDANCE WITH CLASS D OF CODE OF CONN. TECHNICAL COUNCIL, INC. THE HARTFORD ELECTRIC LIGHT COMPANY PER *R. J. Gallivan*

THE HARTFORD ELECTRIC LIGHT CO.
SKETCH SHOWING POLE LINE FACILITIES ON THE PROPERTY OF DONALD R. AND GERALD F. POPE, OFF LEDYARD ST. HARTFORD, CONN.
SCALE 1"=50' M. NOV. 1973
No. E-661-93

NO.	DATE	DESCRIPTION	BY