

974

974-1



The portion of Capitol Avenue shown on this plan is an established public street of the City of Hartford.

James C. Higgins
City Engineer

December 28, 1973

CAPITOL

AVENUE

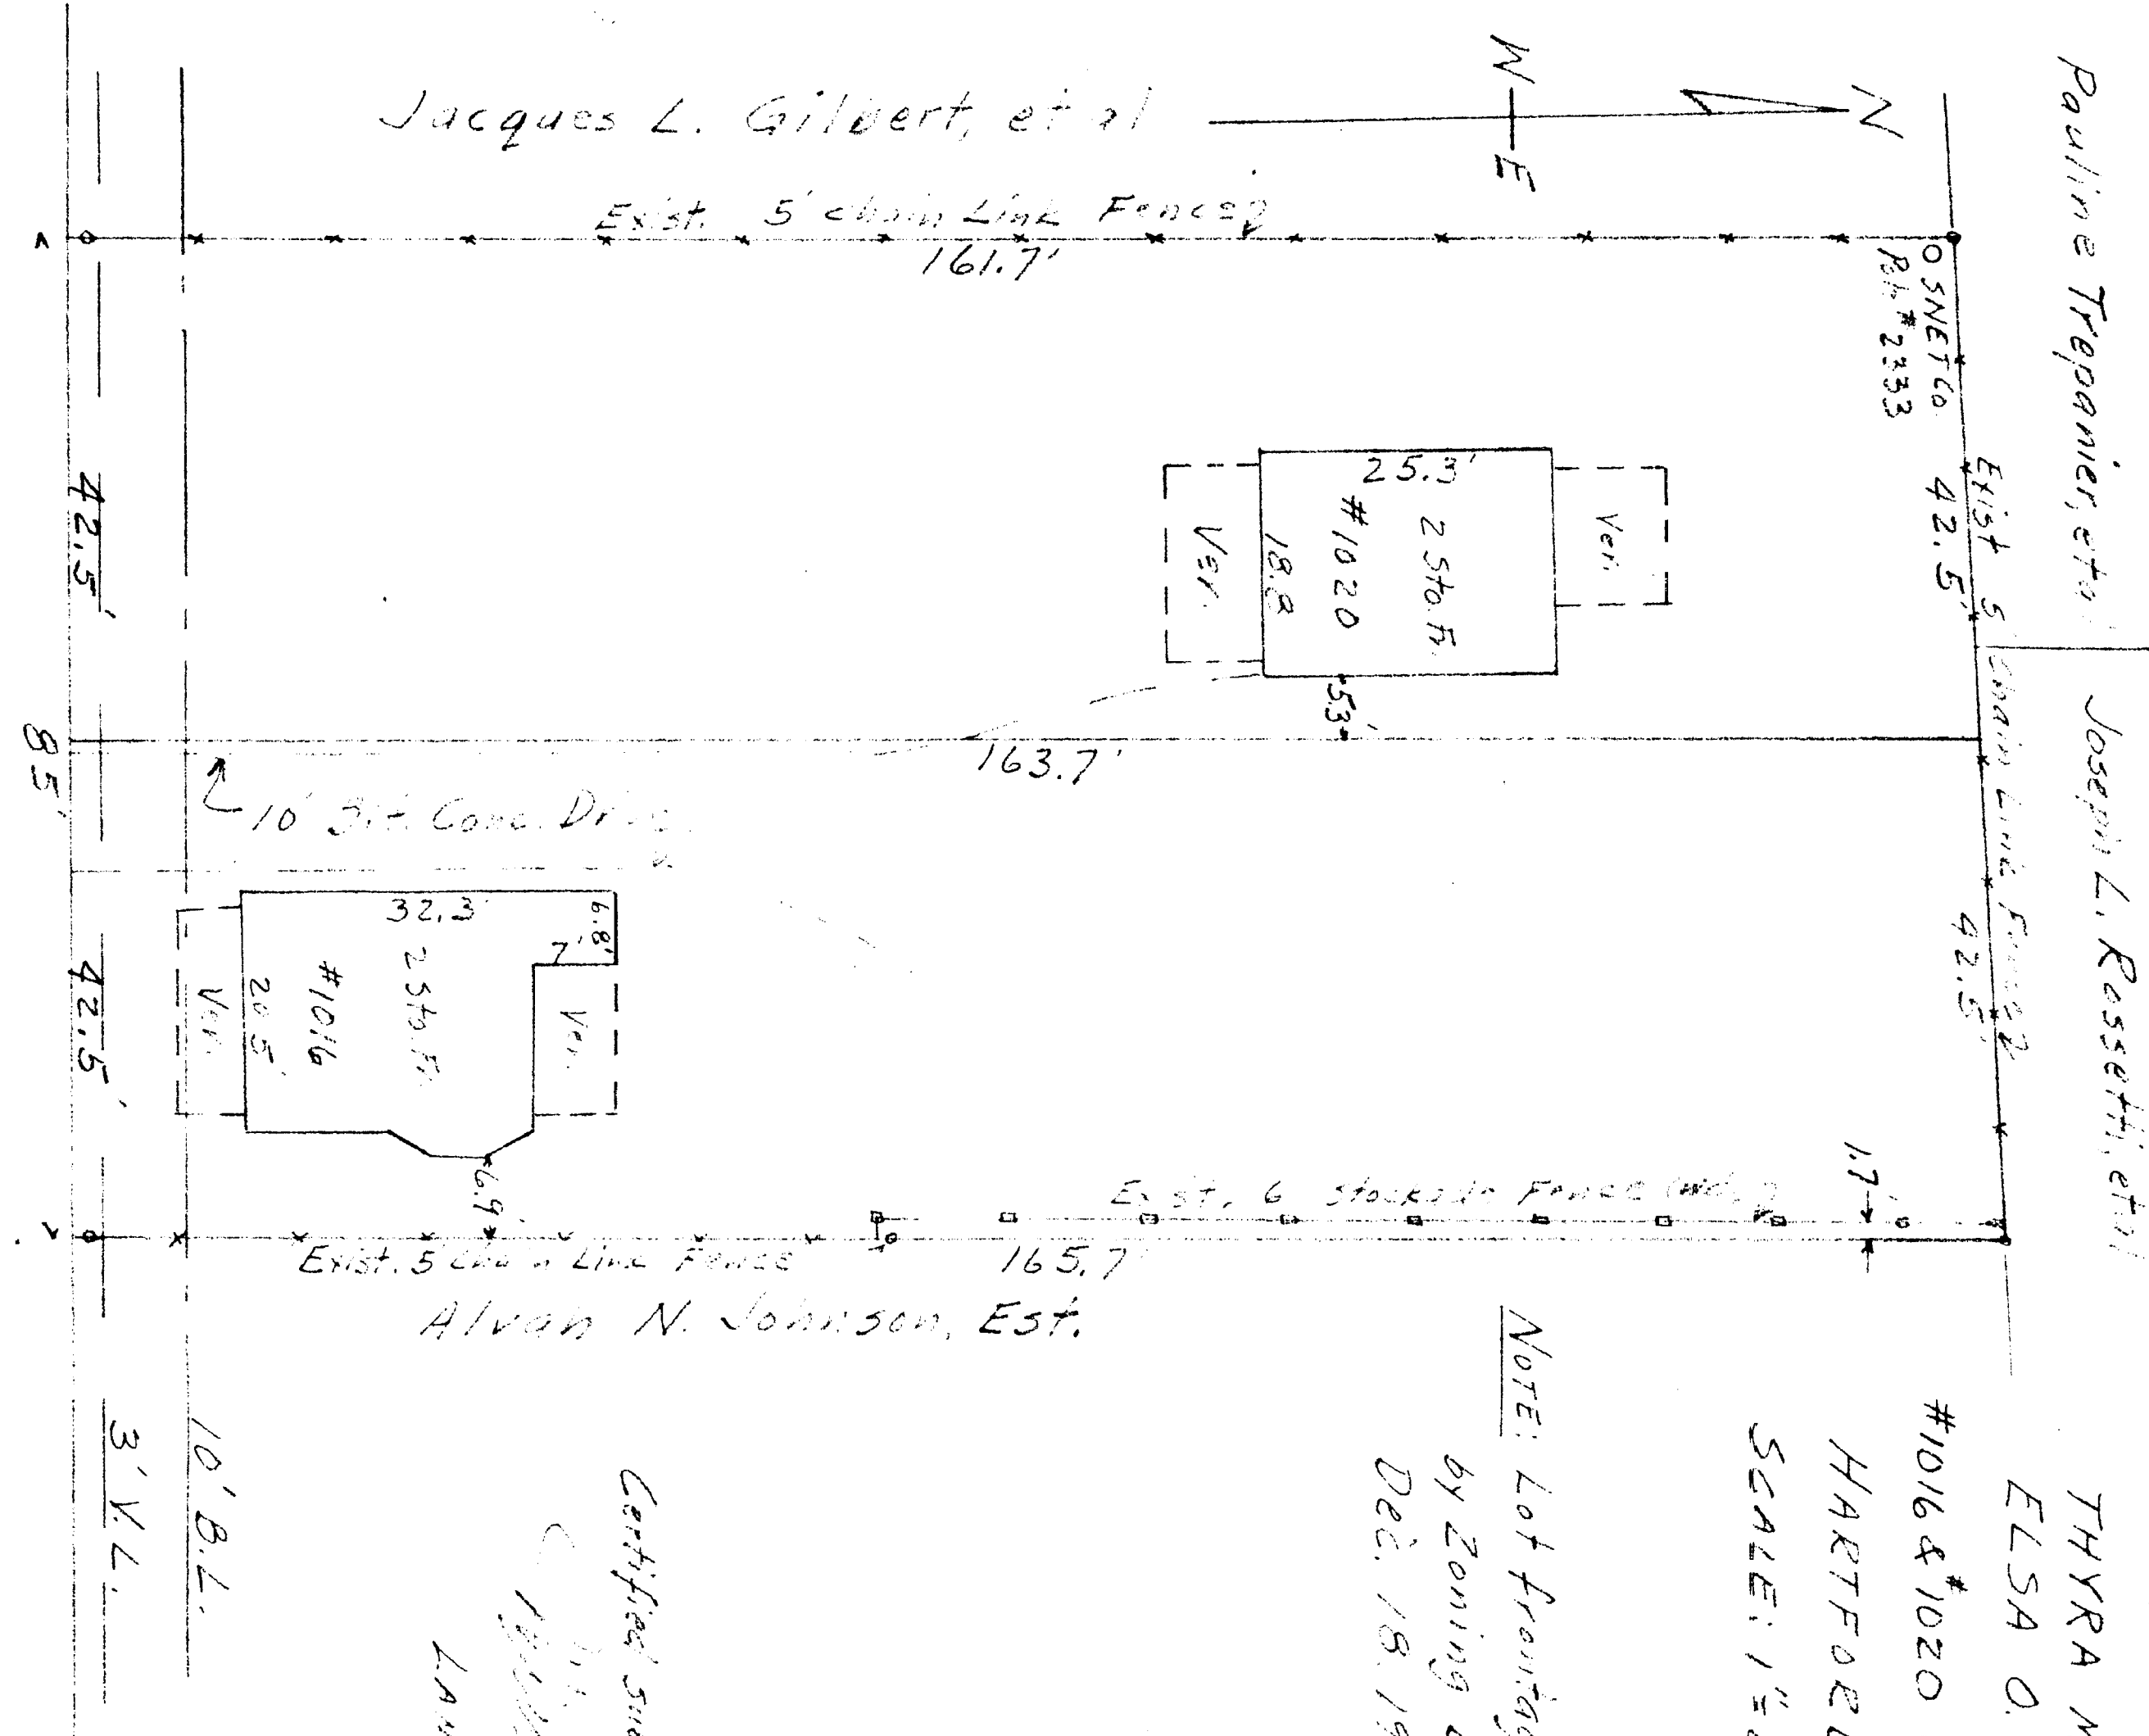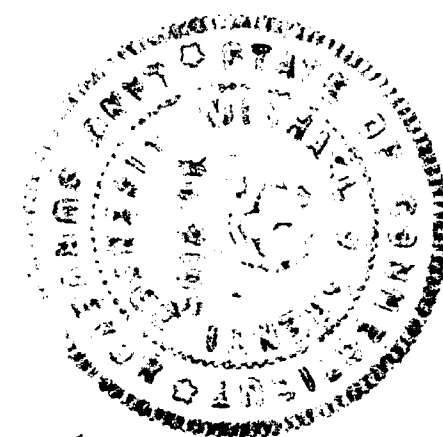

Certified substantially correct
by *James C. Higgins*
City Engineer

RECEIVED
HARTFORD, CONN.
DEC 28 3 50 PM '73
ROBERT J. GALLIVAN
TOWN & CITY CLERK

NOTE: Lot frontage variance granted
by Zoning Board of Appeals
Dec. 18, 1973.

PROPERTY
THYRA M. L. BUYRN
ELSA O. LINDGREN
#1016 & #1020 CAPITOL AVENUE
HARTFORD, CONN.
SCALE: 1" = 20' DEC. 28, 1973

