


Sheet L-1

The portions of Asylum, Ann and Trumbull sts. shown on this plan this plan are established public streets of the City of Hartford.

December 9, 1974


George A. Shaw
City Engineer

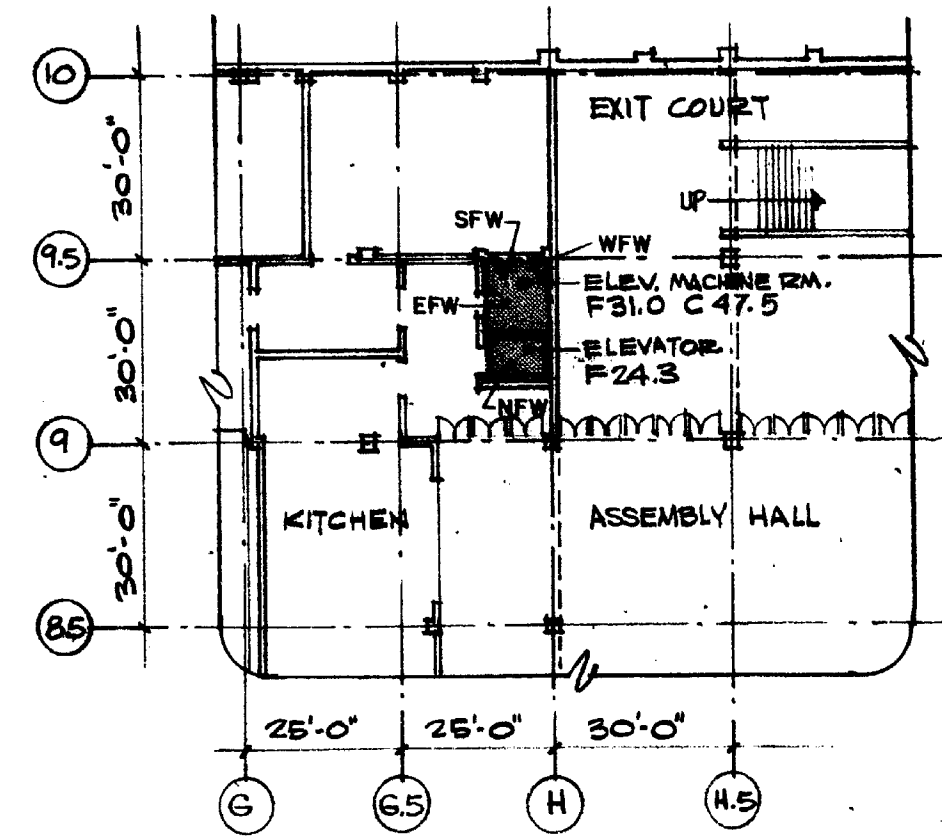


PART PLAN - LEVEL 31

NOTES


1. THE LOCATION OF PHYSICAL FEATURES WHICH ARE SHOWN ON THIS PLAN PICTORIAL ONLY AND WITHOUT DIMENSIONS WERE VERIFIED BY OBSERVATIONS AND SELECTED MEASUREMENTS AT THE SITE. THE LOCATION OF THESE PHYSICAL FEATURES WERE NOTED DURING OCTOBER 1974 AND ARE SUBJECT TO NORMAL CONSTRUCTION TOLERANCES AS TO PLACEMENT.
2. ELEVATIONS REFER TO METROPOLITAN DISTRICT COMMISSION DATUM.

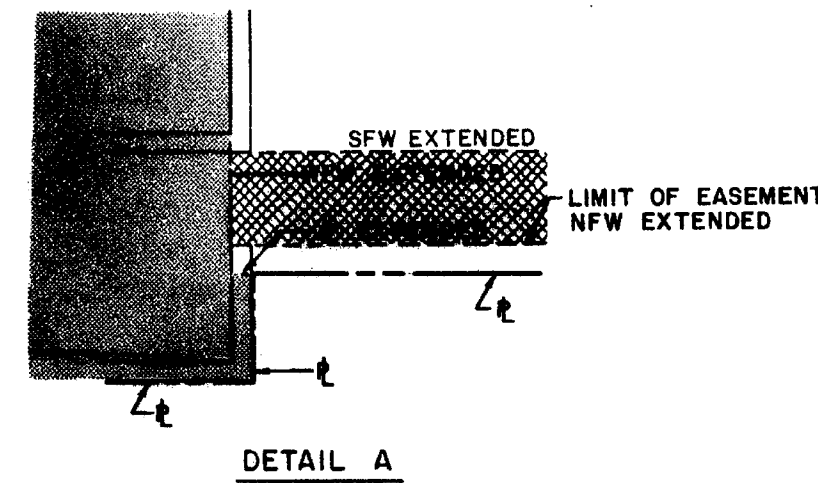


DETAIL A

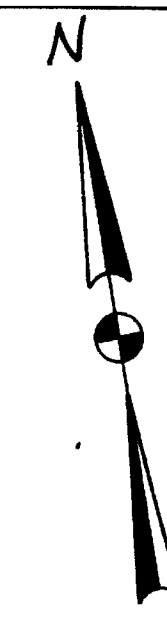

RECEIVED
HARTFORD
NOV 14 1974
HARTFORD
HARTFORD
HARTFORD

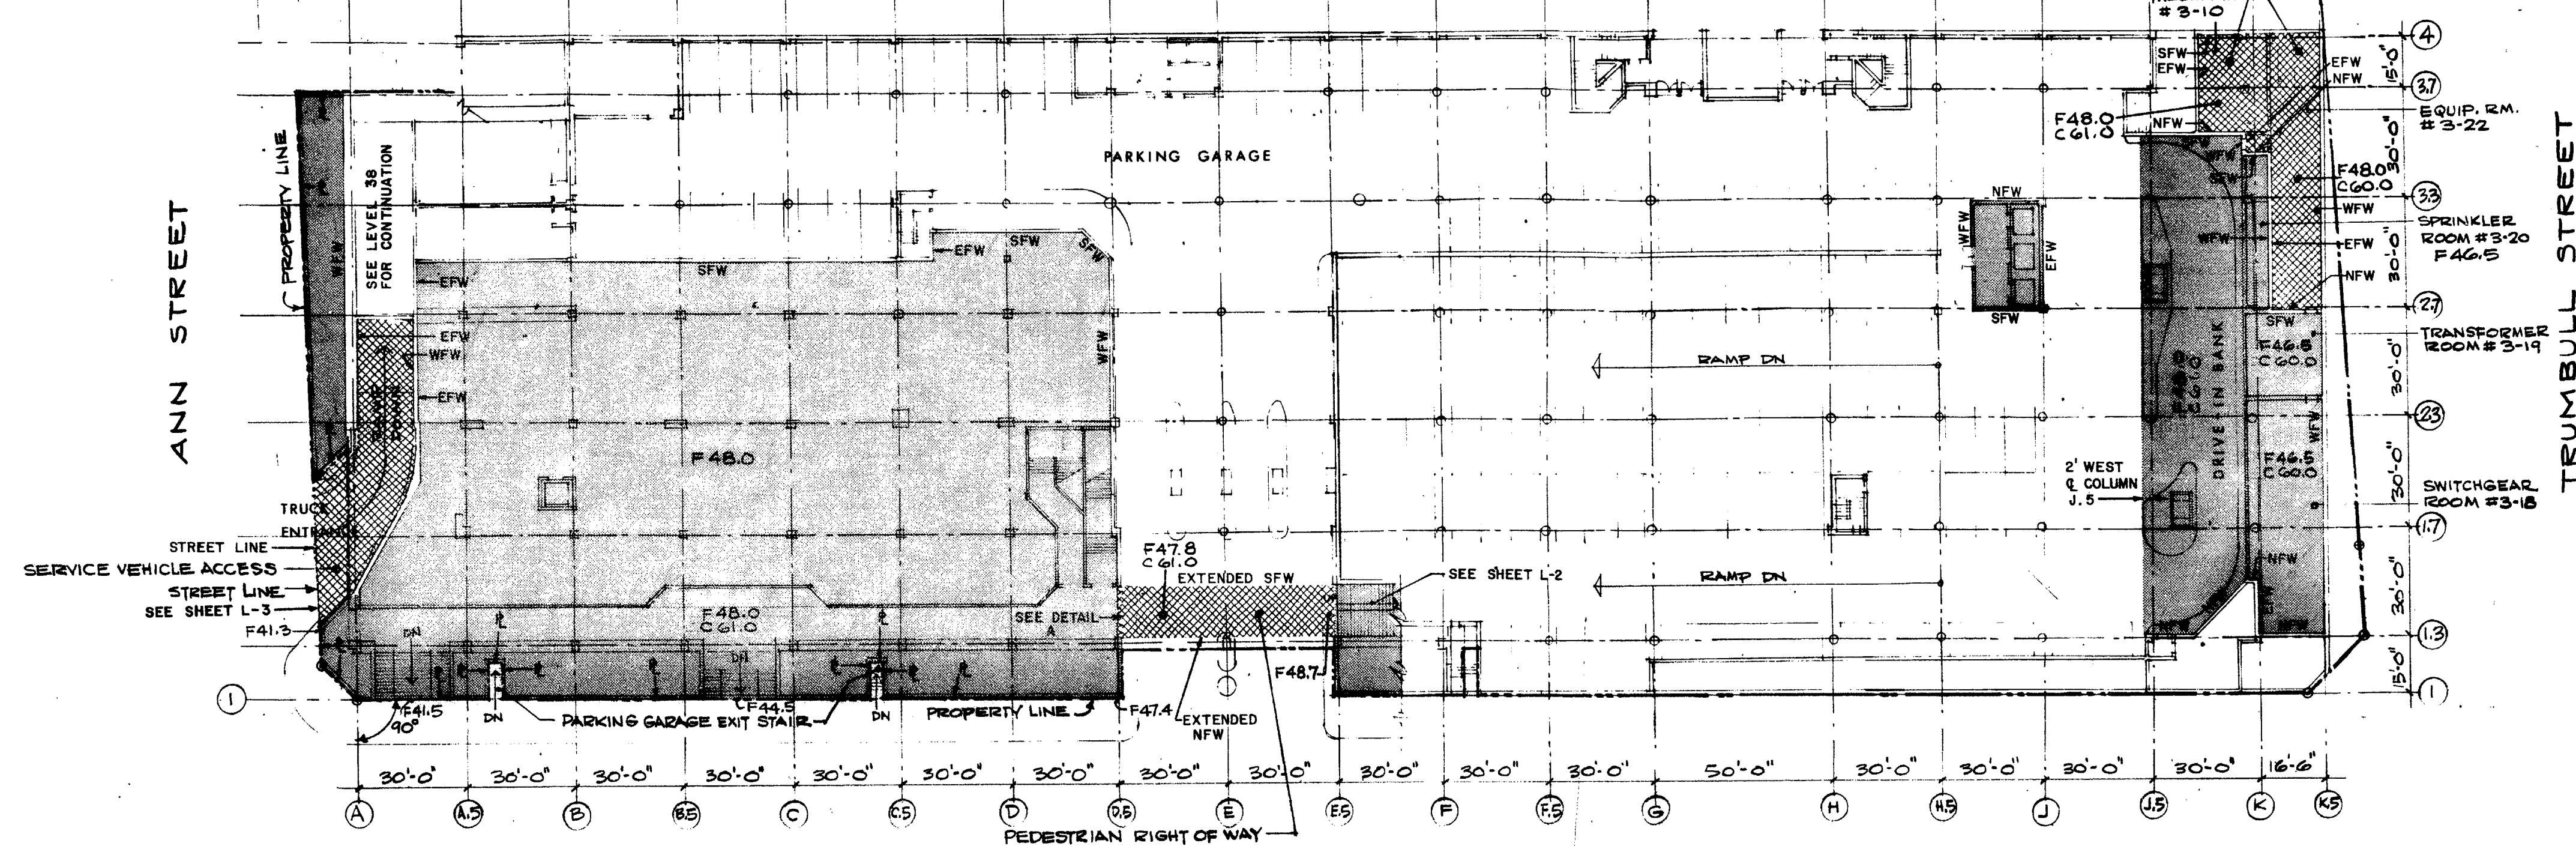

PLAN - LEVEL 48


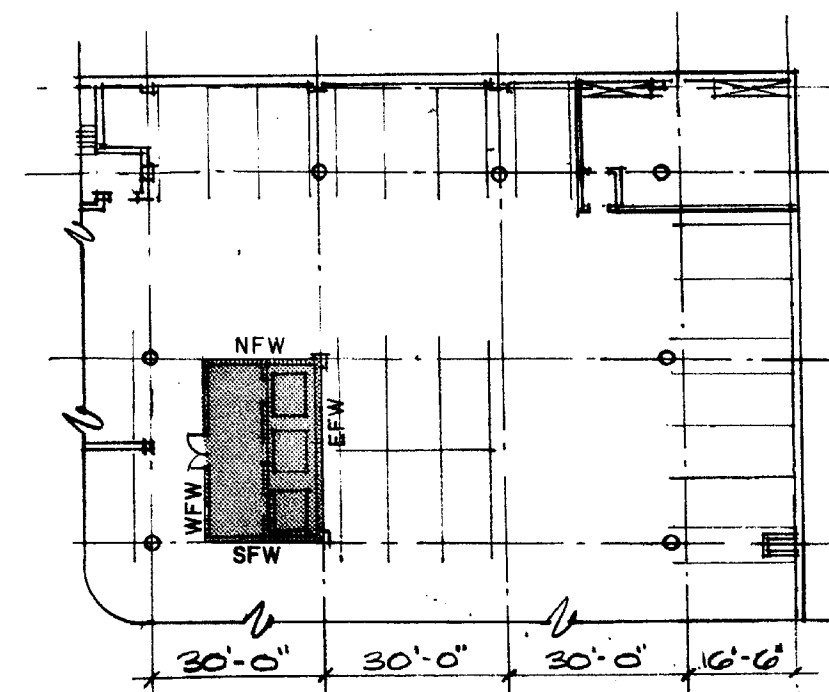


PART PLAN - LEVEL 38


LEGEND
NFW NORTH FACE WALL
SFW SOUTH FACE WALL
EFW EAST FACE WALL
WFW WEST FACE WALL

I HEREBY CERTIFY THAT THIS PLAN IS SUBSTANTIALLY CORRECT AND THAT THE LEASEHOLD PROPERTY LINE IS IN ACCORDANCE WITH CLASS A-2 OF THE CODE OF CONNECTICUT TECHNICAL COUNCIL, INC. AND ALL OTHER MEASUREMENTS ARE IN ACCORDANCE WITH NOTE 1 ABOVE.

George A. Shaw
REGISTERED LAND SURVEYOR

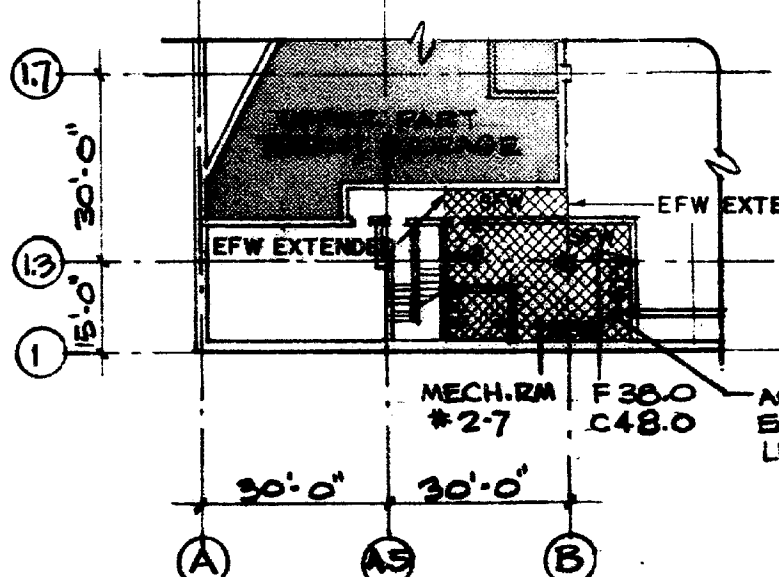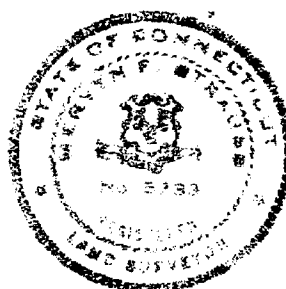

PART PLAN - LEVEL 38

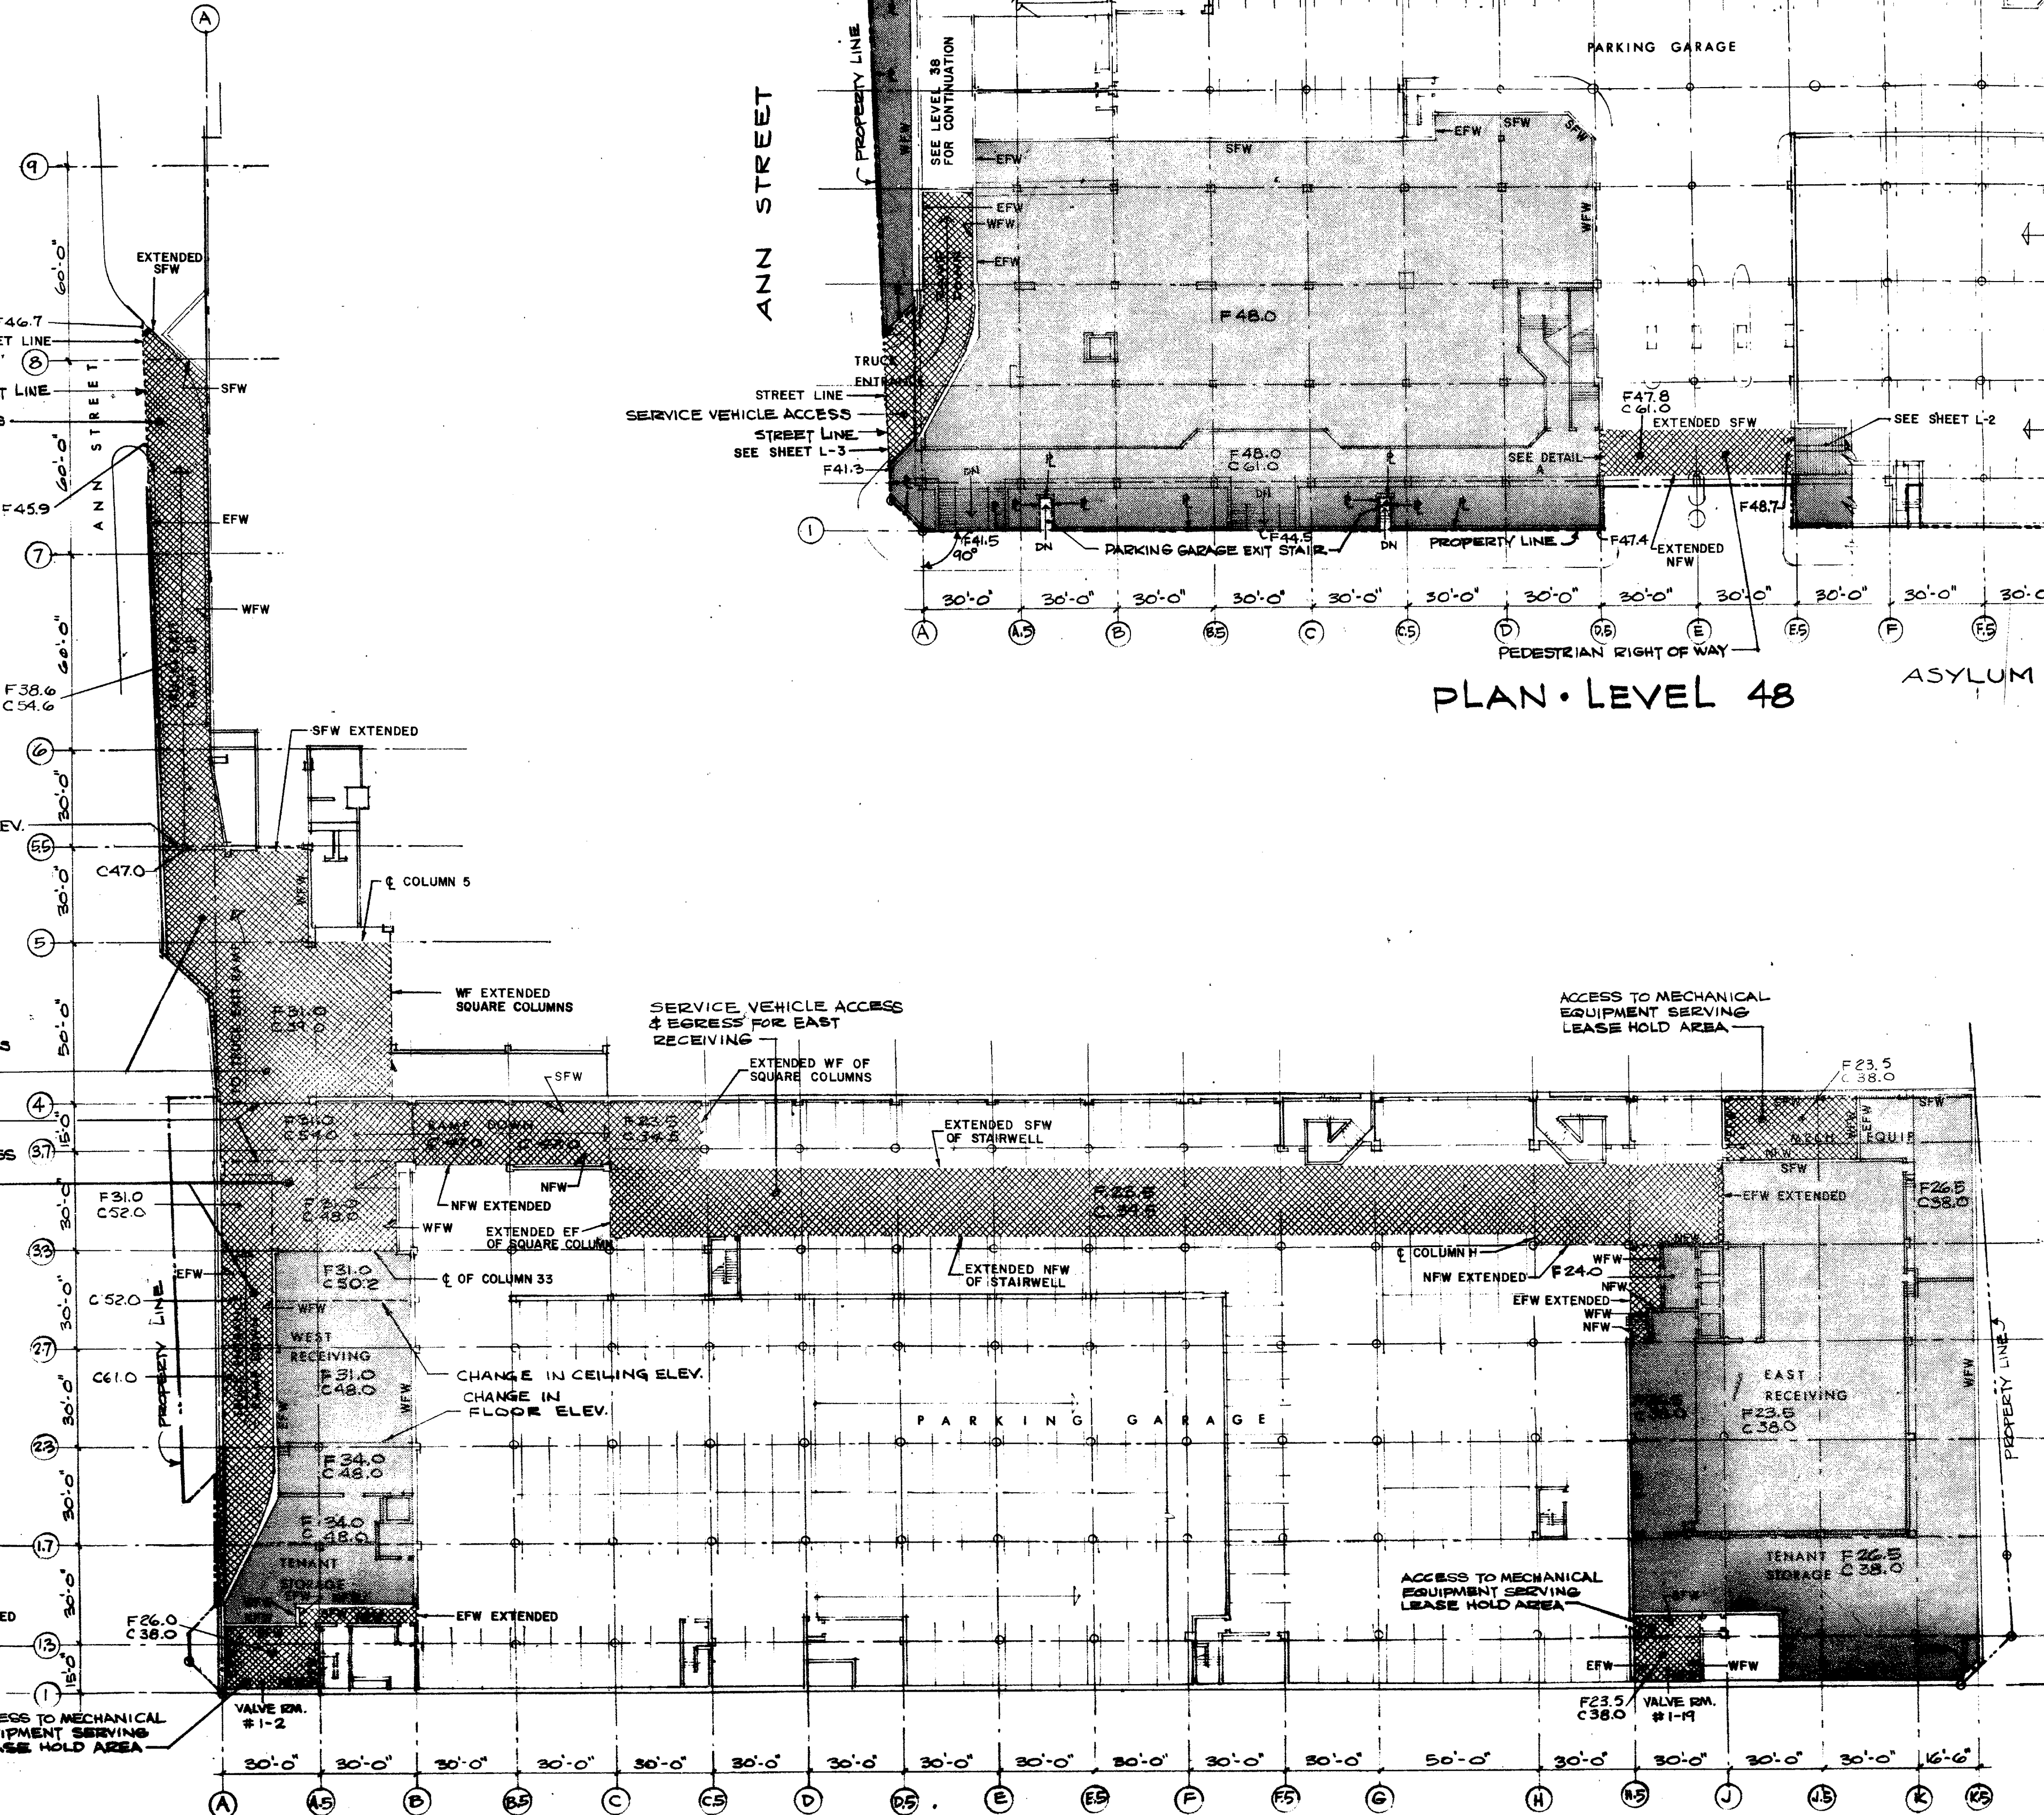

PLAN - LEVEL 23.5

LEGEND
PROPERTY OF CITY OF HARTFORD
AETNA LEASEHOLD AREA
AETNA EASEMENT ON CITY PROPERTY
F 00.0 BOTTOM LIMITING ELEVATION OF LEASEHOLD OR EASEMENT AREA (NOMINAL FLOOR ELEVATION).
C 00.0 TOP LIMITING ELEVATION OF LEASEHOLD OR EASEMENT AREA
R PROPERTY LINE. SEE 80 LEVEL PLAN SHEET L-3 FOR BOUNDARY DESCRIPTION.

LEASEHOLD & EASEMENT PLAN
LEVELS 23.5, 31, 38, & 48

THE HARTFORD CENTER
HARTFORD CONNECTICUT

0 50 FT SCALE 1" = 32 FT 16 SEP 74

REVISED NOV. 14, 1974
MORTON S. FINE and ASSOCIATES
711 Cottage Grove Rd. Bloomfield, Conn.
Engineers Landscape Architects Surveyors

L1

