Mortgage Survey

PROPERTY OF

CUSHMAN INDUSTRIES, INCORPORATED

780 WINDSOR STREET

HARTFORD CONNECTICUT

SCALE: 1" = 30' JUNE 2, 1976

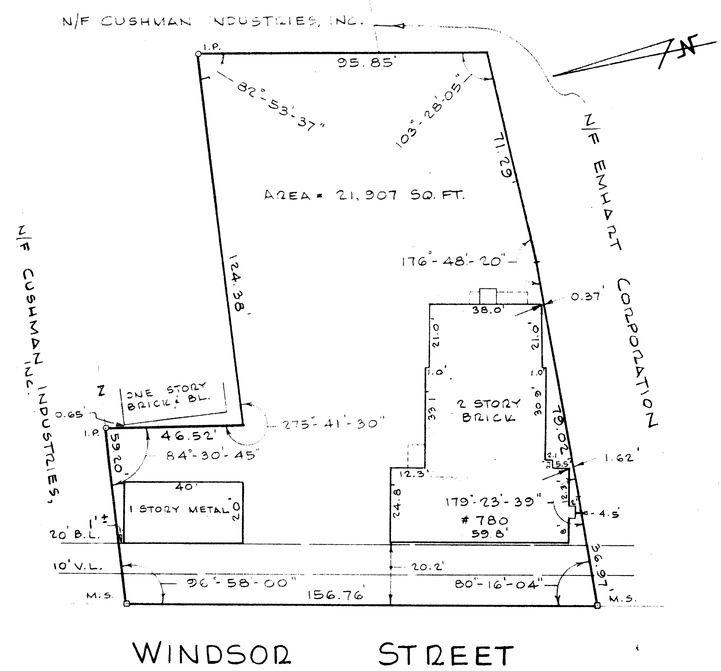

I hereby certify to Cushman Industries, Incorporated that this survey was actually made upon the ground on 5/27/76 and that it and the bounds and measurements shown hereon are correct within the standards of class A-2 of the Code of the Connecticut Technical Council, Inc., and that, unless otherwise shown, deed lines and lines of actual possession are the same, buildings are located as shown and do not encroach over or upon street, deed or building lines, there are no violations of zoning regulations with reference to the location of said buildings, and there are no easements or encroachments affecting this property apparent from a careful inspection of the same, other than those noted and depicted hereon.

CLOSE, JENSEN & MILLER
CIVIL ENGINEERS & SURVEYORS

STATE OF CONNECTICUT JOHN H. MILLER No. 418 REGISTERED LAND SURVEYOR

The portion of Windsor Street shown on this plan is an established public street of the City of Hartford.

June 30, 1976

City Engineer

RECEIVED HARTFORD, CONN. Jun 28 2 00 PM '76 ROBERT J. SULLIVAN TOWN & CITY CLERK

990

EAGLE FILE CORP. IRVINE, CA. EFN 34

0 INCHES 1 2 3 4

dd