


991-1

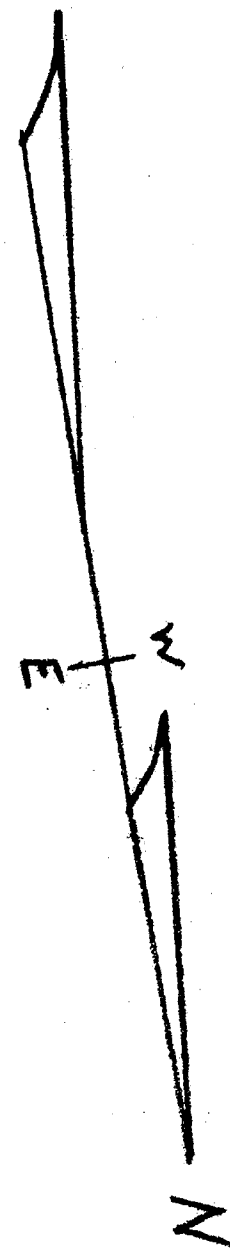

MORTGAGE SURVEY

PROPERTY OF

JOSE BRAGA

MARIA BRAGA


HARTFORD CONN.

JUNE 1976 SCALE 1" = 20'

TO HARTFORD FEDERAL SAVINGS  
AND LOAN ASSOCIATION:

CERTIFIED SUBSTANTIALLY CORRECT  
AND NO ZONING REGULATIONS HAVE  
BEEN VIOLATED.


SURVEYOR

NOTE: THE HOUSE IS NONCONFORMING  
UNDER PRESENT ZONING REGULATIONS.


ZONE B-4

MINIMUM SIDE YARD = 8'

NOTE: NEW PARK AVENUE  
WAS WIDENED 5' ON  
EACH SIDE 8-18-30

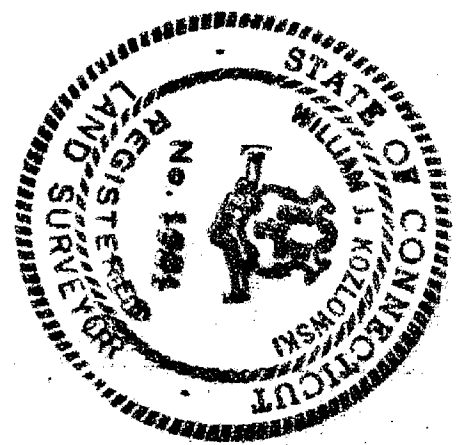

NEW PARK AVENUE

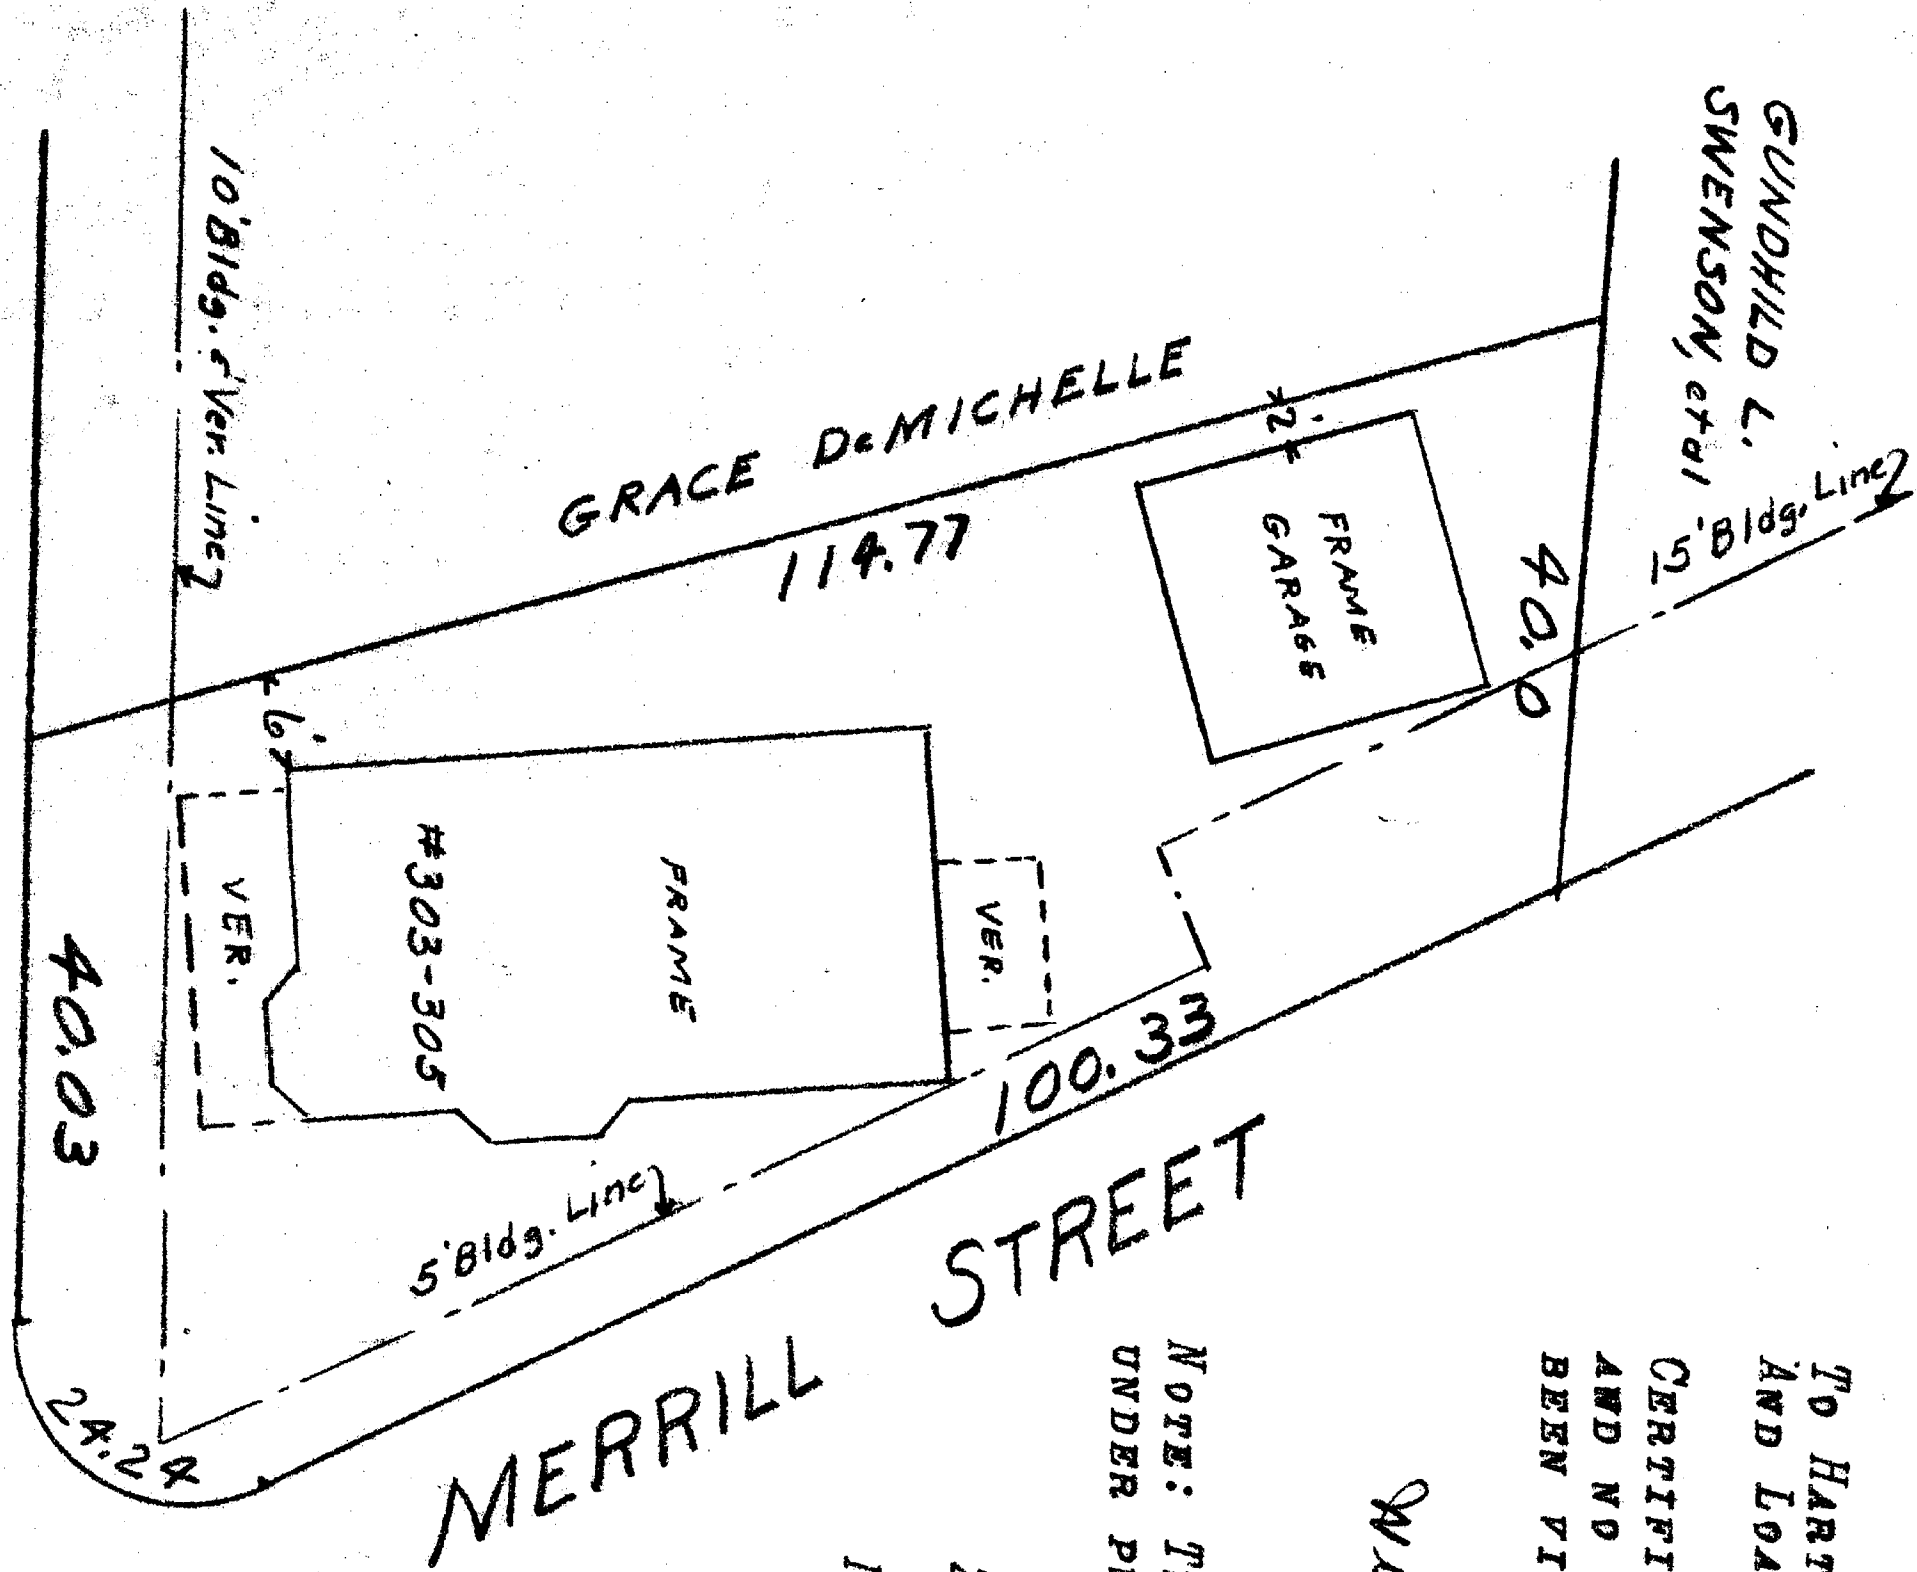

The portions of New Park Avenue and  
Merrill Street shown on this plan are  
established public streets of the City  
of Hartford.  
June 25, 1976

*George C. Sullivan*  
CITY ENGINEER

RECEIVED  
HARTFORD, CONN.  
JUN 24 10 50 AM '76  
ROBERT J. GALLIVAN  
TOWN & CITY CLERK

166

ESB FILE CORP. IRVING CA

EPH 34

