


1000

Jan. 11, 1977

George E. Hopper
City Engineer

RECEIVED
HASTERS, CONN
JAN 11 11 40 AM '77
ROBERT W. HASTERS
TOWN CLERK

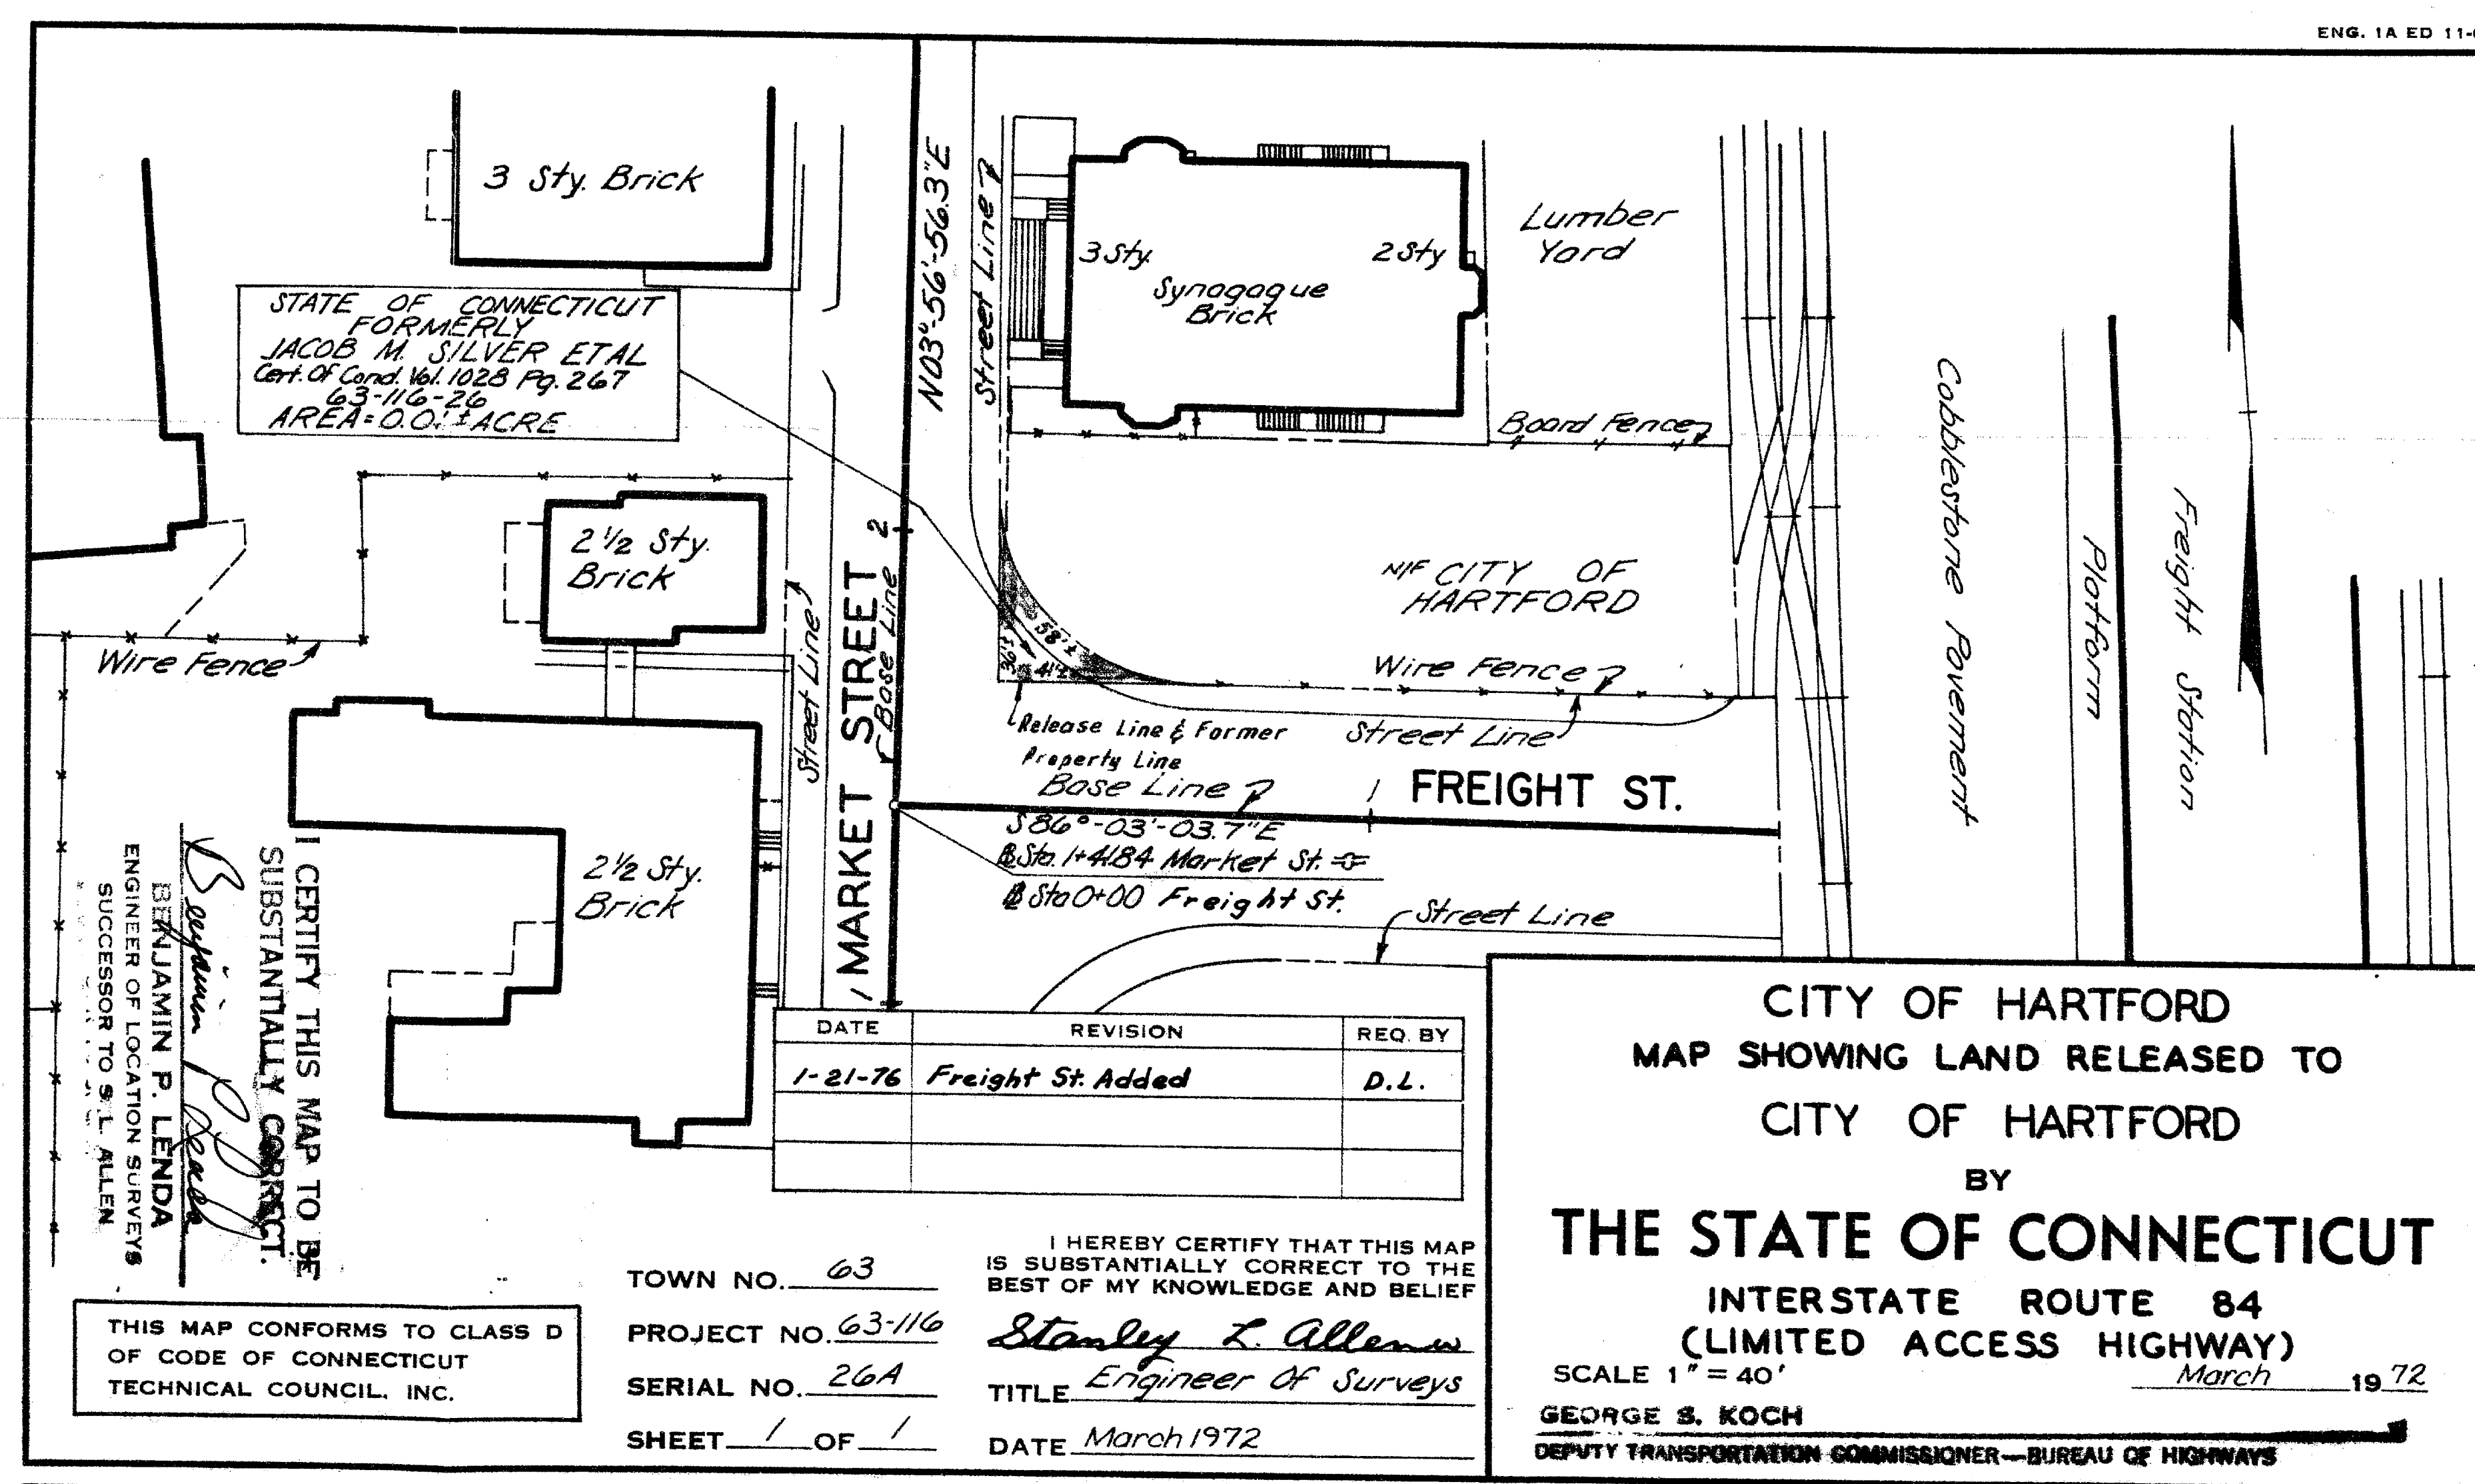

0 INCHES 1 2 3