


RECEIVED
HARTFORD, CONN.
DEC 7 2 45 PM '76
ROBERT TOWN
ALLIANCE
CLERK

PARK STREET

B.M. C.M.S. N.W. COR. OF
HEATH ST. EL. 74.98

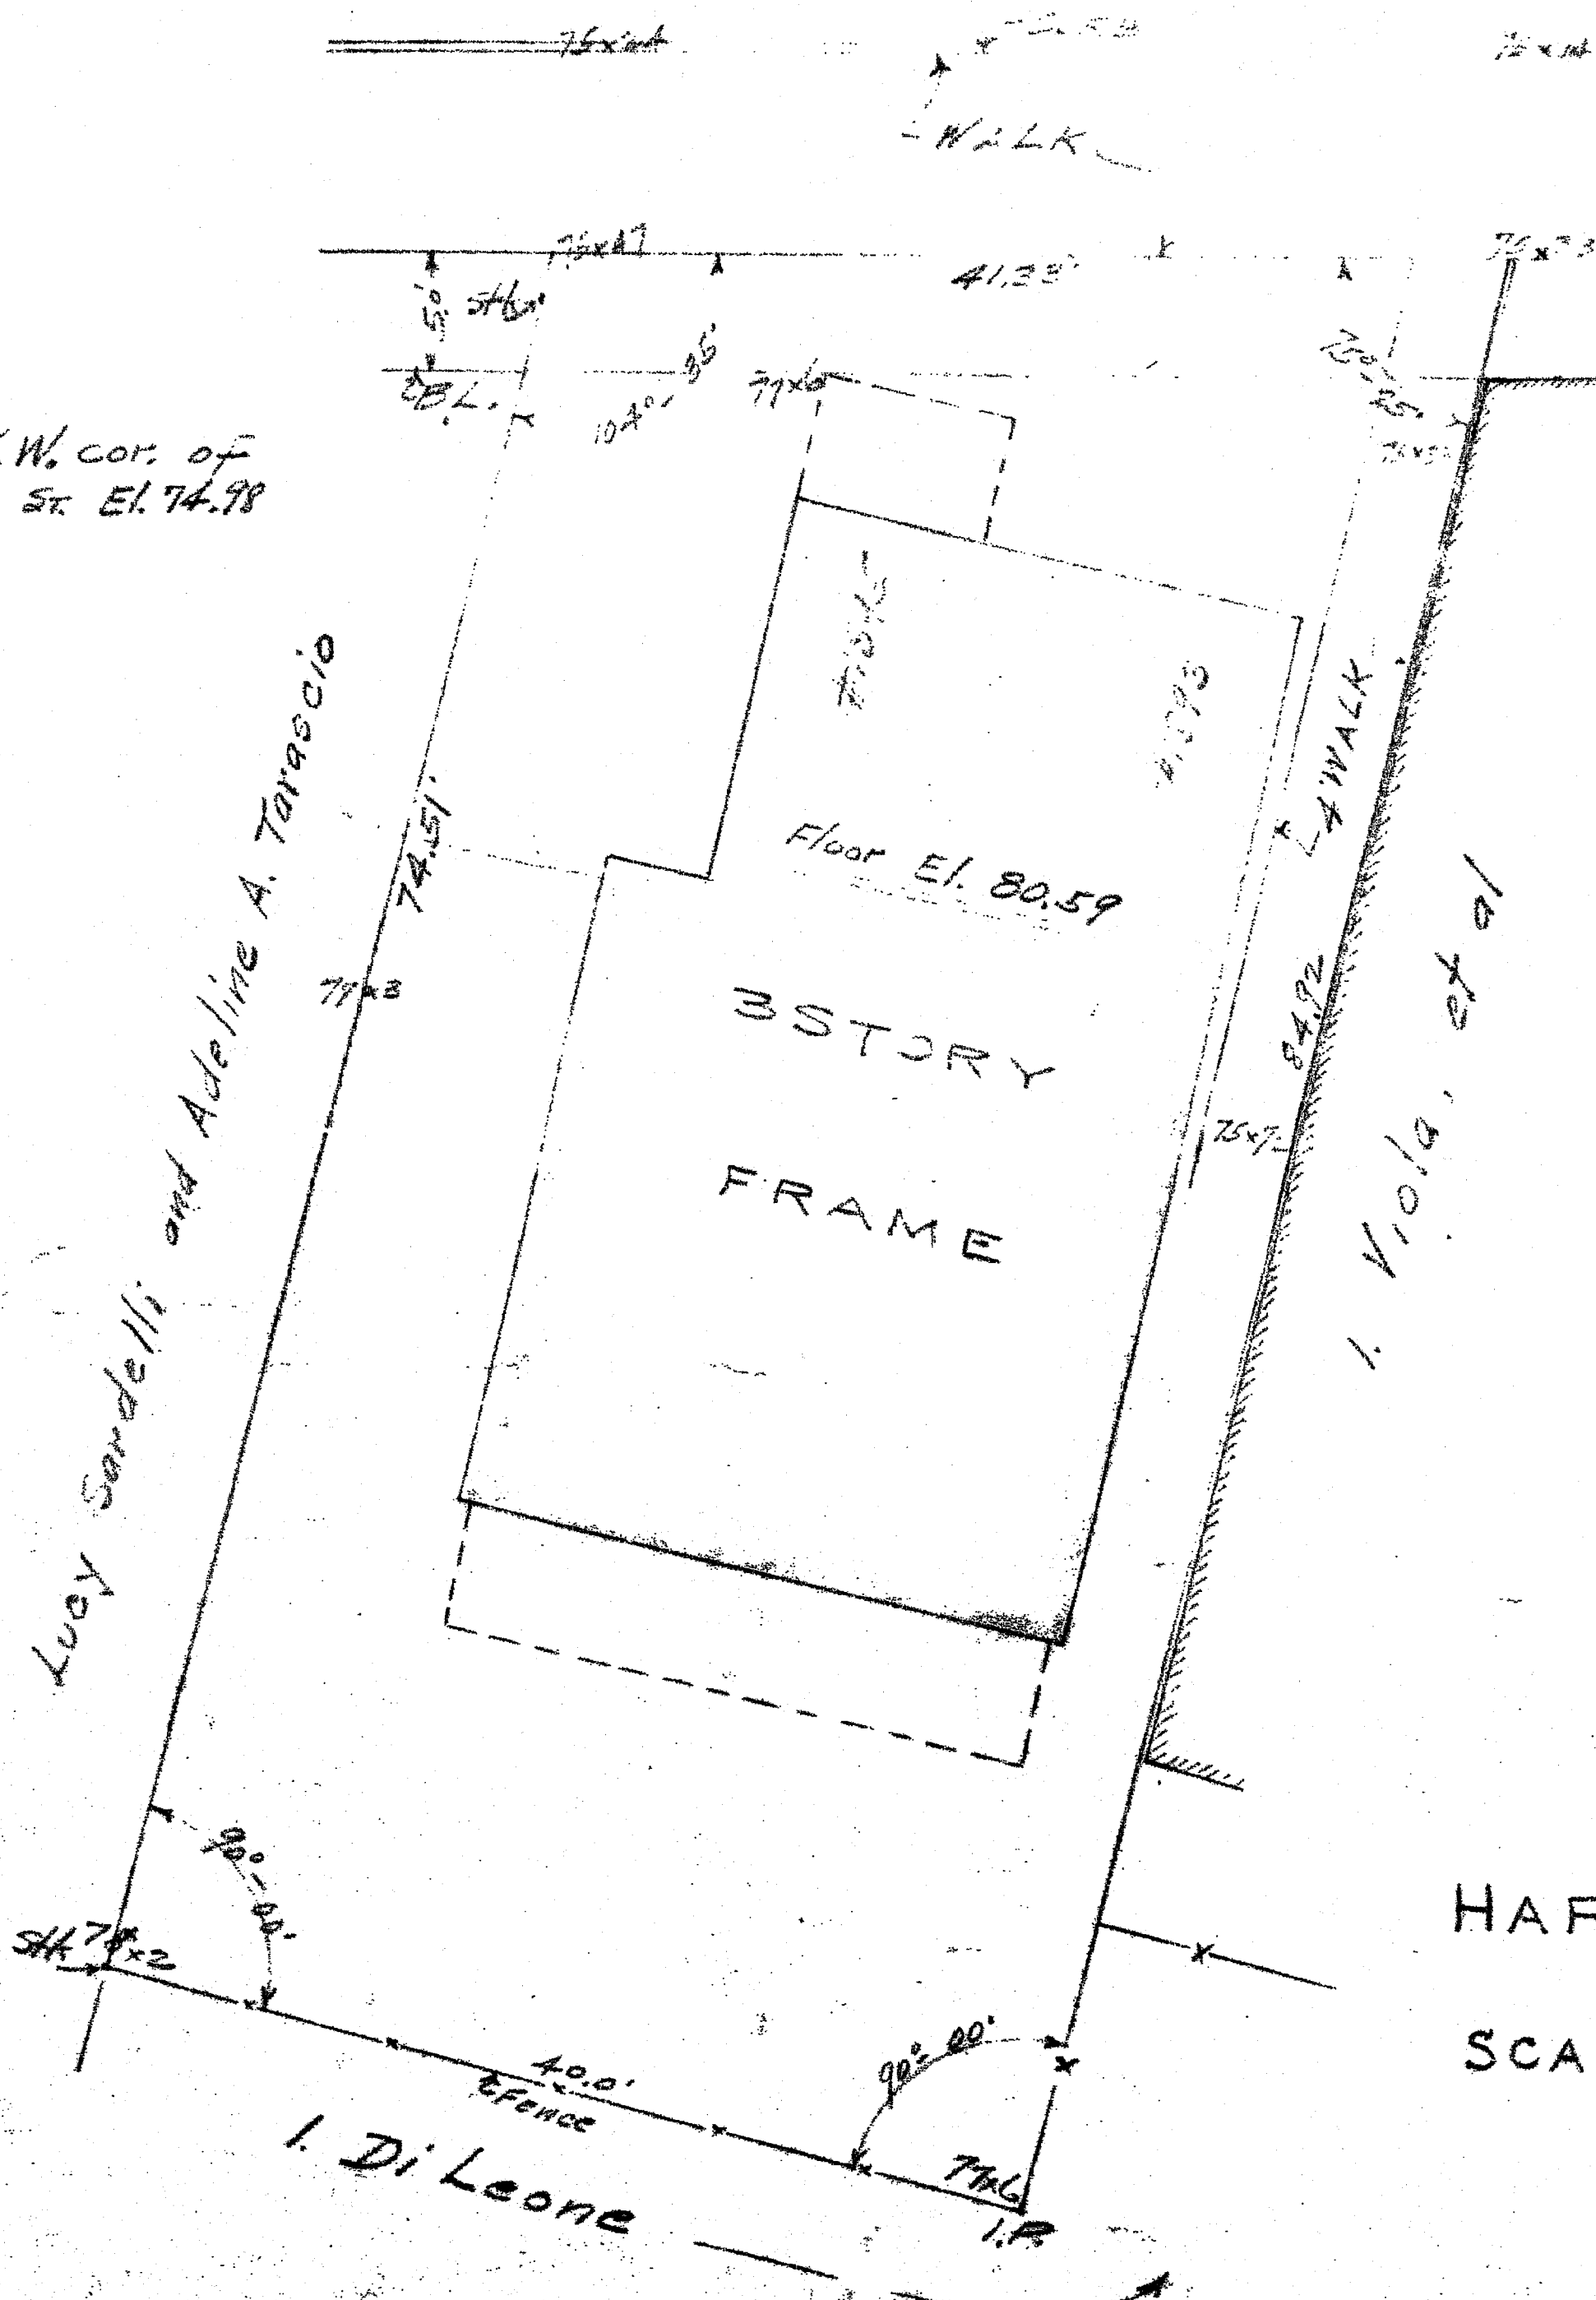

PROPERTY OF
HARRY MEZOCNOW
(MEZOCNOW)
1893-1895 PARK ST.

HARTFORD CONNECTICUT

SCALE 1" = 8'

MAY 1953

F. PERRY CLOSE
CIVIL AND CONSULTING ENGINEER
HARTFORD, CONN.

The portion of Park Street shown on this plan is an
established public street of the City of Hartford.

Dec. 7, 1976

George S. Higgins
City Engineer

I hereby certify that this map is substantially correct
and zoning regulations are not violated.

George S. Higgins
Civil Engineer

