


RECEIVED
JUN 6 10 03 AM '76
#392735

I HEREBY CERTIFY TO:
BUSHNELL PLAZA DEVELOPMENT CORP., LAWYERS TITLE INSURANCE CORPORATION
AND THE SECRETARY OF HOUSING AND URBAN DEVELOPMENT THAT THIS SURVEY
WAS ACTUALLY MADE UPON THE GROUND AND THAT IT AND THE BOUNDS AND
MEASUREMENTS SHOWN HEREON ARE CORRECT WITHIN THE STANDARDS OF
CLASS A-2 OF THE CODE OF THE TECHNICAL COUNCIL, INC., AND THAT, UNLESS
OTHERWISE SHOWN, TITLE LINES AND LINES OF ACTUAL POSSESSION ARE THE
SAME, THAT THE LAND IS VACANT AND THAT THERE ARE NO ENCROACHMENTS
OVER OR UPON STREET, TITLE OR BUILDING LINES EXCEPT AS NOTED, THERE
ARE NO VIOLATIONS OF ZONING REGULATIONS WITH REFERENCE TO THE LOCATION
OF SAID IMPROVEMENTS, AND THERE ARE NO EASEMENTS OR ENCROACHMENTS AF-
FECTING THIS PROPERTY APPARENT FROM A CAREFUL INSPECTION OF THE SAME
EXCEPT AS NOTED.

Matthew T. Strauss
6/16/76
STRAUSS ENGINEERING ASSOCIATES

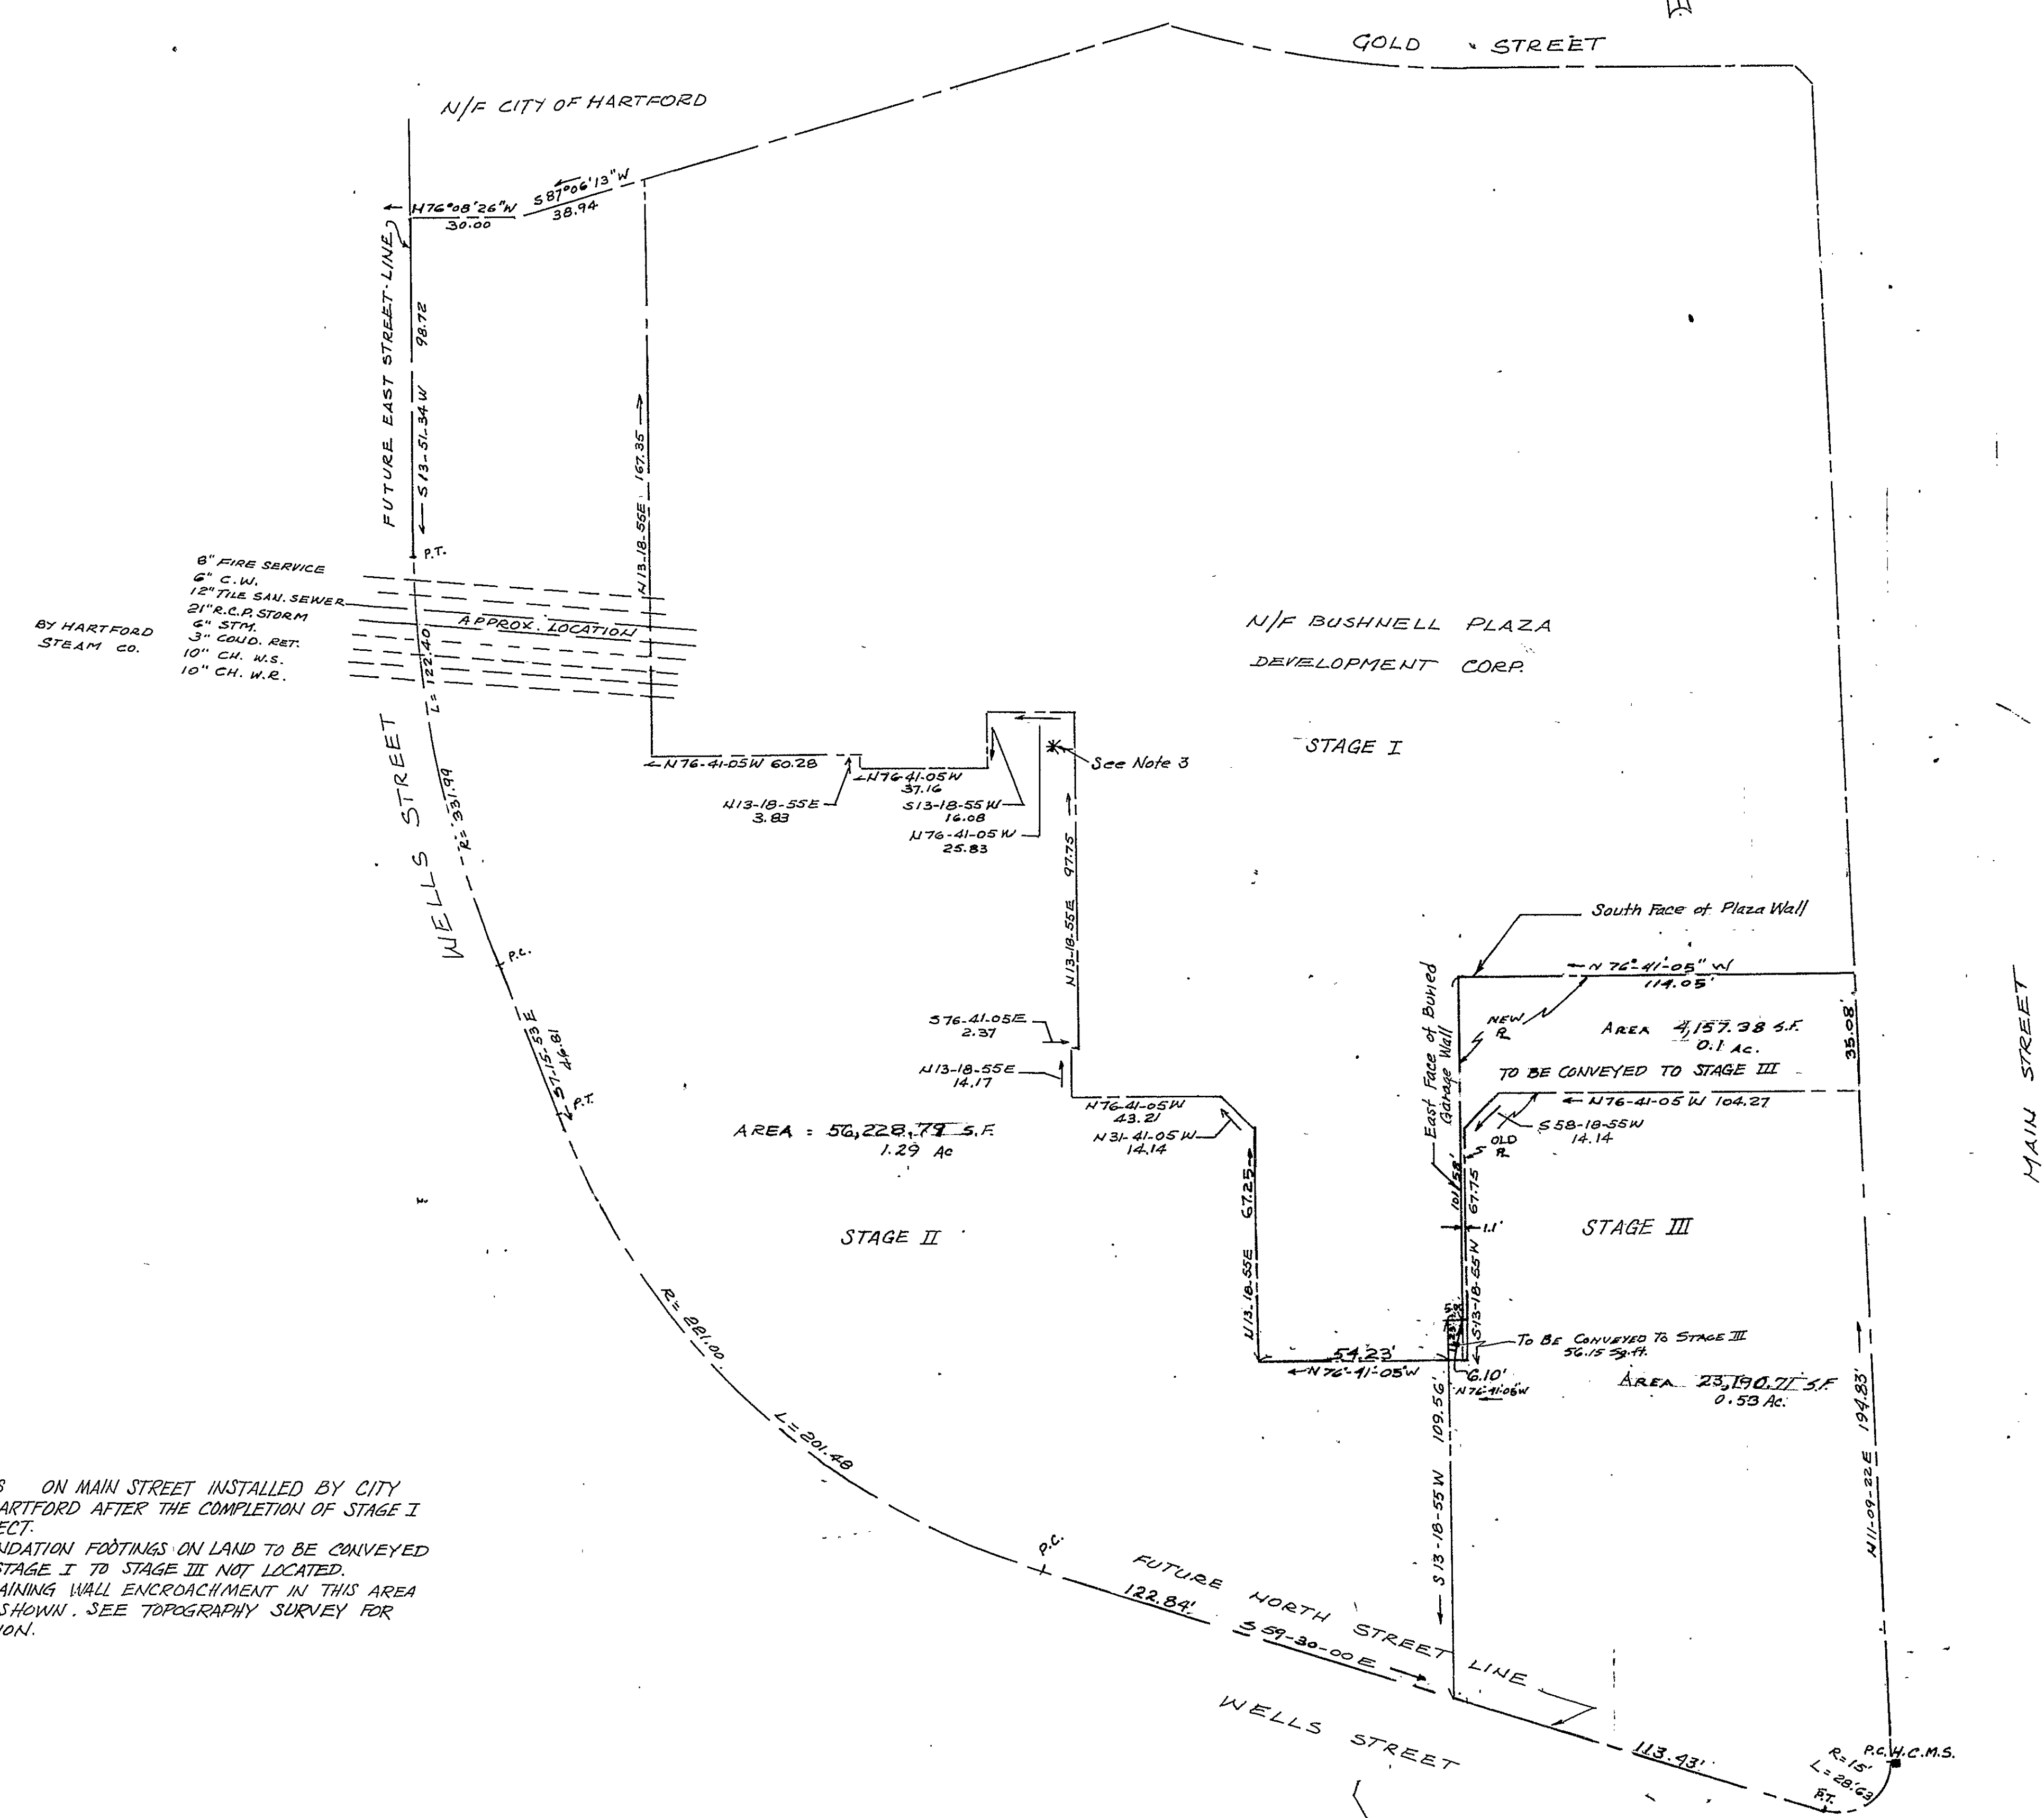

- NOTE:
1. H.C.M.S. ON MAIN STREET INSTALLED BY CITY OF HARTFORD AFTER THE COMPLETION OF STAGE I PROJECT.
 2. FOUNDATION FOOTINGS ON LAND TO BE CONVEYED BY STAGE I TO STAGE III NOT LOCATED.
 3. RETAINING WALL ENCROACHMENT IN THIS AREA NOT SHOWN. SEE TOPOGRAPHY SURVEY FOR LOCATION.


The portions of Main Street, Wells Street, and Gold Street shown on this plan are established public streets of the City of Hartford.
August 6, 1976
James C. Albano
City Engineer

I, HEREBY CERTIFY THIS MAP TO BE SUBSTANTIALLY CORRECT AND IN ACCORDANCE WITH CLASS A-2 OF CODE OF CONN. TECHNICAL COUNCIL, INC.

REGISTERED LAND SURVEYOR
Matthew T. Strauss

REV. 6-16-76 CERTIFICATION ADDED
REV. 4-8-76 ADDED NOTE
REV. 9-15-75 - 2 MOVED S' WEST FROM STAGE III
REV. 7-24-75 - STAGE II CHANGED TO "STAGE III"
REV. 7-21-75 DIM. & AREAS ADDED

	BOUNDARY MAP BUSHNELL PLAZA, STAGE II & III, PROPERTY OF BUSHNELL PLAZA DEVELOPMENT CORP. HARTFORD, CONNECTICUT		
	DATE: 5-20-75	DRAWN BY: A.T.	JOB NO: 2683-A
	SCALE: 1"=30'	CHECKED BY: P.F.	SHEET NO: 1
	MORTON S. FINE & ASSOCIATES, INC. 711 Cottage Grove Rd. Bloomfield, Conn. Engineers Landscape Architects Surveyors		

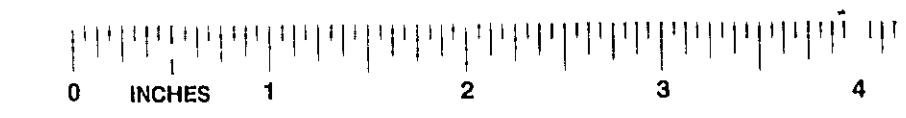

1026