

PROPERTY OF
ON CORPORATION
SURVEYED FOR


HARTFORD NATIONAL BANK & TRUST CO.

WETHERSFIELD AVENUE
HARTFORD, CONNECTICUT


SCALE: 1 INCH = 8 FEET

SEPT. 1966
REVISED NOV., 1976

PETERSEN & HOFFMAN
SUCCESSORS TO SPENCER & WASHBURN, INC

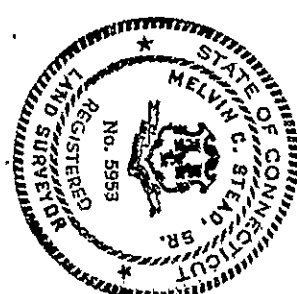[illegible]

CLASS A-2 SURVEY

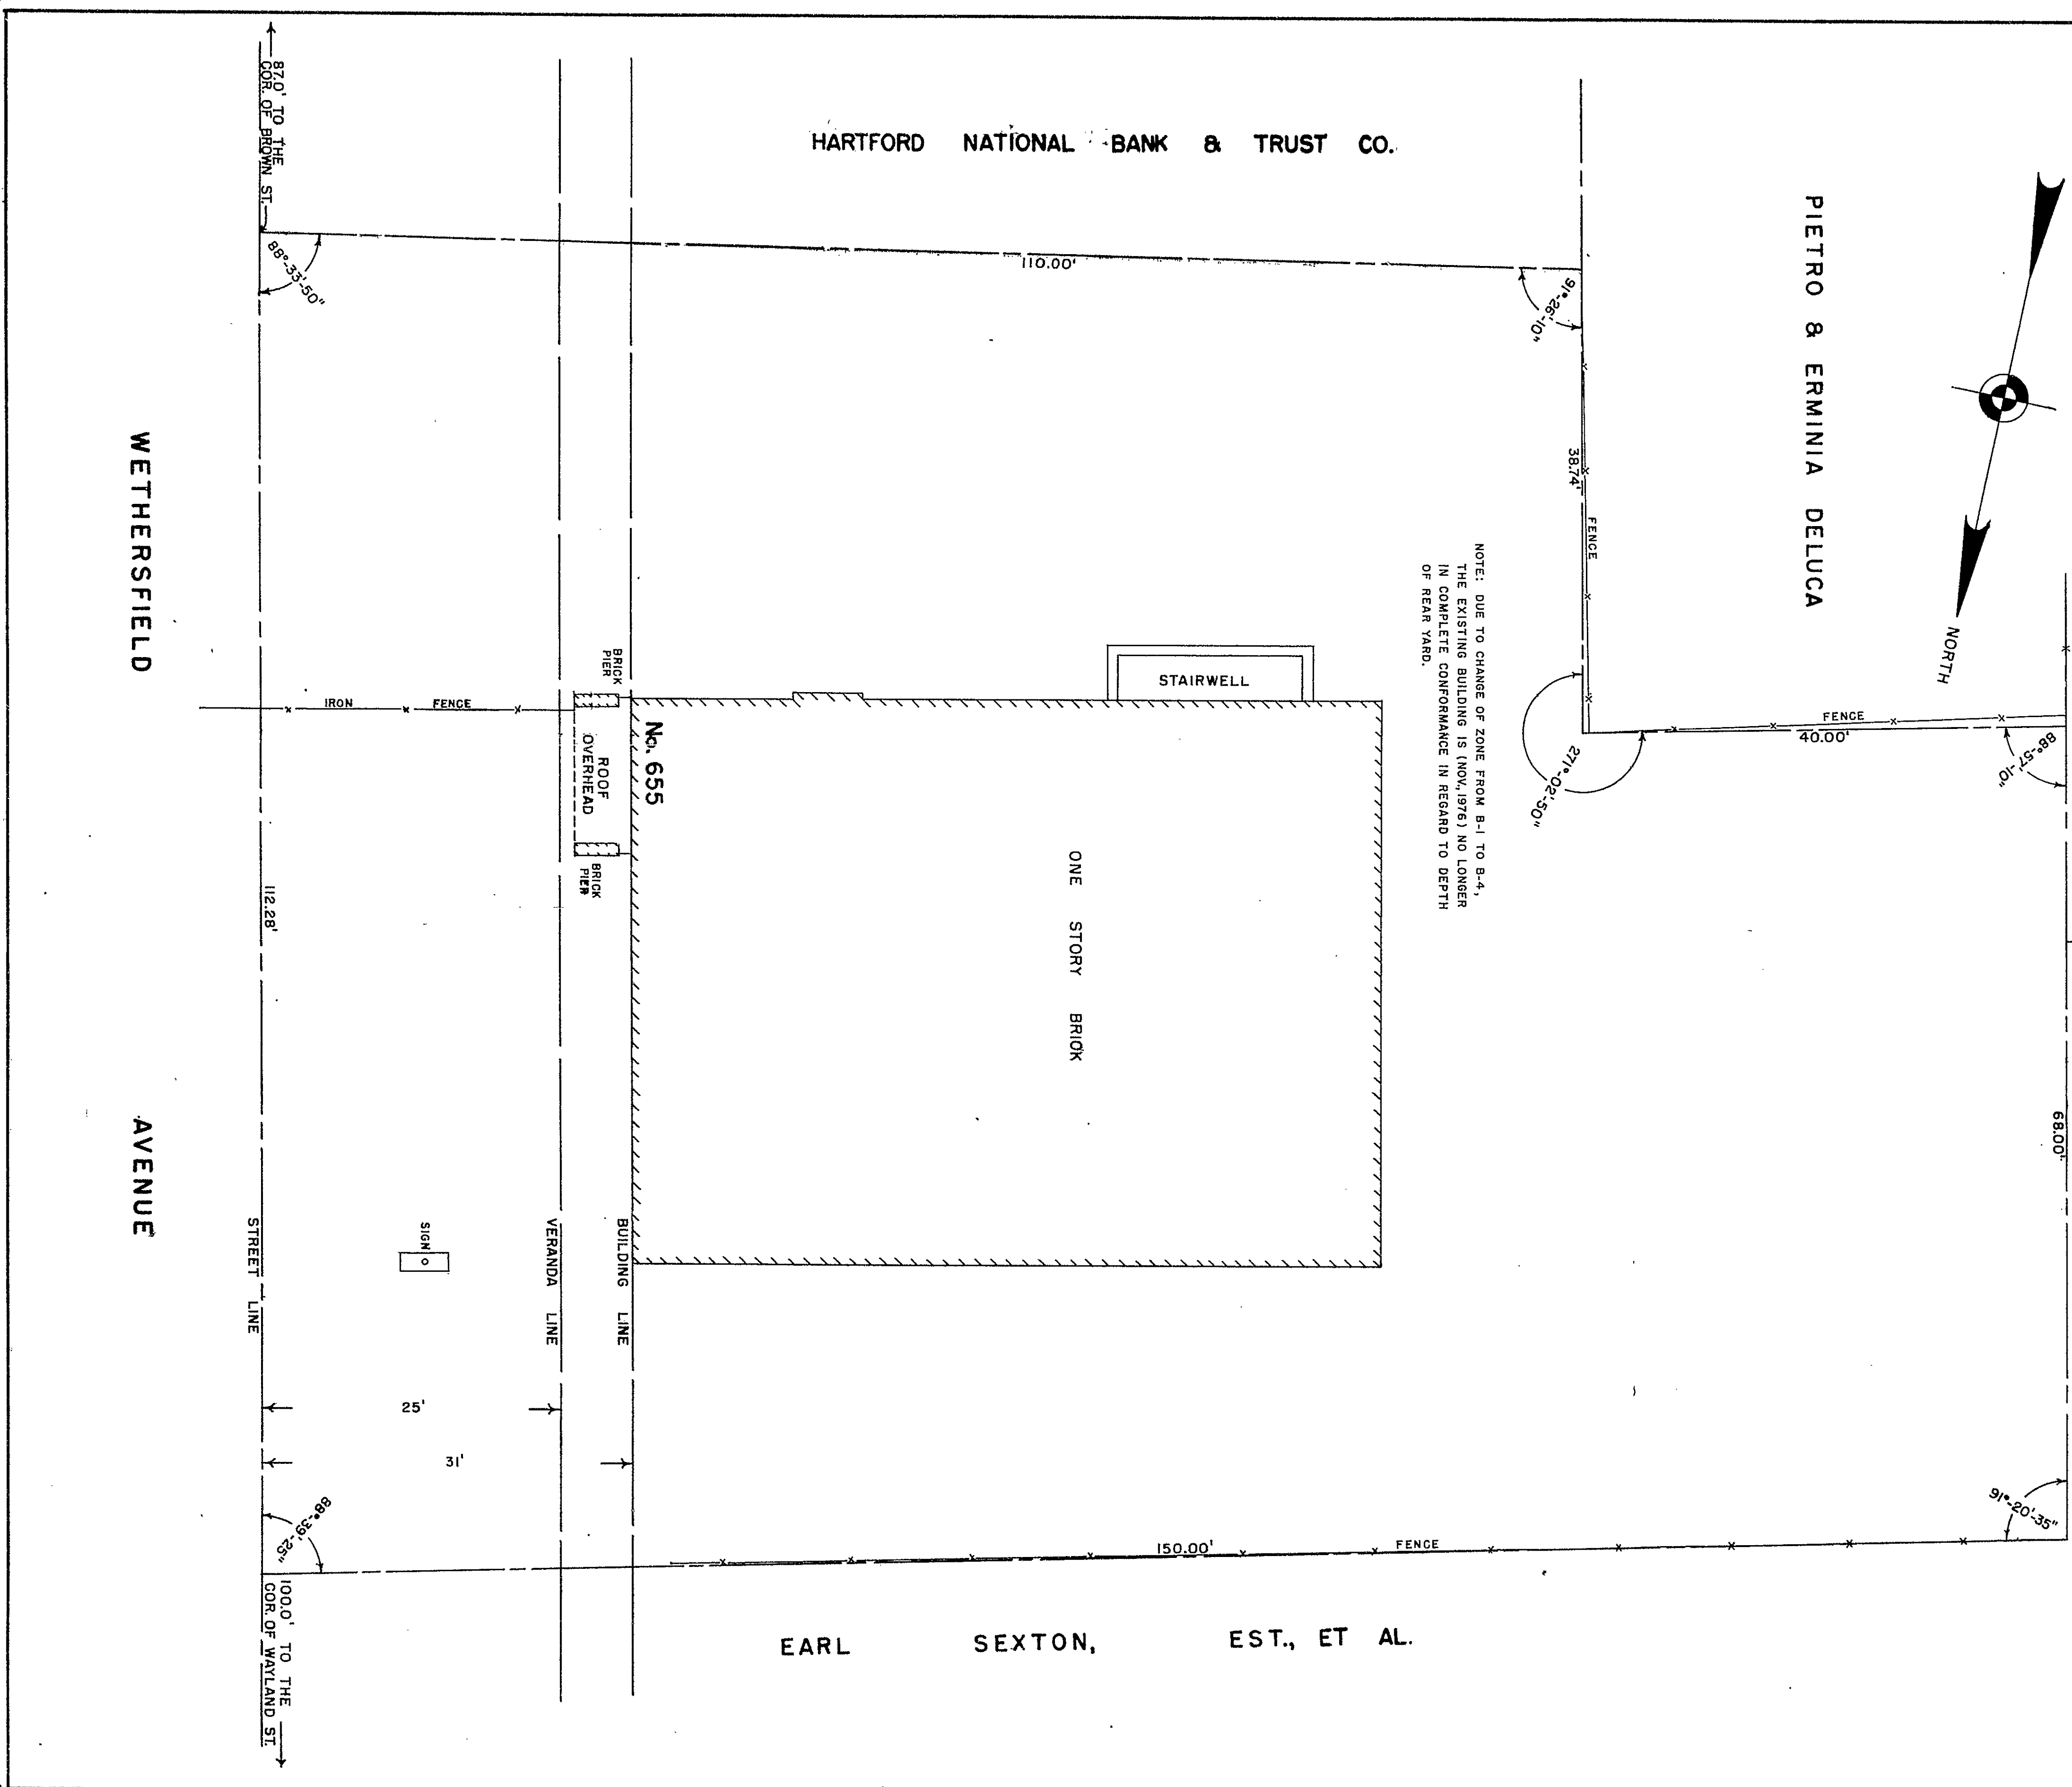

The portion of Wethersfield Avenue shown on this plan is an established public street of the City of Hartford.

Nov. 17, 1976

George L. Nelson
City Engineer

RECEIVED
NOV 16 2 34 PM '76
395405