

103

1031-1


12211:1311

EMMANUEL P. MORGAN, ET AL.
21 - 23 CARPENTER STREET

HARRIS (CORR)


SCALH: 1" = 30'

CONNECTICUT
APRIL 15, 1977

APRIL 15, 1977



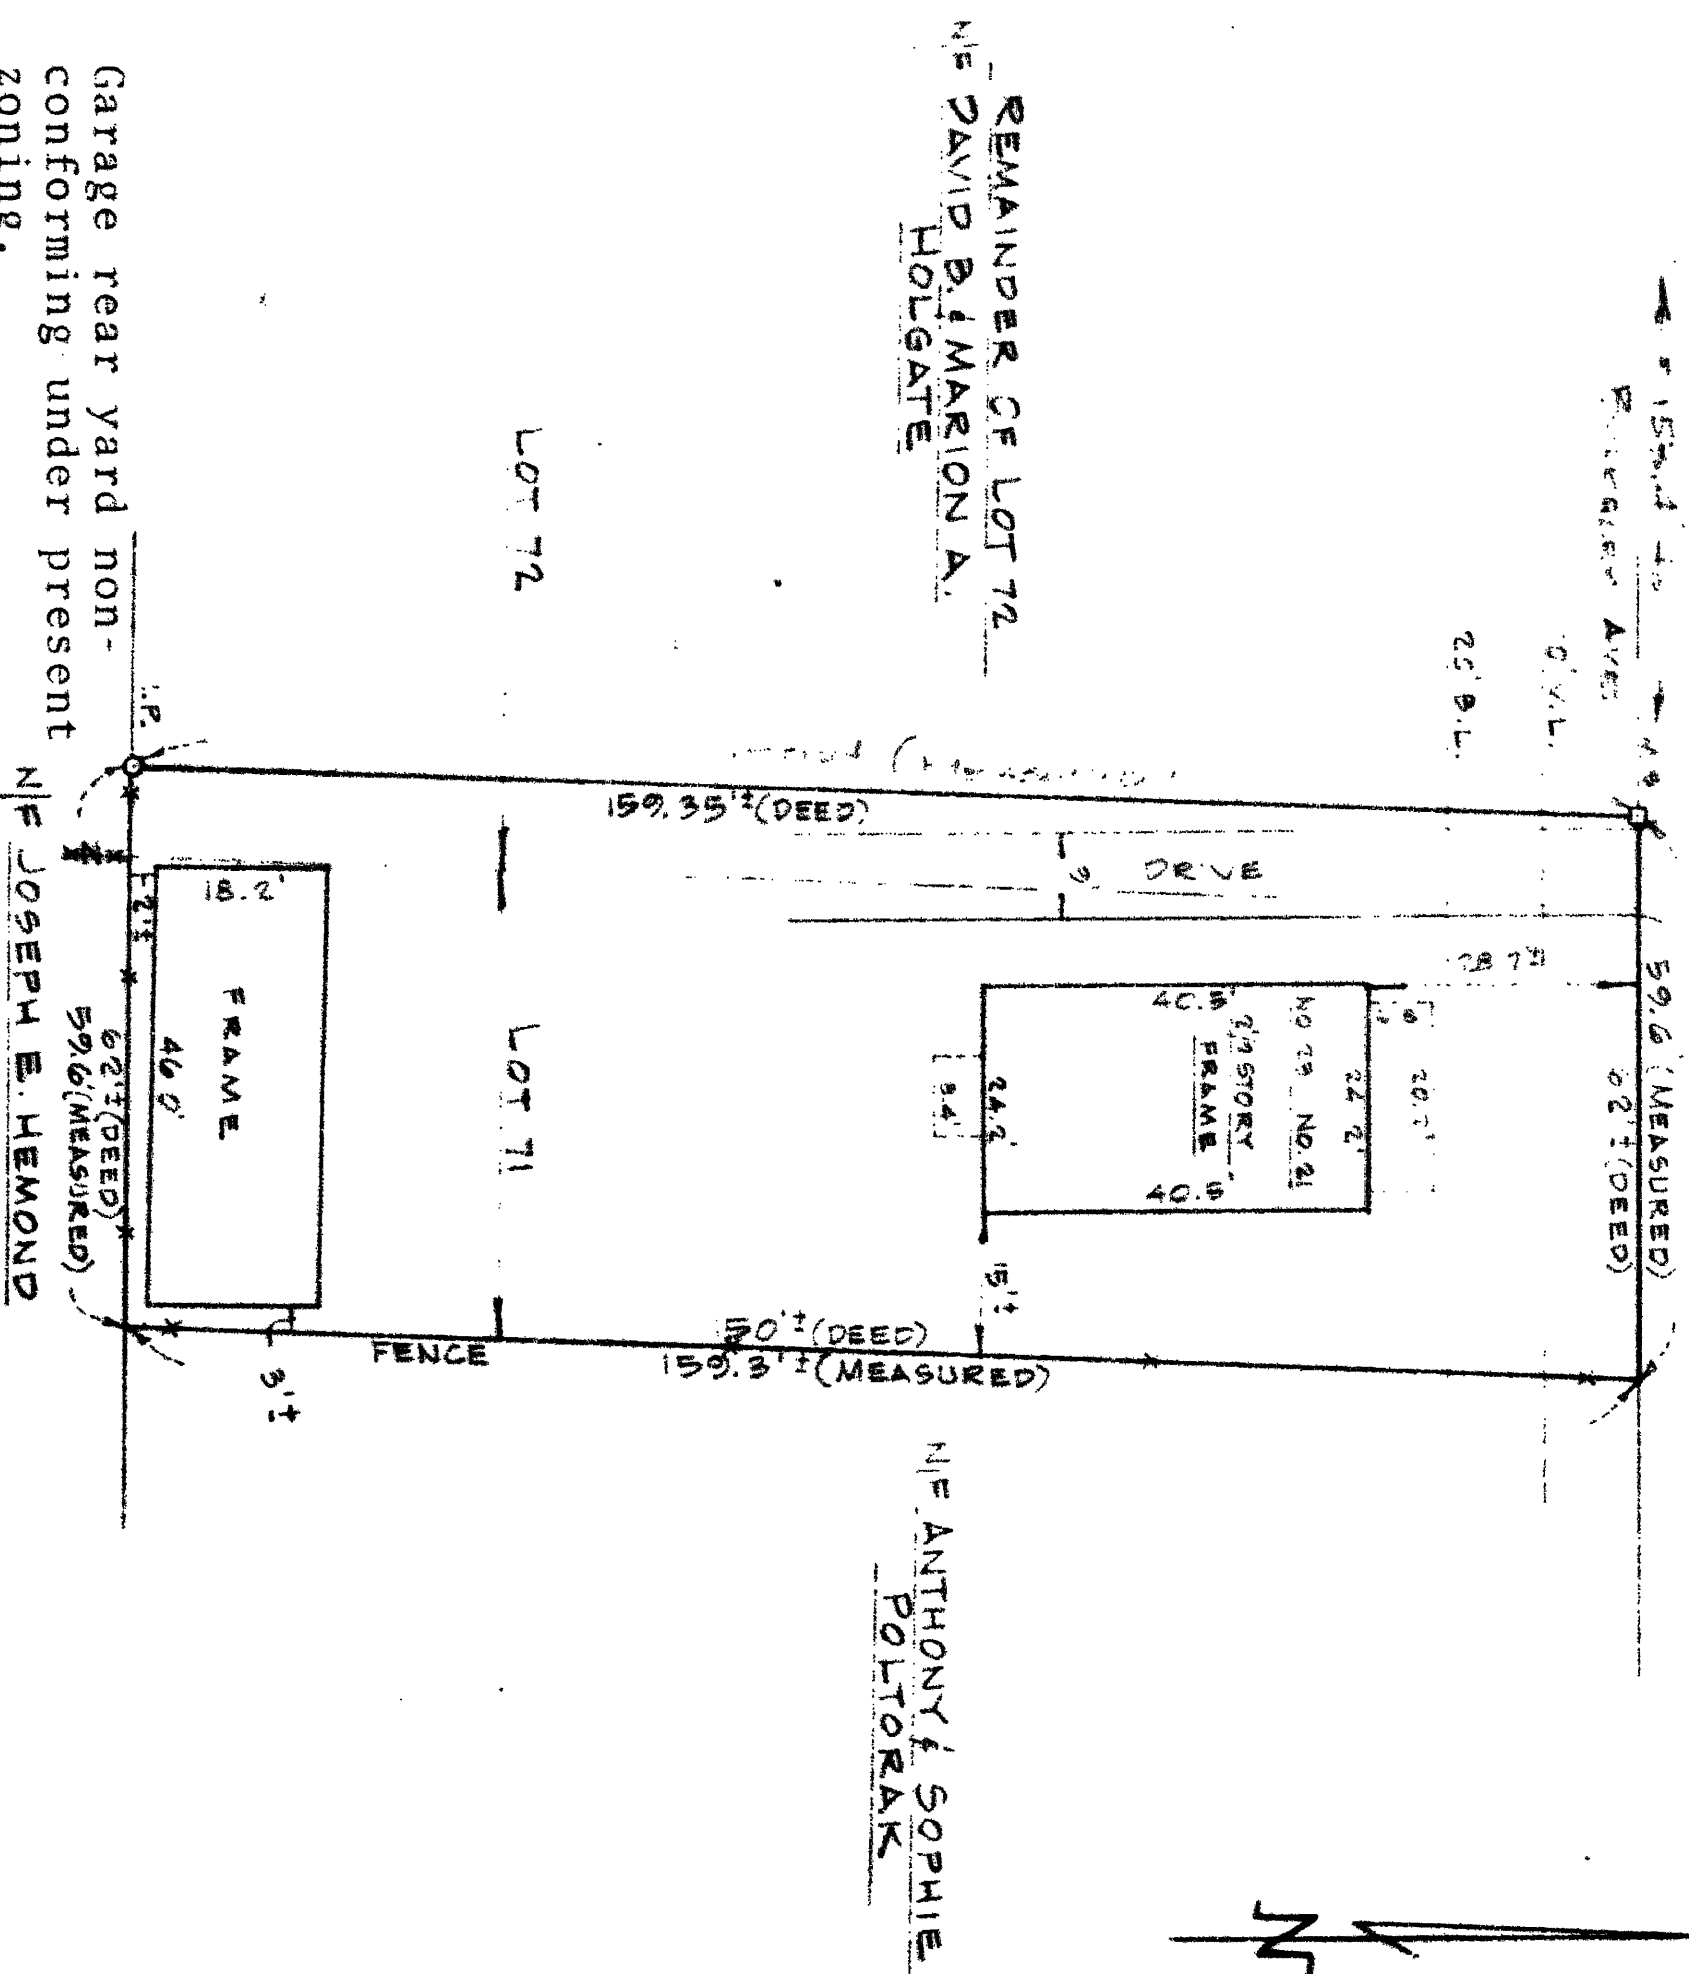

Garage rear yard non-conforming under present zoning.
Deeds do not agree with lines of possession shown hereon.

NOTE: Garage rear yard non-conforming under present zoning.



62'7"(DEED)
59'6"(MEASURED)

N/E JOSEPH E. HEMOND

I hereby certify to Hartford National Bank and Trust Company

that this map, which shows physical conditions existing at this date, is substantially correct, and that zoning regulations are not violated unless otherwise noted herein.

CLOSE, JENSEN & MILLER
Civil Engineers & Surveyors
By *[Signature]*

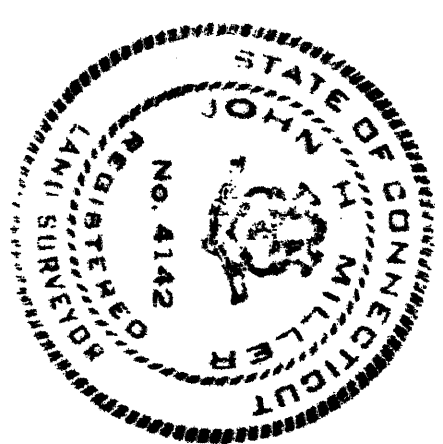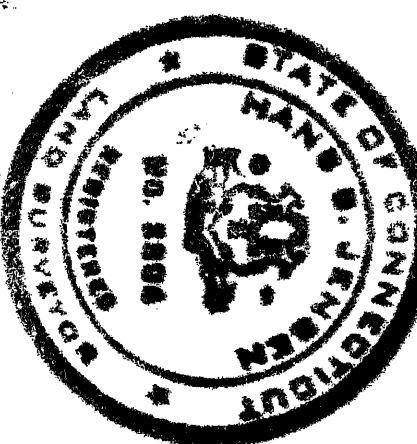

The portion of Carpenter Street shown on this plan is an established public street of the City of Hartford.

June 21, 1977

George E. Adams
City Engineer

RECEIVED
HARTFORD, CONN.
JUN 21 12 13 PM '73
ROBERT J. GALLIVAN
TOWN & CITY CLERK

10

