
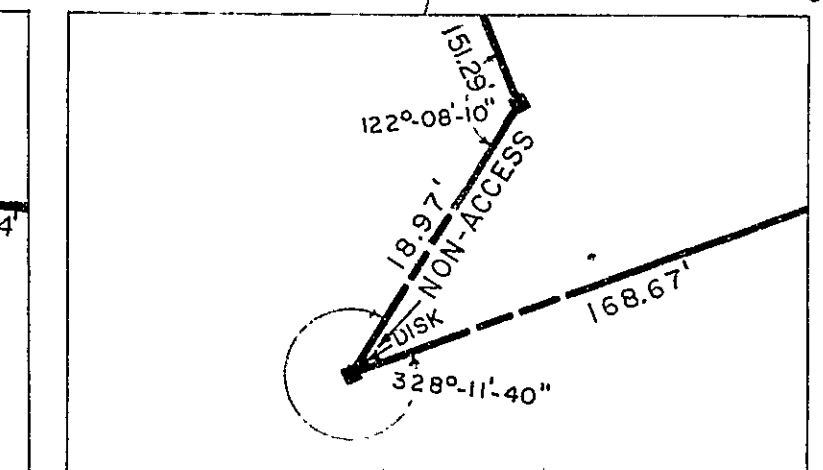
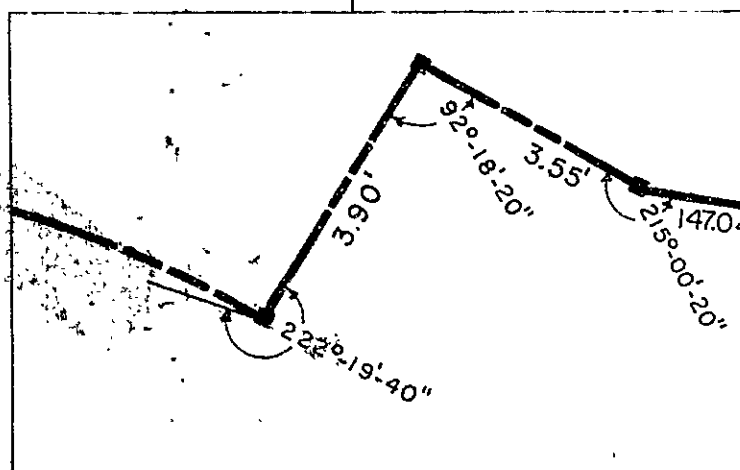
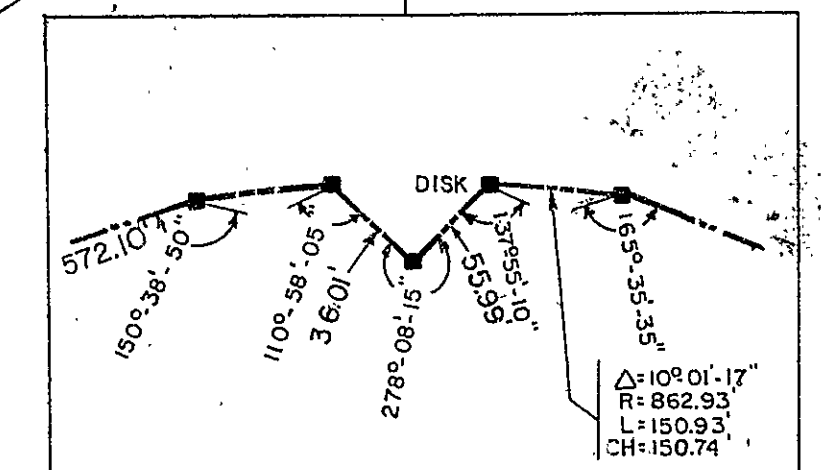
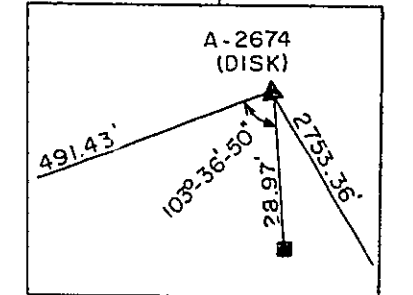
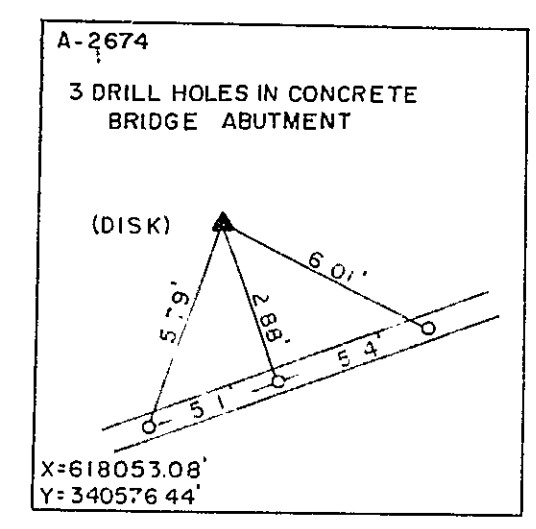
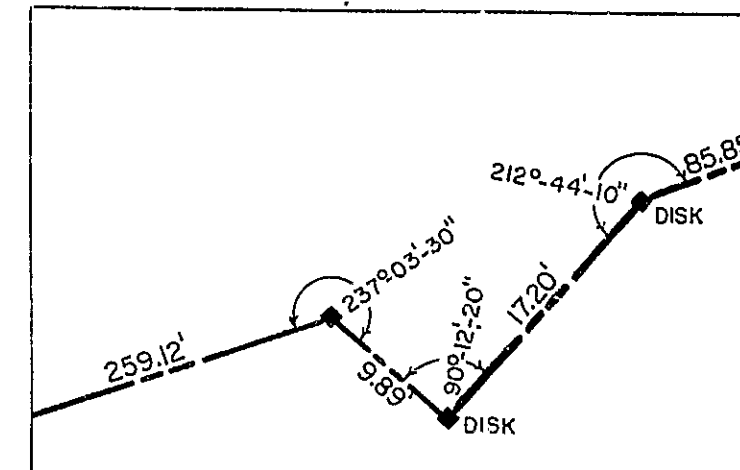


1032

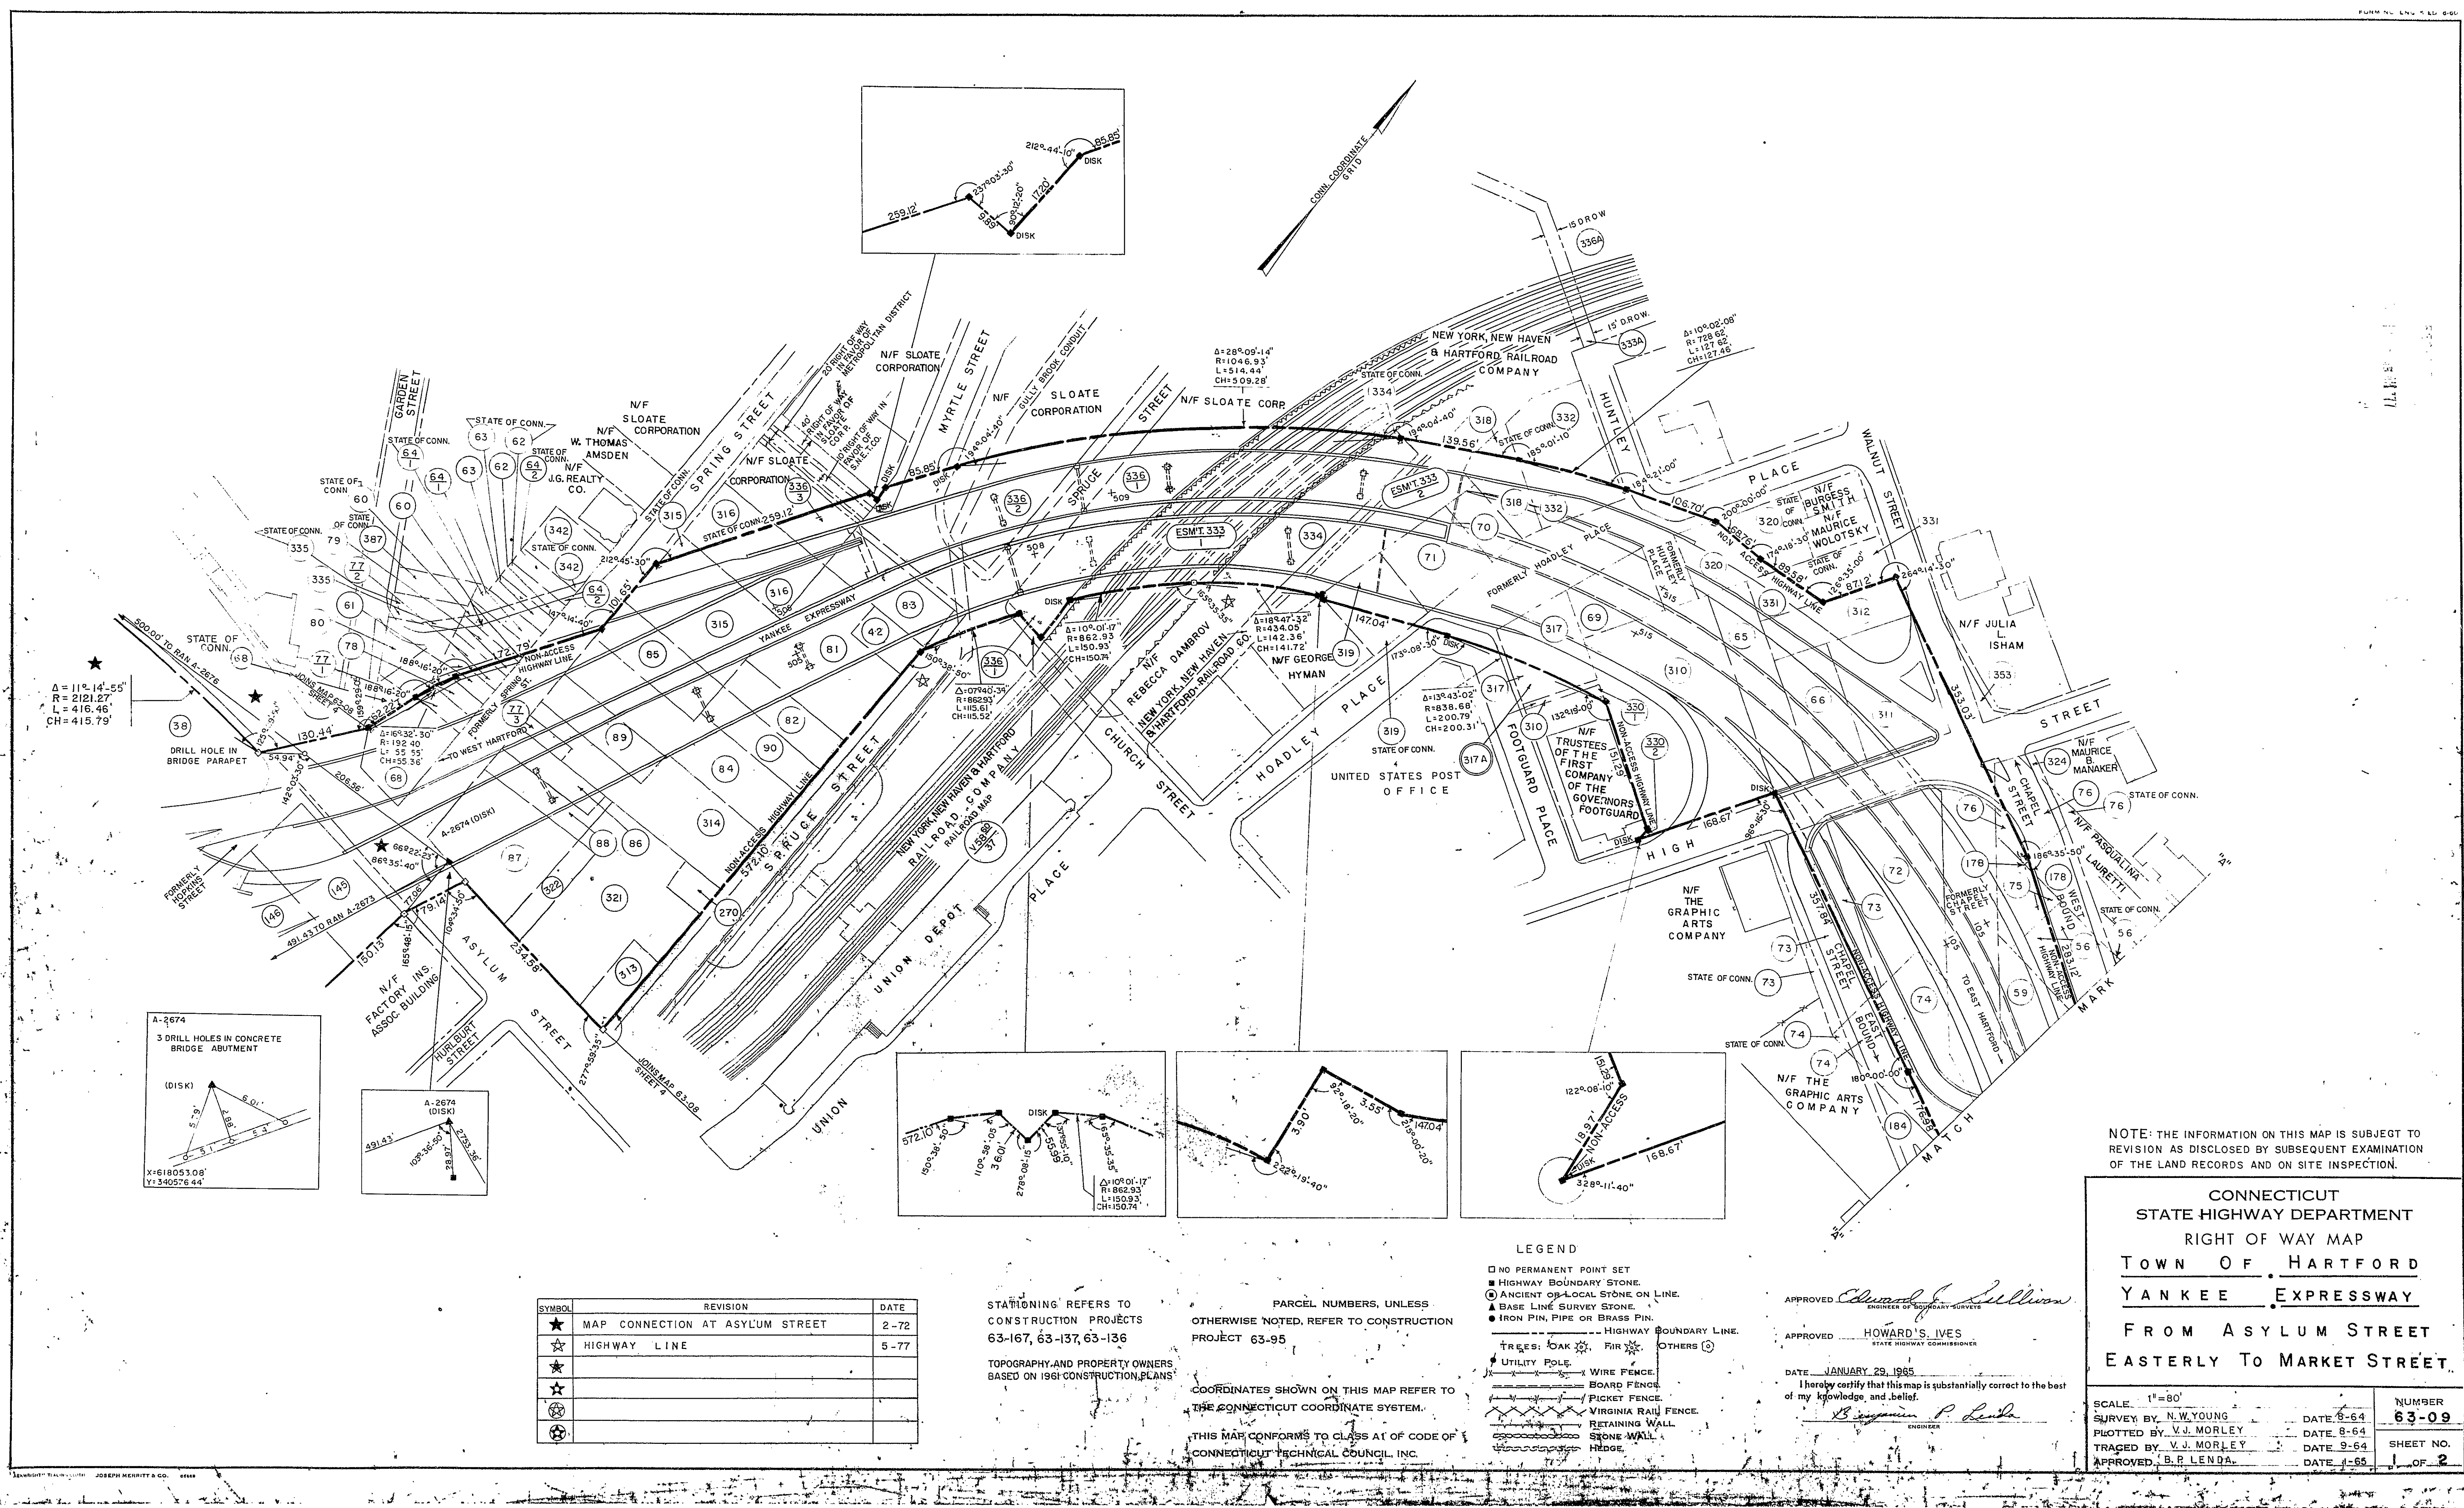

SYMBOL	REVISION	DATE
★	MAP CONNECTION AT ASYLUM STREET	2-72
☆	HIGHWAY LINE	5-77
☆		
☆		
☆		
☆		

STATIONING REFERS TO CONSTRUCTION PROJECTS 63-167, 63-137, 63-136

TOPOGRAPHY AND PROPERTY OWNERS BASED ON 1961 CONSTRUCTION PLANS

PARCEL NUMBERS, UNLESS OTHERWISE NOTED, REFER TO CONSTRUCTION PROJECT 63-95

COORDINATES SHOWN ON THIS MAP REFER TO THE CONNECTICUT COORDINATE SYSTEM.

THIS MAP CONFORMS TO CLASS A1 OF CODE OF CONNECTICUT TECHNICAL COUNCIL INC.

- LEGEND
- NO PERMANENT POINT SET
 - HIGHWAY BOUNDARY STONE
 - ANCIENT OR LOCAL STONE ON LINE
 - ▲ BASE LINE SURVEY STONE
 - IRON PIN, PIPE OR BRASS PIN
 - HIGHWAY BOUNDARY LINE
 - OTHERS
 - UTILITY POLE
 - WIRE FENCE
 - BOARD FENCE
 - PICKET FENCE
 - VIRGINIA RAIL FENCE
 - RETAINING WALL
 - STONE WALL

APPROVED *Edward J. Sullivan*
ENGINEER OF SURVEY

APPROVED *HOWARD S. IVES*
STATE HIGHWAY COMMISSIONER


I hereby certify that this map is substantially correct to the best of my knowledge and belief.


NOTE: THE INFORMATION ON THIS MAP IS SUBJECT TO REVISION AS DISCLOSED BY SUBSEQUENT EXAMINATION OF THE LAND RECORDS AND ON SITE INSPECTION.

CONNECTICUT
STATE HIGHWAY DEPARTMENT
RIGHT OF WAY MAP
TOWN OF HARTFORD
YANKEE EXPRESSWAY
FROM ASYLUM STREET
EASTERLY TO MARKET STREET

SCALE: 1"=80'

SURVEY BY: N.W. YOUNG DATE: 8-64
PLOTTED BY: V.J. MORLEY DATE: 8-64
TRACED BY: V.J. MORLEY DATE: 9-64
APPROVED: B.R. LINDA DATE: 1-65

NUMBER: 63-09
SHEET NO. 1 OF 2