

1034



UNION PLACE

CHURCH STREET

STREET


PROPERTY OF
REYNARD REAL ESTATE INVESTORS

UNION PLACE & CHURCH STREET
HARTFORD, CONNECTICUT

SCALE: 1 INCH = 10 FEET

JUNE, 1977

PETERSEN & HOFFMAN
LAND SURVEYORS
SUCCESSORS TO SPENCER & WASHBURN, INC.

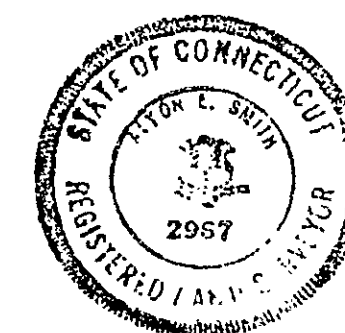

TO REYNARD REAL ESTATE INVESTORS, THE
CONNECTICUT BANK AND TRUST COMPANY, CON-
NECTICUT GENERAL LIFE INSURANCE COMPANY,
AND LAWYERS TITLE INSURANCE CORPORATION:
I hereby certify that this survey and the bounds and
measurements shown hereon are substantially correct;
that the lines shown hereon and the lines of actual
possession are the same; that the buildings are located
as shown and do not encroach upon or violate any
or building lines, except as shown hereon; and that there
are no violations of zoning ordinances, restrictions
or other rules and regulations in respect to the
location of said buildings; and that there are no
easements or encroachments affecting this property
apparent from a careful inspection of the same, other
than those shown and depicted hereon.
CLASS A-1 SURVEY.

Alton E. Smith


The portions of Union Place and Church Street
shown on this plan are established public streets
of the City of Hartford.

June 30, 1977

George E. Hoffman
City Engineer

RECEIVED
HARTFORD, CONN.
JUN 29 3 48 PM '77
FORWARDED TO
TOWN CLERK

103359-701363

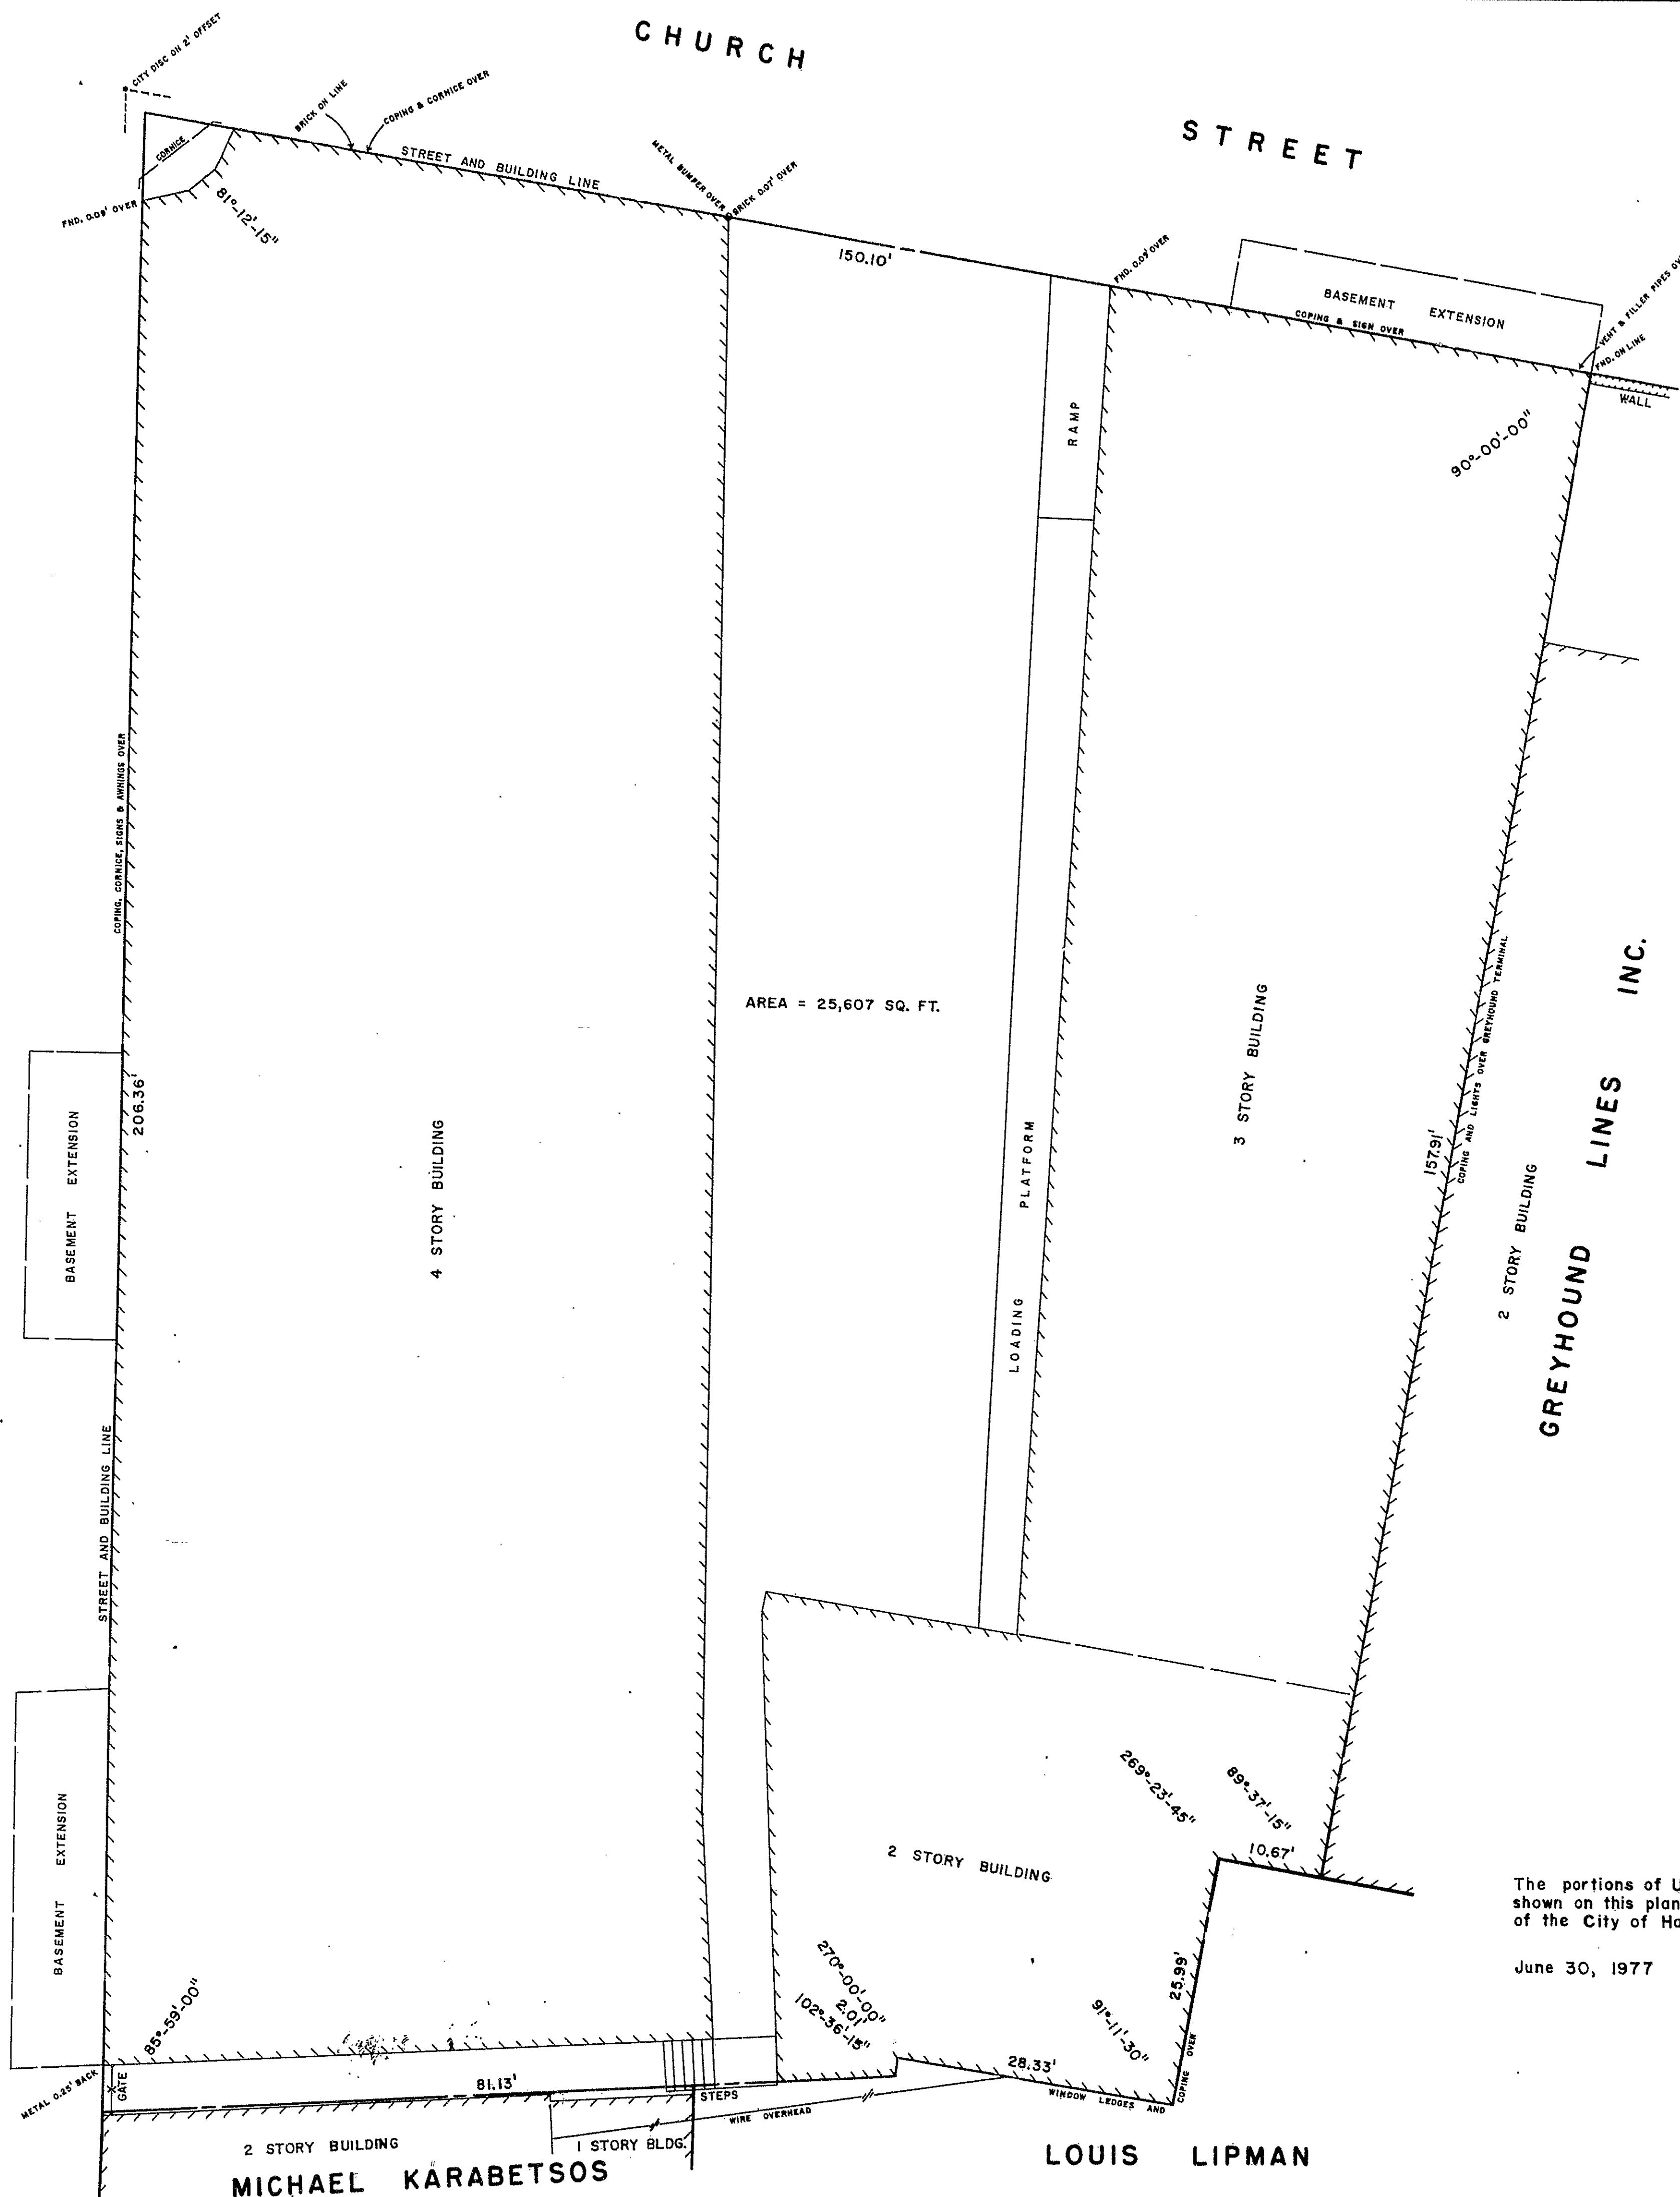

MICHAEL KARABETSOS

LOUIS LIPMAN

