



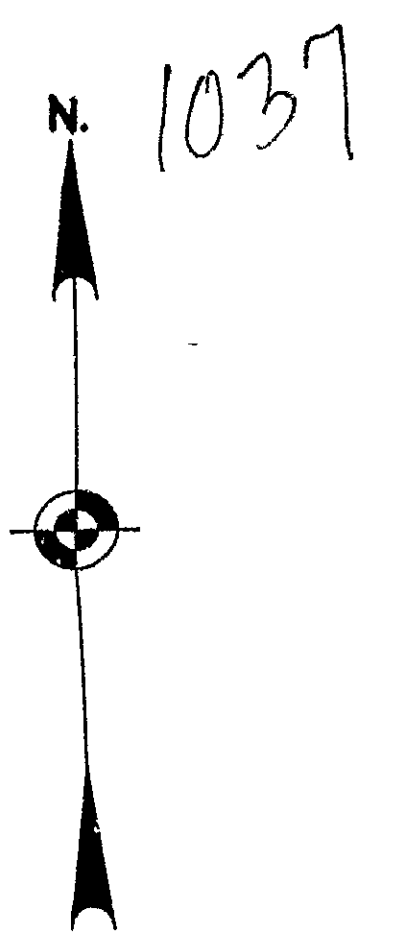

RECEIVED
HARTFORD, CT.
SEP 13 3 13 PM '77
ROBERT L. ALLAN
TOWN CLERK

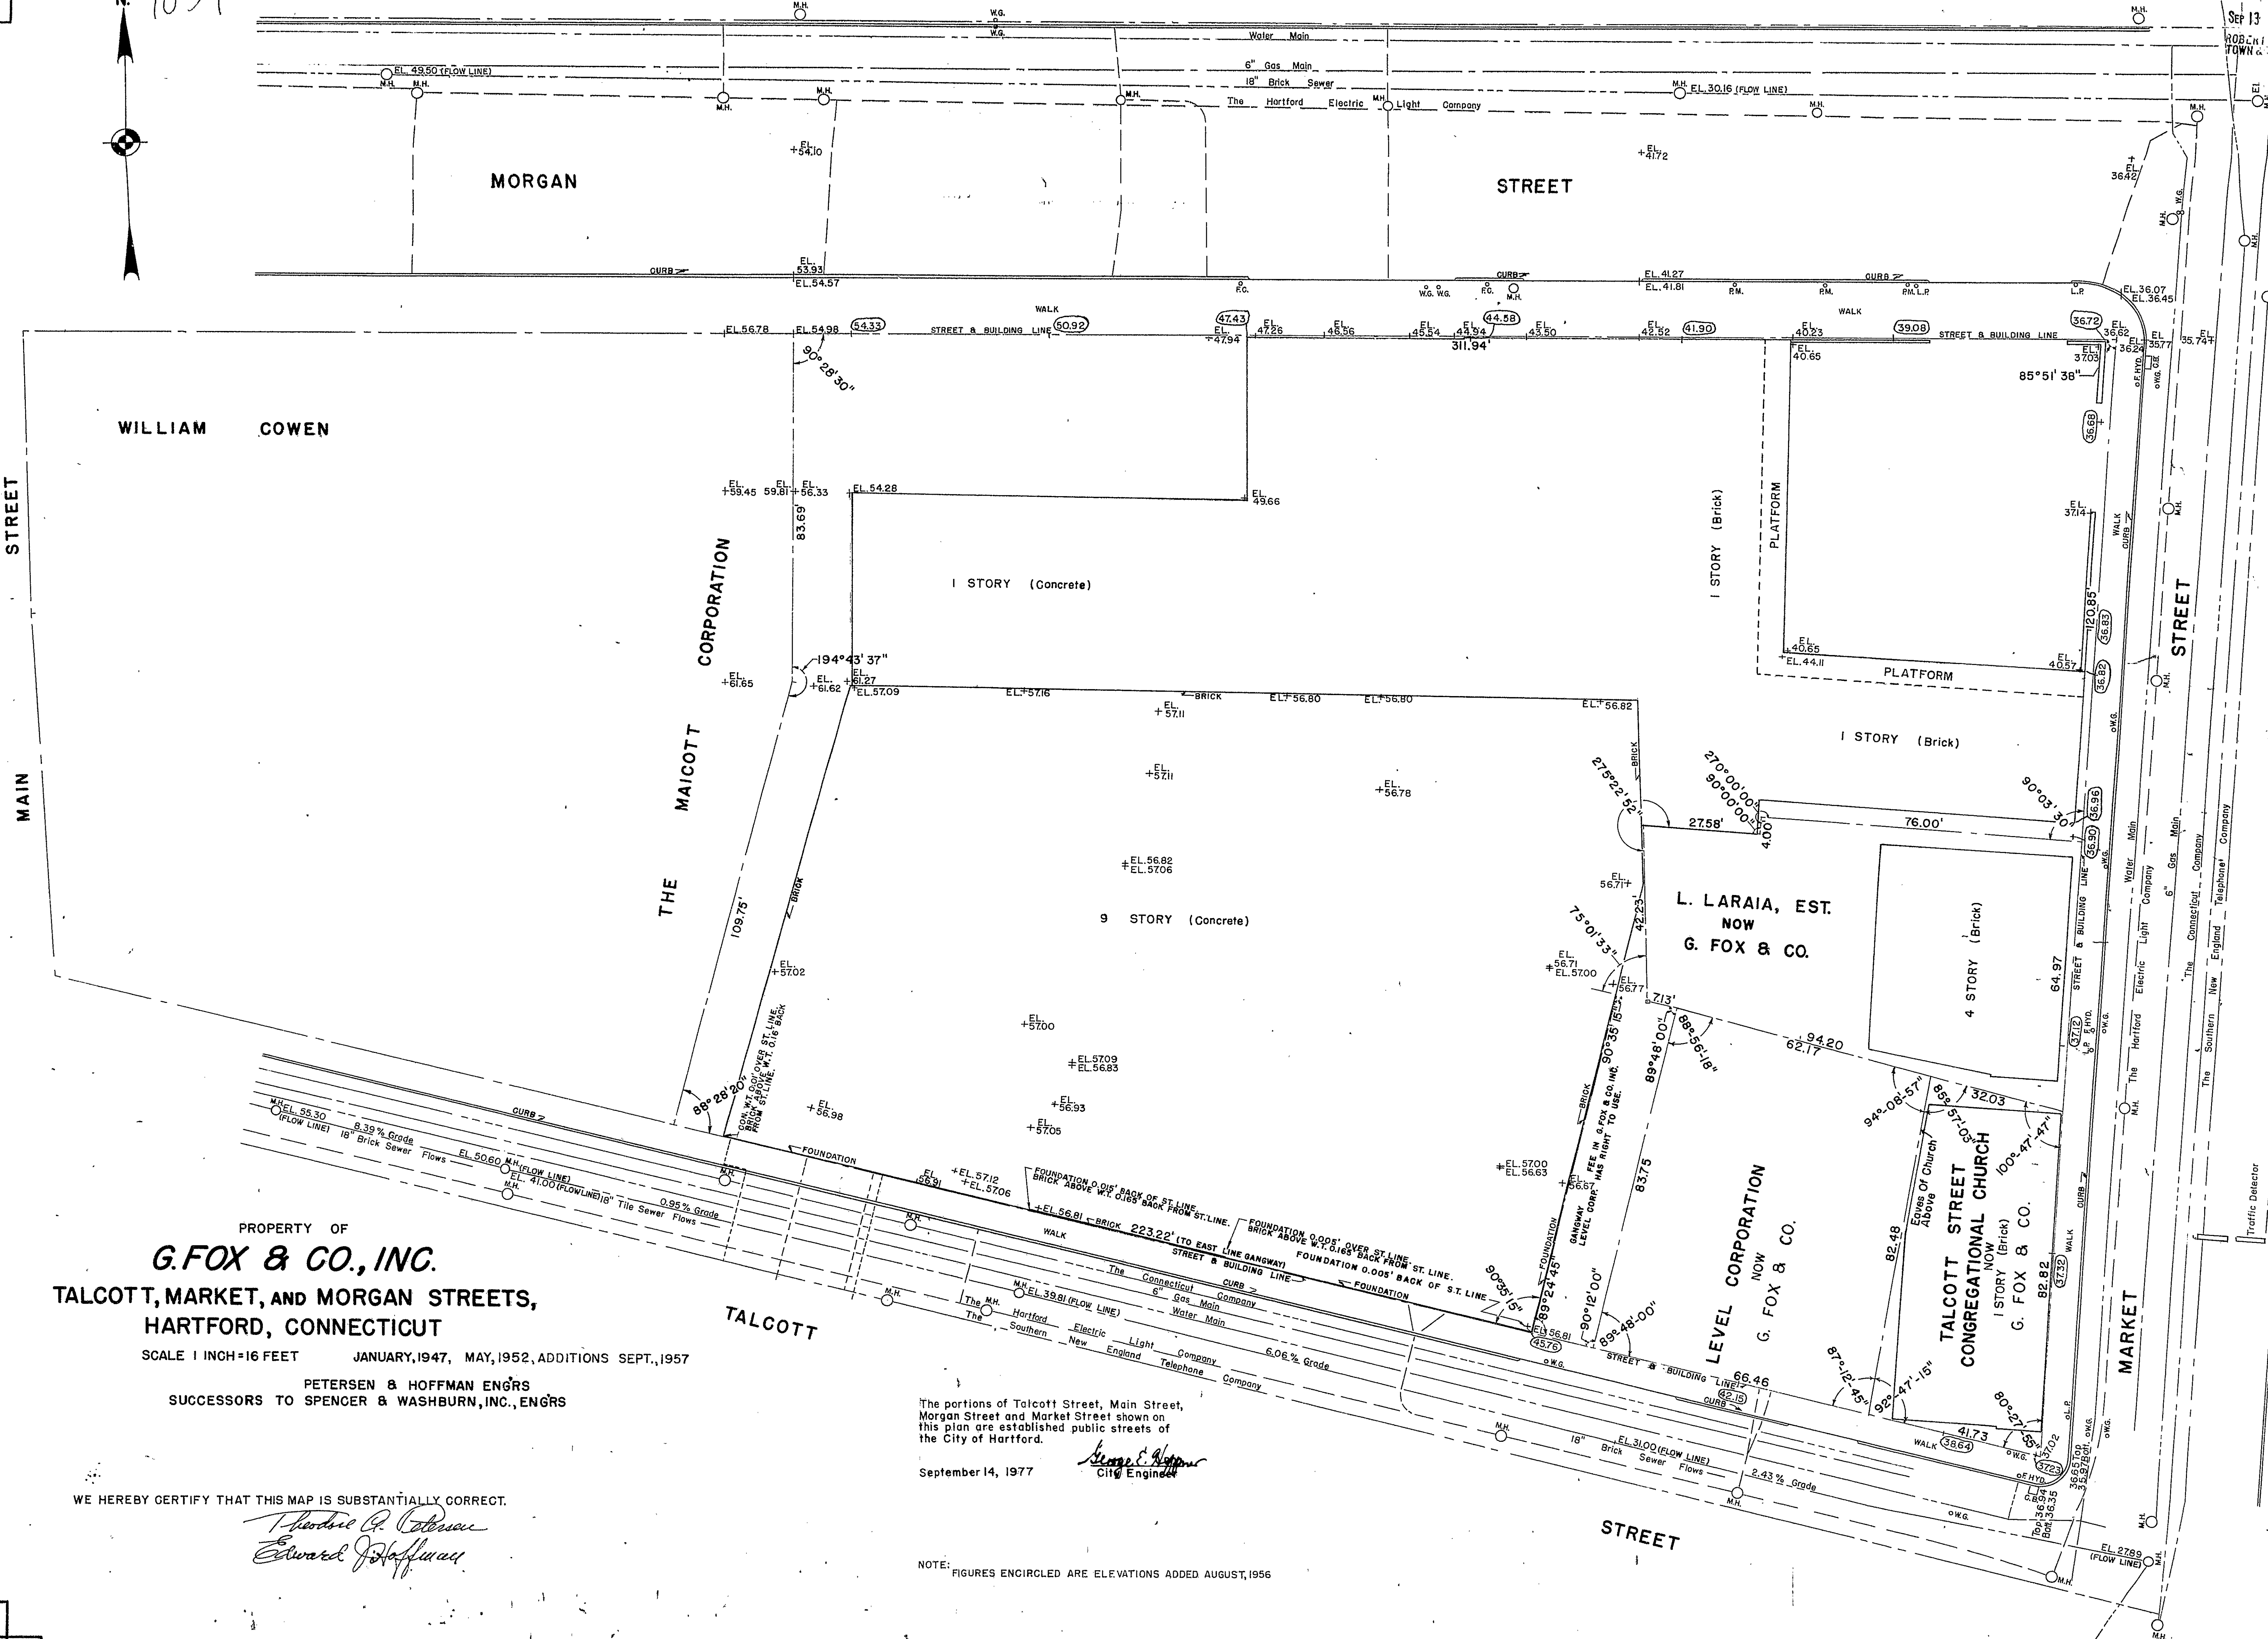

PROPERTY OF
G. FOX & CO., INC.
TALCOTT, MARKET, AND MORGAN STREETS,
HARTFORD, CONNECTICUT
SCALE 1 INCH=16 FEET JANUARY, 1947, MAY, 1952, ADDITIONS SEPT., 1957
PETERSEN & HOFFMAN ENGRS
SUCCESSORS TO SPENCER & WASHBURN, INC., ENGRS

WE HEREBY CERTIFY THAT THIS MAP IS SUBSTANTIALLY CORRECT.
Frederic C. Petersen
Edward J. Hoffman

The portions of Talcott Street, Main Street,
Morgan Street and Market Street shown on
this plan are established public streets of
the City of Hartford.
September 14, 1977
George E. Hoffman
City Engineer

NOTE: FIGURES ENCIRCLED ARE ELEVATIONS ADDED AUGUST, 1956

0 INCHES 1 2 3 4