


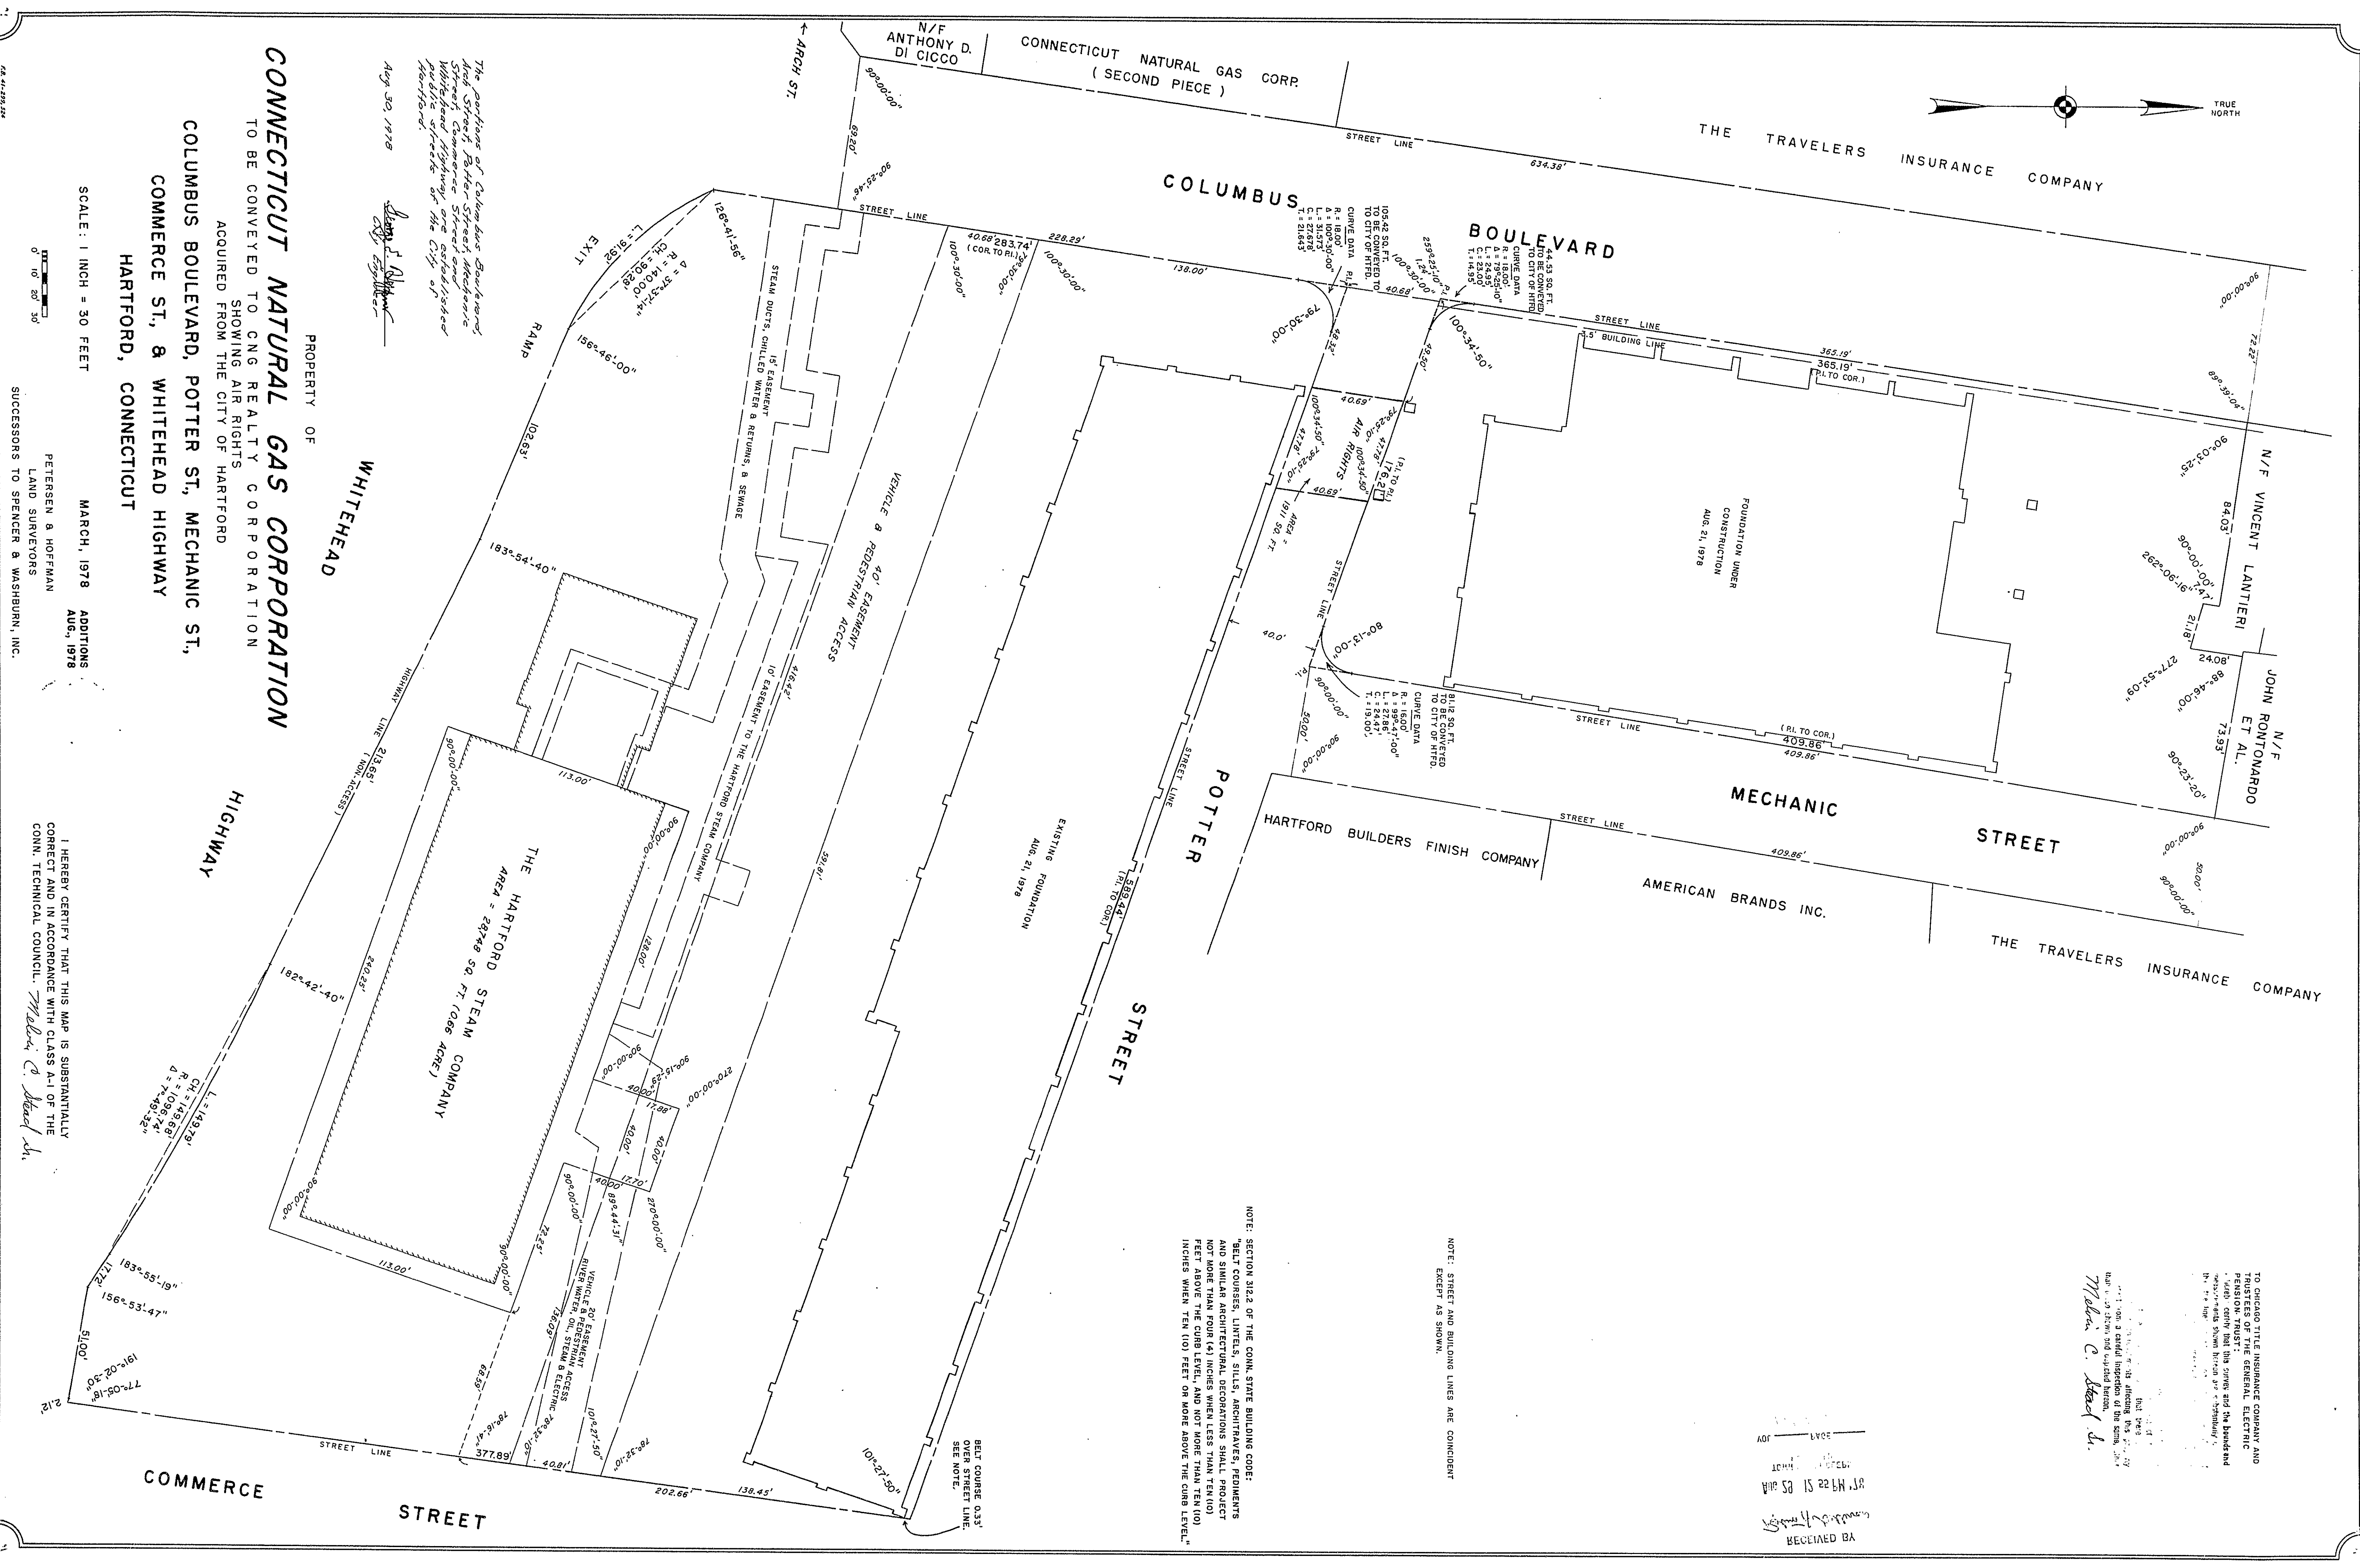

TO CHICAGO TITLE INSURANCE COMPANY AND  
TRUSTEES OF THE GENERAL ELECTRIC  


NOTE: STREET AND BUILDING LINES ARE CONCURRENT  
EXCEPT AS SHOWN.

NOTE: SECTION 31.2 OF THE CONN. STATE BUILDING CODE:  
INCHES WHEN TEN (10) FEET OR MORE ABOVE THE CURB LEVEL.

NOTE: BELT COURSE 0.33'  
SEE NOTE.

PROPERTY OF  
**CONNECTICUT NATURAL GAS CORPORATION**  
TO BE CONVEYED TO CNG REALTY CORPORATION  
ACQUIRED FROM THE CITY OF HARTFORD  
COLUMBUS BOULEVARD, POTTER ST., MECHANIC ST.,  
COMMERCE ST., & WHITEHEAD HIGHWAY  
HARTFORD, CONNECTICUT

The portions of Columbus Boulevard,  

City Engineer

SCALE: 1 INCH = 30 FEET  
MARCH, 1978 ADDITIONS  
AUG., 1978  
PETERSEN & HOFFMAN  
LAND SURVEYORS  
SUCCESSORS TO SPENCER & WASHBURN, INC.

I HEREBY CERTIFY THAT THIS MAP IS SUBSTANTIALLY  
CORRECT AND IN ACCORDANCE WITH CLASS A-1 OF THE  
CONN. TECHNICAL COUNCIL. *Melvin C. Hoffmann*