


1049

TO HARTFORD FEDERAL SAVINGS AND
LOAN ASSOCIATION:
CERTIFIED SUBSTANTIALLY CORRECT
AND NO ZONING REGULATIONS HAVE
BEEN VIOLATED.



William J. Kozlowski
SURVEYOR

MORTGAGE SURVEY
PROPERTY OF
BETTY JEAN FREEMAN
GENEVA MCLAGGON
57-59 KENT STREET
HARTFORD CONN.

AUGUST 1978 SCALE 1" = 20'

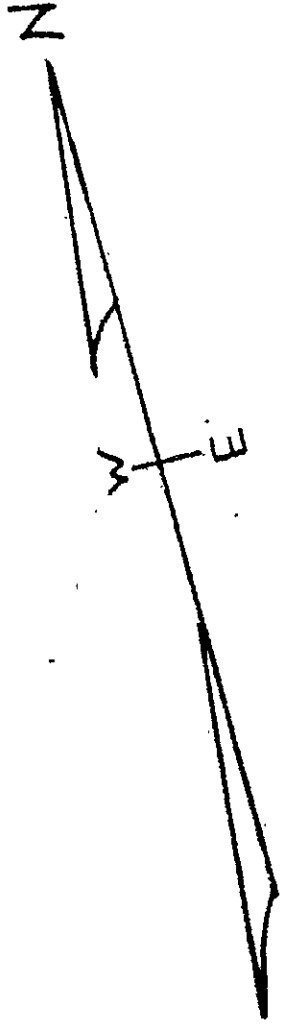

EASI FILE CORP. IRVINE, CA	
1049	
EFH 34	

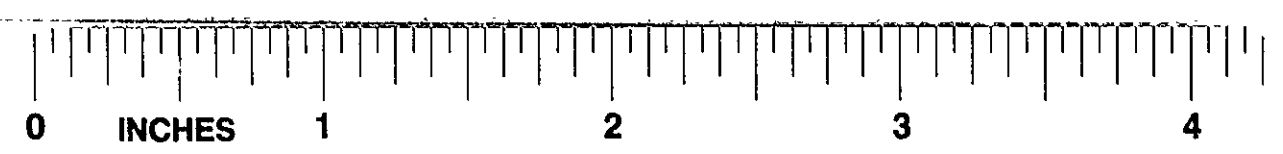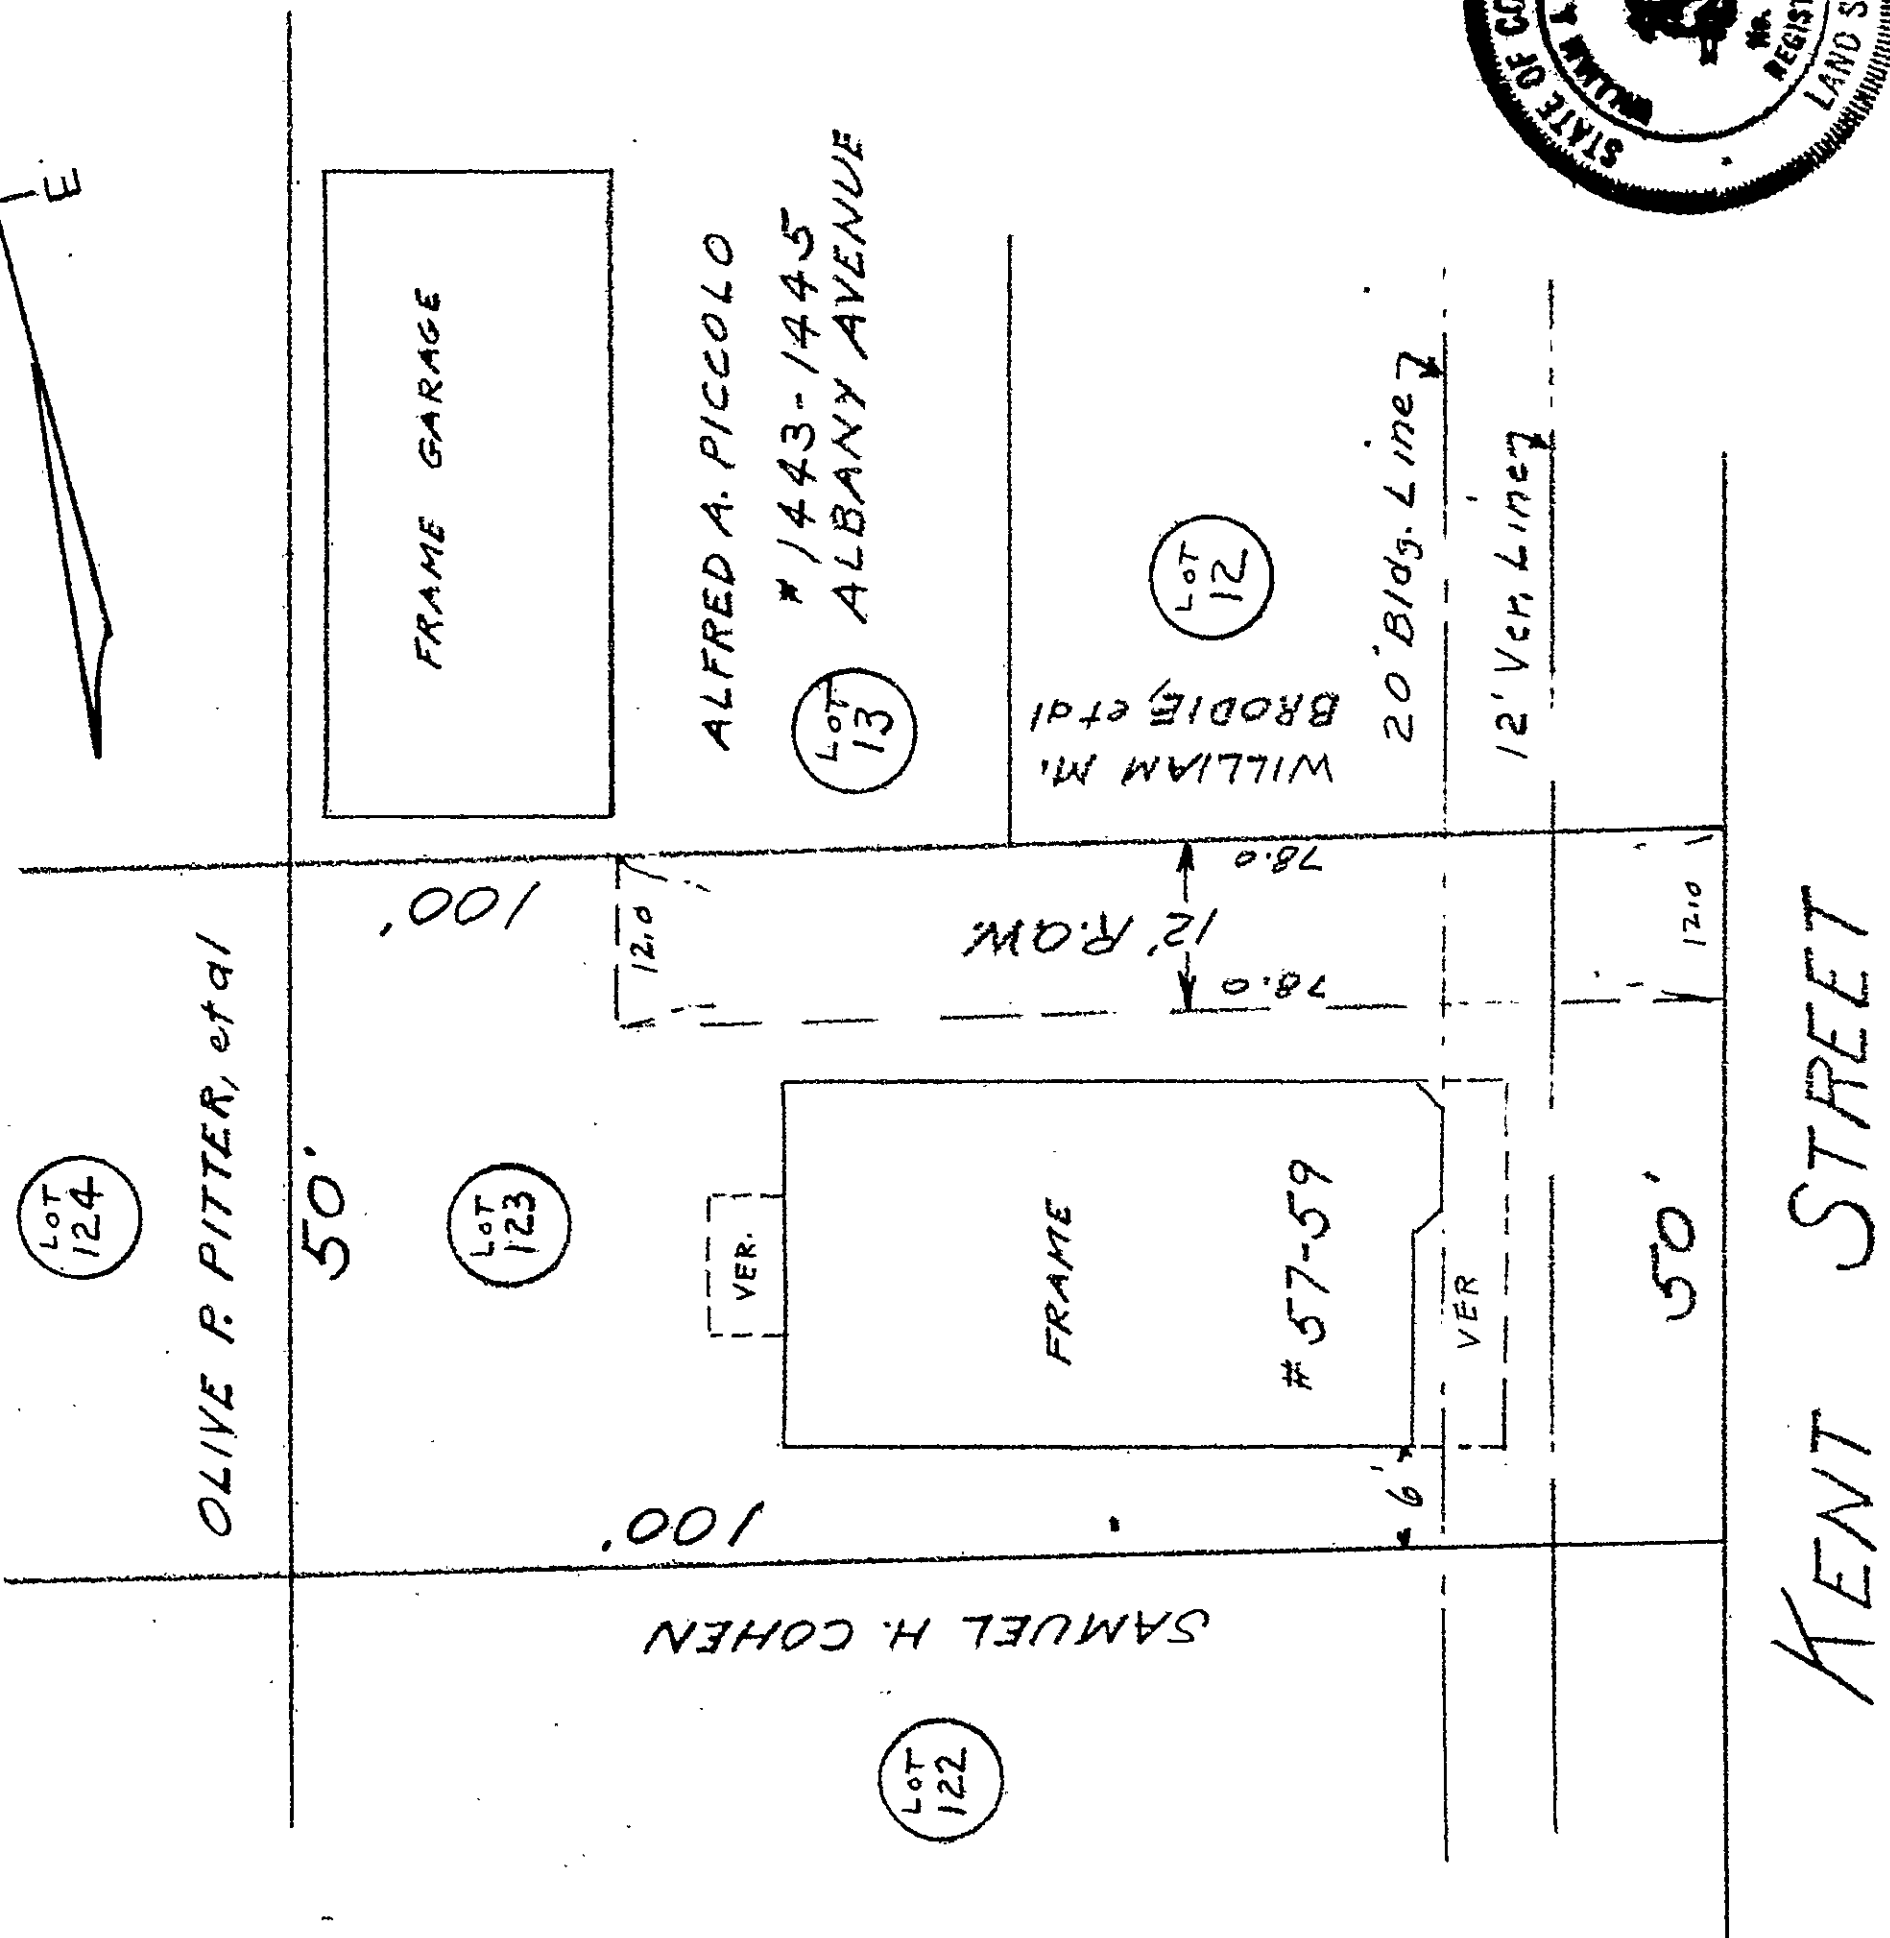

RECEIVED BY
Robert J. Ball...
AUG 17 1 08 PM '78
TOWN: DEPT.
VOL. _____ PAGE _____