

1049-2

EASI FILE CORP IRVINE CA

EPH 34

1049

I hereby certify to the Colonial Bank of Hartford and to the COMMONWEALTH LAND TITLE INSURANCE COMPANY that this survey was actually made upon the ground May 19, 1978, and that it and the bounds and measurements shown hereon are correct within the standards of Class A-2 of the Code of the Technical Council, Inc., and that unless otherwise shown, title lines of actual possession are the same, buildings are located as shown and do not encroach over or upon street, title or building lines, there are no violations of zoning regulations with reference to the location of said buildings, and there are no easements or encroachments affecting this property apparent from a careful inspections of the same.

John J. Lawrence, Jr., L.S.  
John J. Lawrence, Jr., L.S.

NF GEORGE F. CASTRO NF EITH L. READER

MORTGAGE SURVEY  
PROPERTY OF  
LUIGI & JONES  
GANSIRACUSA  
445-437  
FRANKLIN AVE  
HARTFORD, CT.  
MAY 19 1978

FEUCE IN # OUT ALONG  
PROPERTY LINE

NF GRECA BROS. REAL ESTATE

HELICO  
O.M.H.

RAIN

07x14 TYPICAL


445-437  
(ONE STORY BRICK)

MAP REF.: "PROPERTY OF  
RICHARD STEGLER,  
FRANKLIN AVE, HARTFORD,  
CONN. SCALE 1"=30'  
REC. 10, 1941."

NORTH  
ZONE 14-4

FRANKLIN AVE.

109.14 TO  
BROWN ST.  
LIGHT POLE  
EUGENES  
+ BOPE (16' x 11' x 8' 6")  
+ 11' x 8' 6"

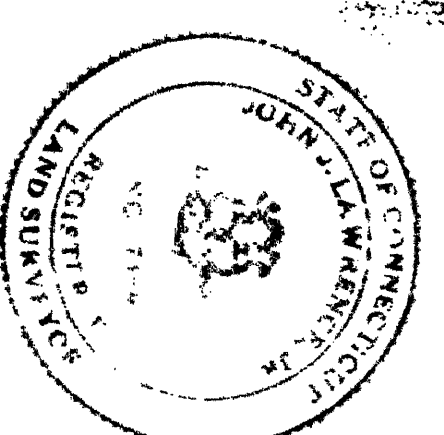

PAGE 1

RECEIVED BY  
14/1550  
JUN 27 10 19 AM '78



18-A 153 0 6301