


EASI FILE CORP. IRVINE, CA EPH 34
1063

1063-2

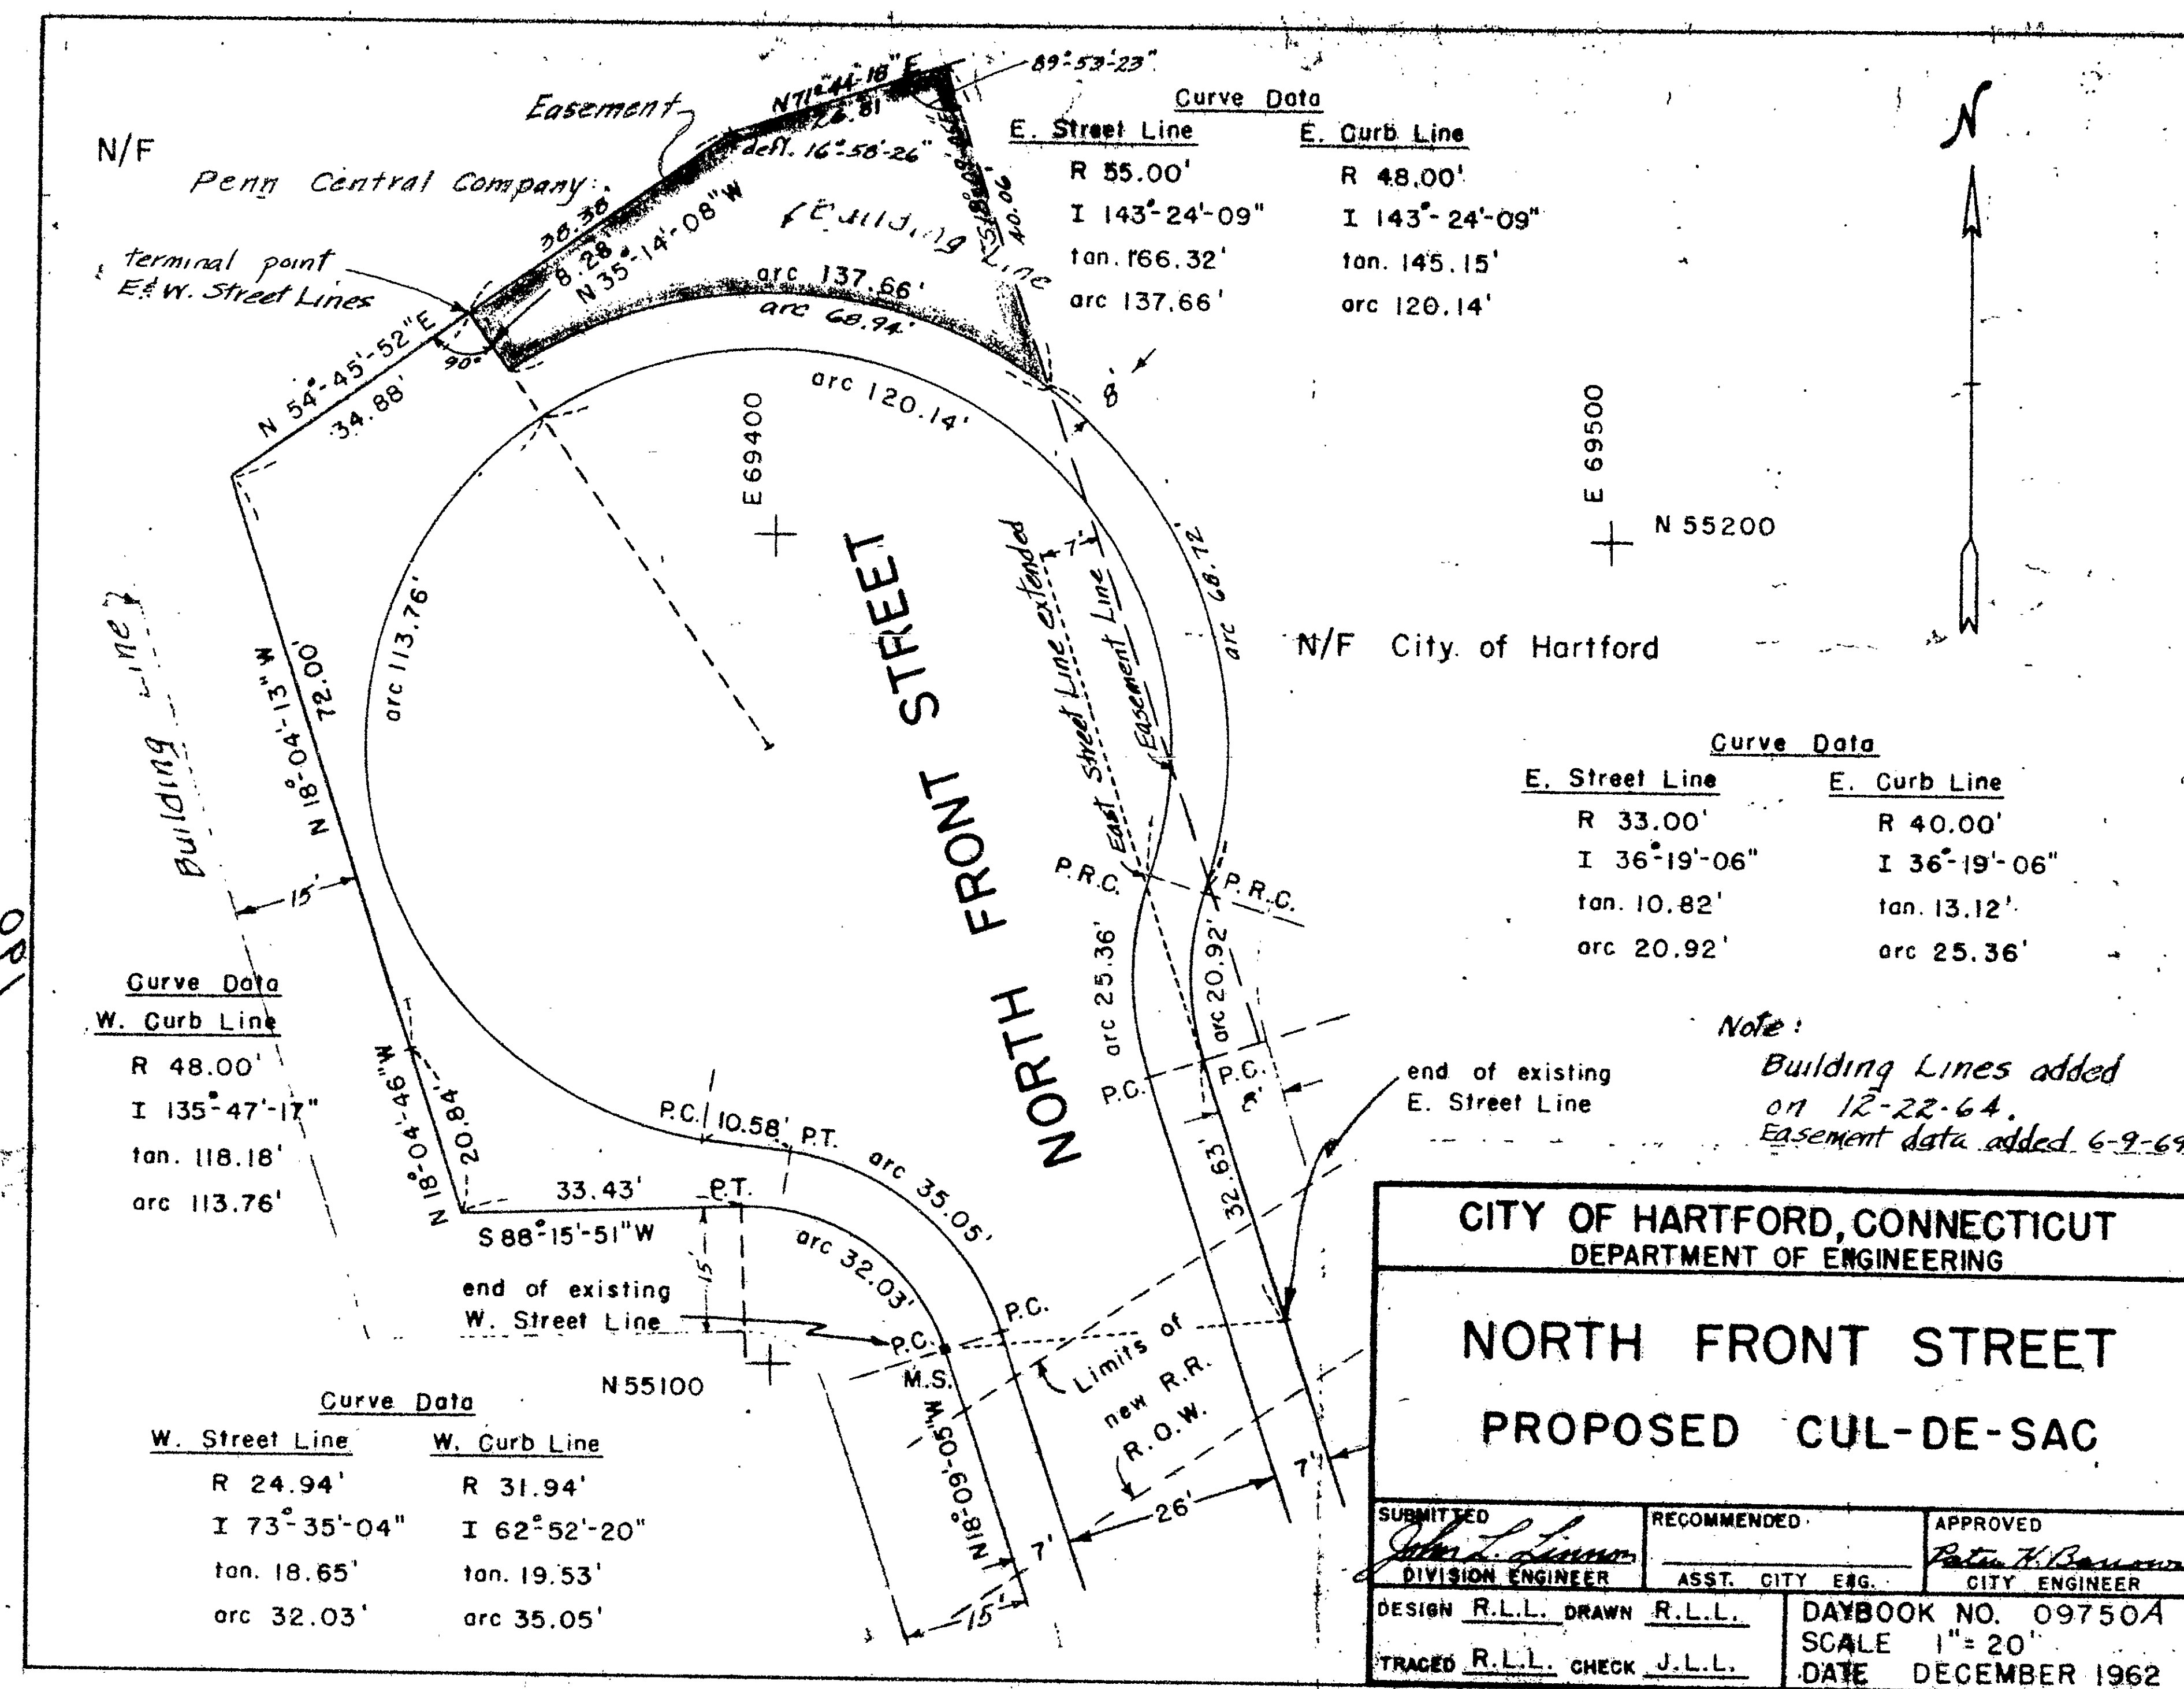

The portion of North Front Street shown in this plan is
an established public street of the City of Hartford.
Feb. 20, 1979
City Engineer

I hereby certify that this map and survey
were prepared in accordance with the
standards of a Certified Surveyor as defined
in the Code of Regulations for Standards of
Accuracy of Surveys and Maps, adopted by the
Connecticut Association of Land Surveyors, Inc.
Michael J. Seenty, L.S.

RECEIVED BY
Feb 20 11 12 AM '79
TOWN & CITY CLERK
H. F. FORD

0 INCHES 1 2 3 4