1064-1

EASI FILE CORP. IRVINE CA EFH 74

1064

1064

PROPERTY OF

JEFFERY C. LIMPERT

54 - 56 WILLARD STREET

HARTFORD CONNECTICUT

SCALE: 1" = 20' MARCH 12, 1979

REVISED MARCH 29, 1979

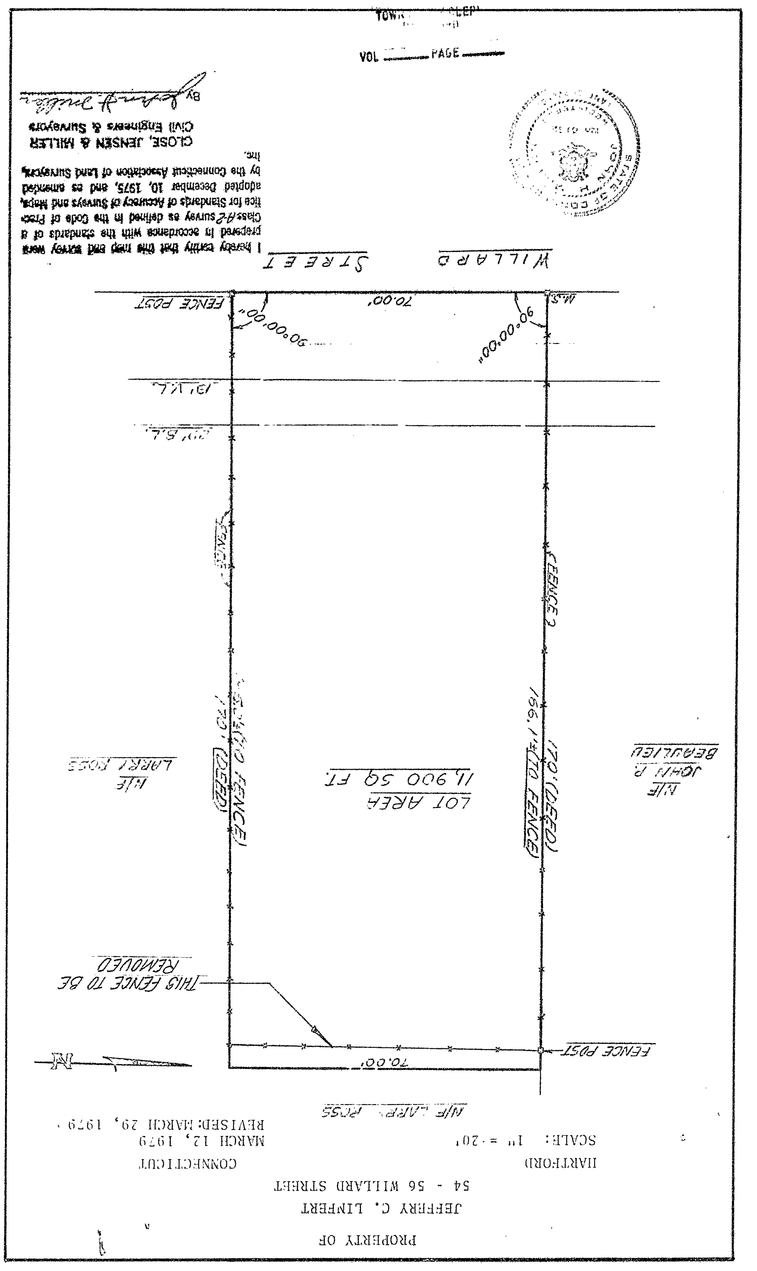

I hereby certify that this map and survey were prepared in accordance with the standards of a Class A-2 survey as defined in the Code of Practice for Standards of Accuracy of Surveys and Maps, adopted December 10, 1975, and as amended by the Connecticut Association of Land Surveyors, Inc.

CLOSE, JENSEN & MILLER
Civil Engineers & Surveyors

By Jeffrey Miller

VOL ____ PAGE ____

TOWN CLERK

RECEIVED BY

MAY 24 2 14 PM '79

The portion of Willard Street shown on this plan is an established public street of the City of Hartford

May 25, 1979

City Engineer

1064