


RECEIVED BY
R. J. Sullivan
SEP 17 2 34 PM '79
VOL. _____ PAGE _____

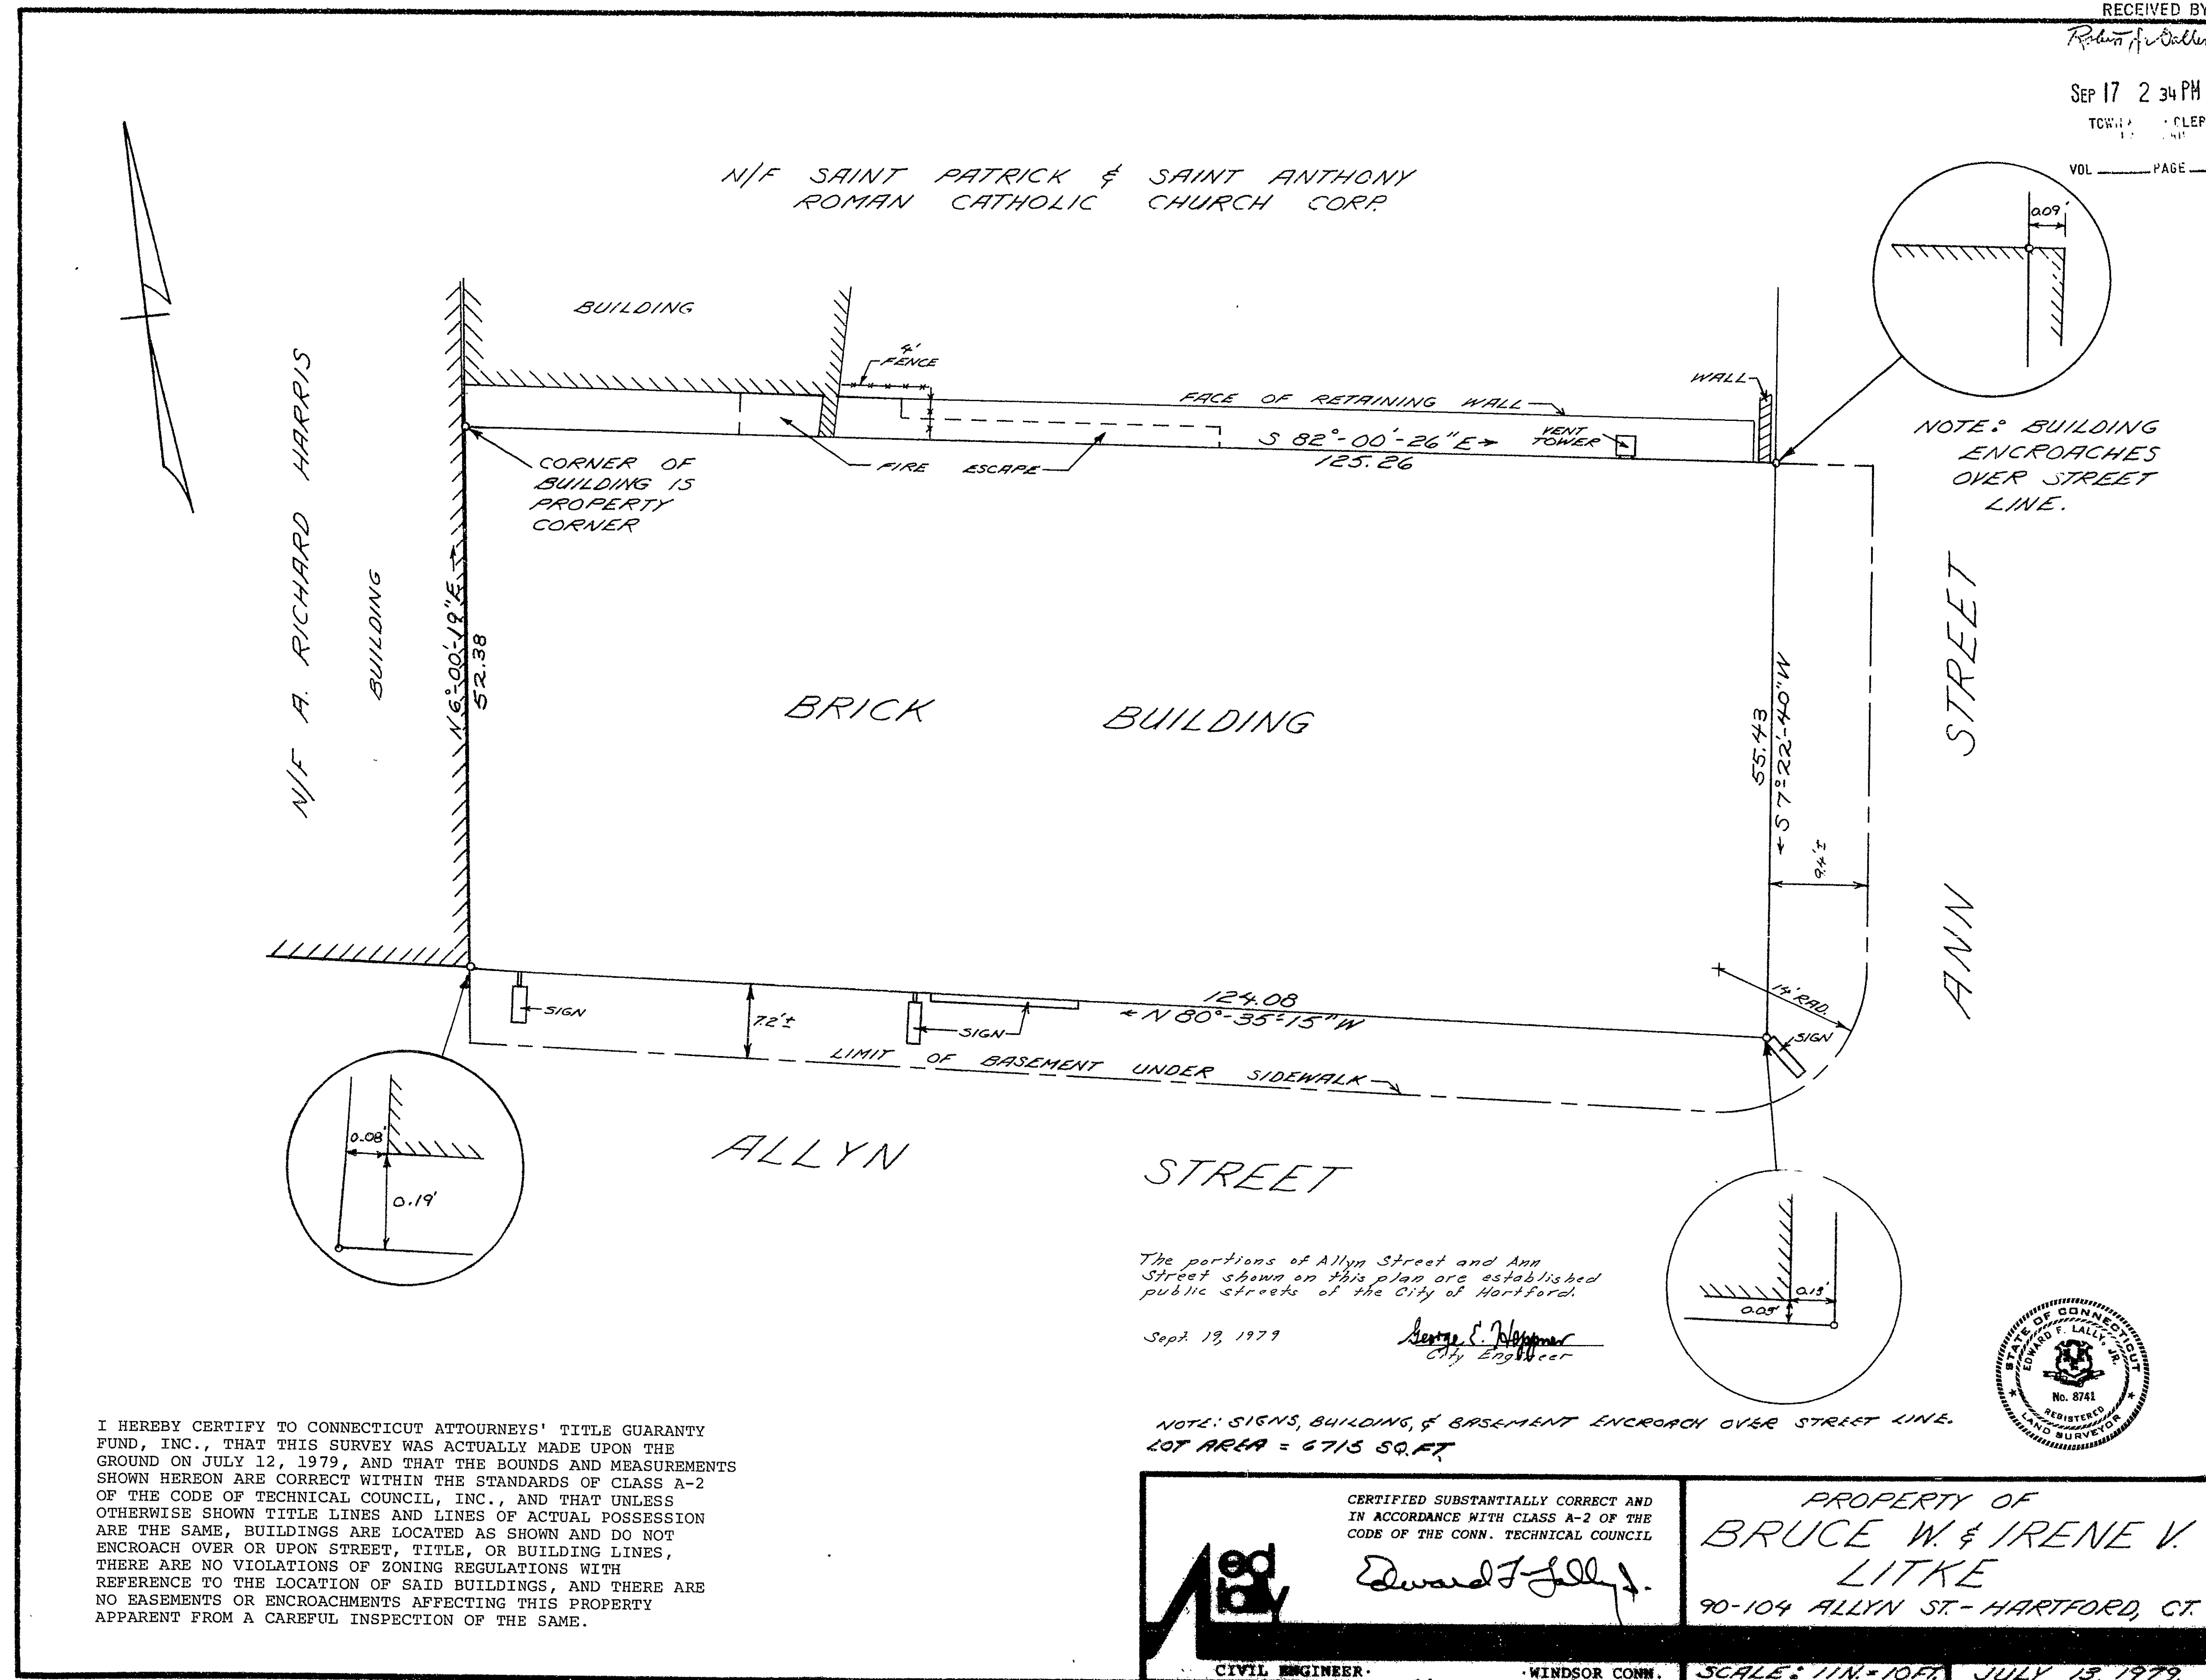

1068

