


Robert F. Vechesloff

NOV 13 2 09 PM '79

TOWN & COUNTY DEPT.
1A 340

101 PAGE
428920

Approx. North

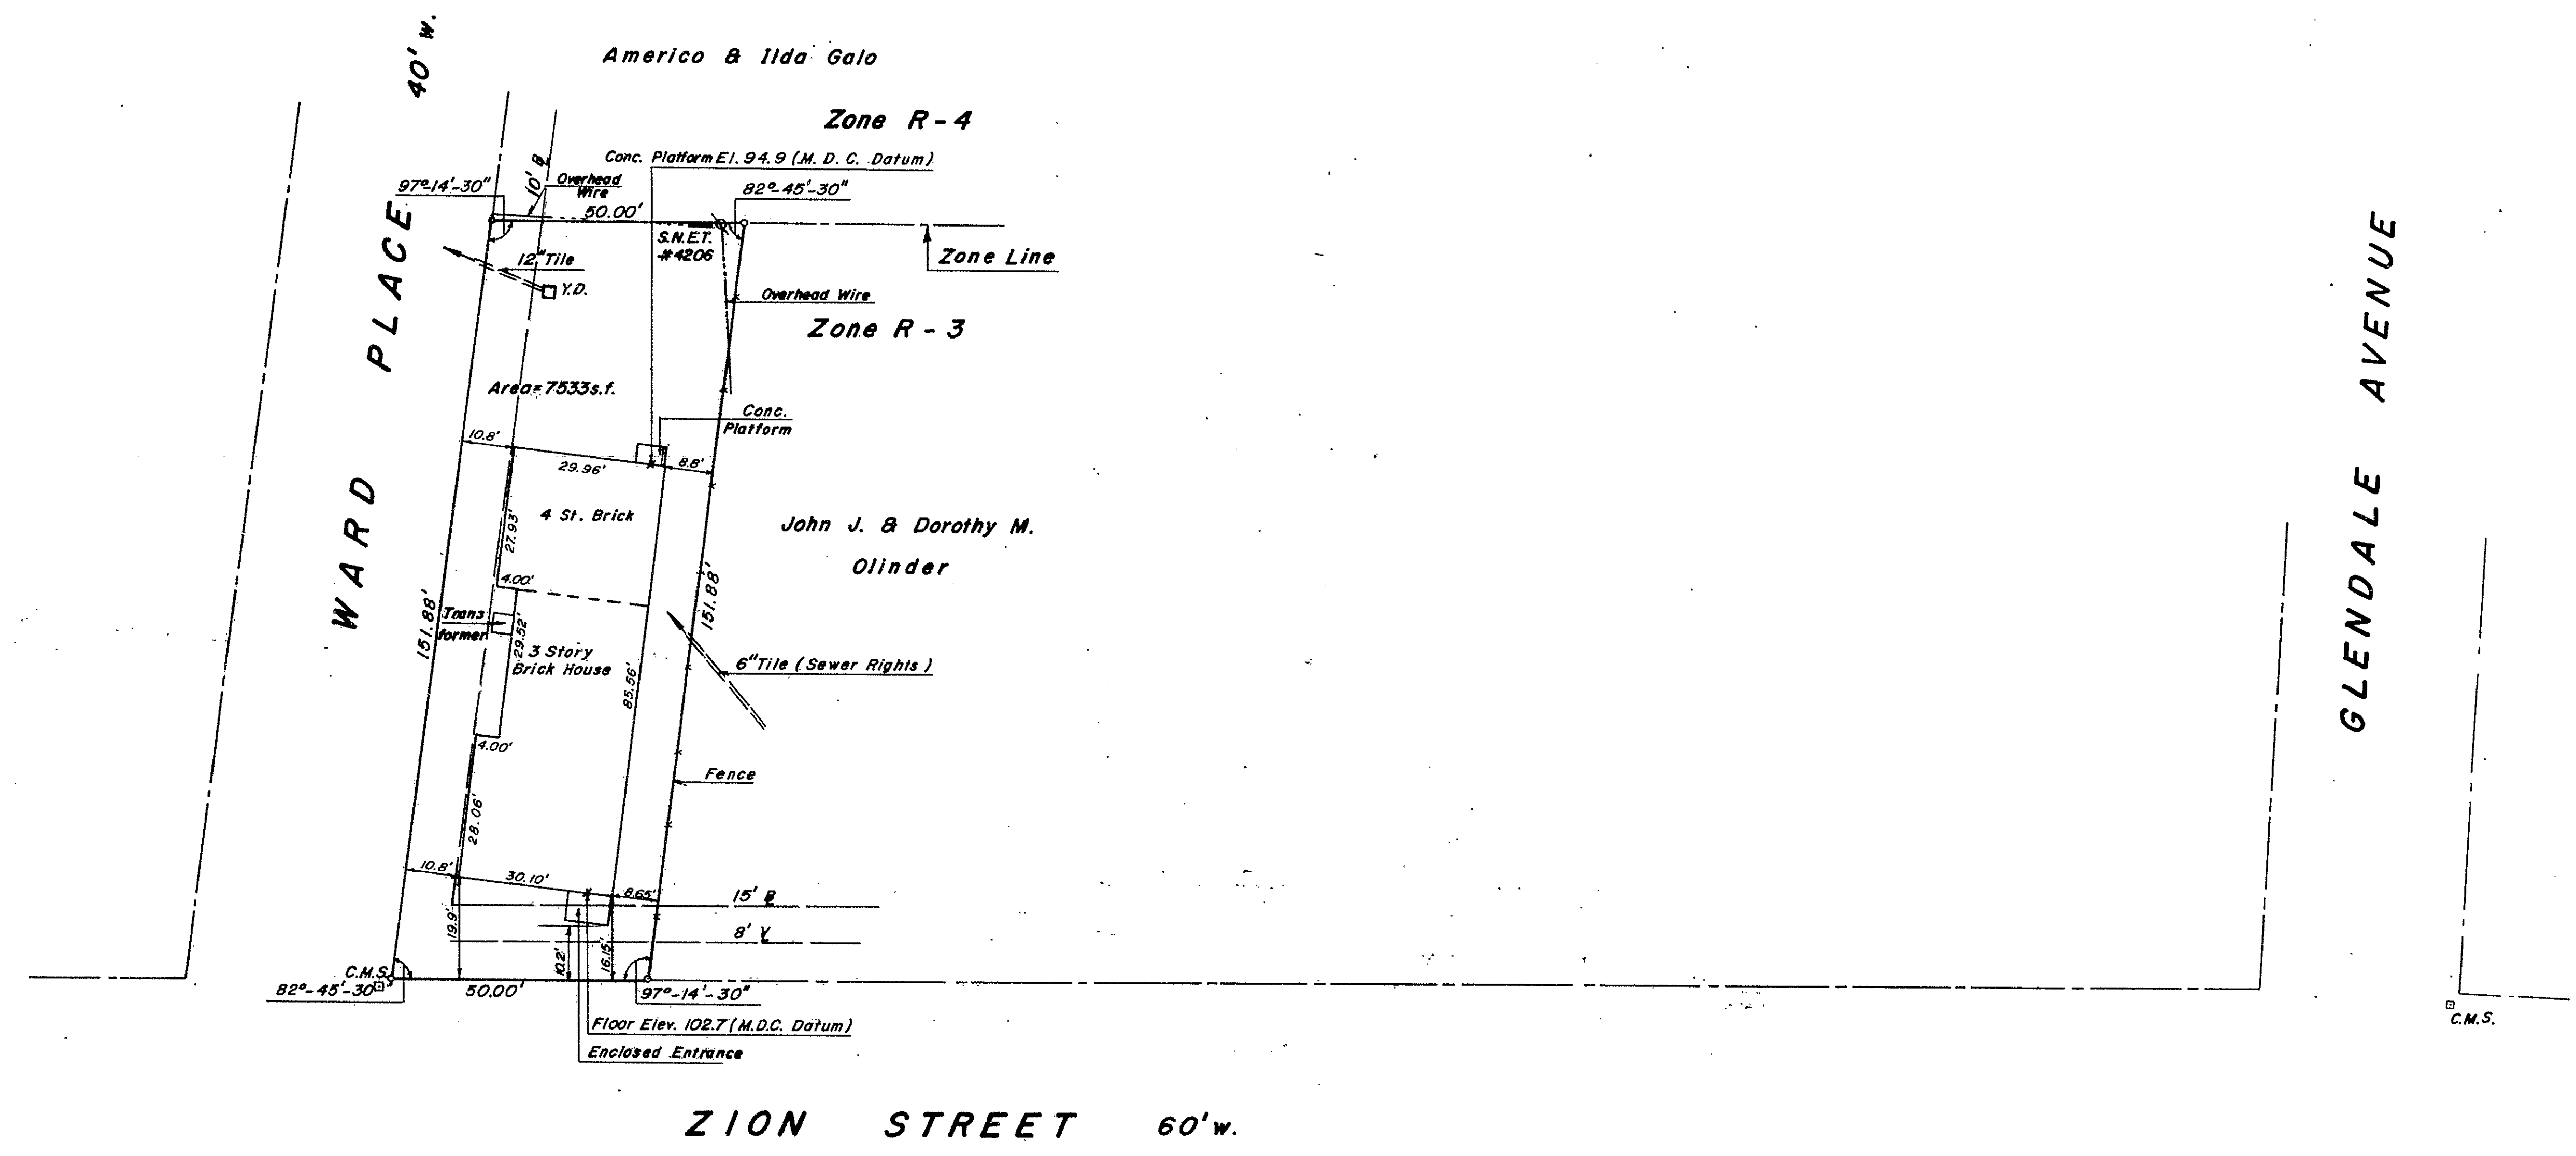

The portions of Zion Street, Glendale Avenue and Ward Place shown on this plan are established public streets of the City of Hartford.
Nov. 13, 1979
Robert F. Vechesloff
Civil Engineer

Note: All offsets for Building Location are perpendicular to reference lines.

I HEREBY CERTIFY THAT THIS MAP AND SURVEY WERE PREPARED IN ACCORDANCE WITH THE STANDARDS OF A CLASS A-E SURVEY AS DEFINED IN THE CODE OF PRACTICE FOR STANDARDS OF ACCURACY OF SURVEYS AND MAPS ADOPTED DECEMBER 10, 1975 AS PASSED BY THE CONNECTICUT ASSOCIATION OF LAND SURVEYORS, INC.
11-8-79
3786
REGISTRATION NO.



ZION PLACE - A CONDOMINIUM
315 ZION STREET
Hartford, Conn.

IGOR VECHESLOFF
PROFESSIONAL ENGINEER & LAND SURVEYOR
51 LORRAINE STREET
HARTFORD, CONNECTICUT
SCALE 1" = 20'
DATE 11-8-79
DRAWING NO. 1780



1072

1972