


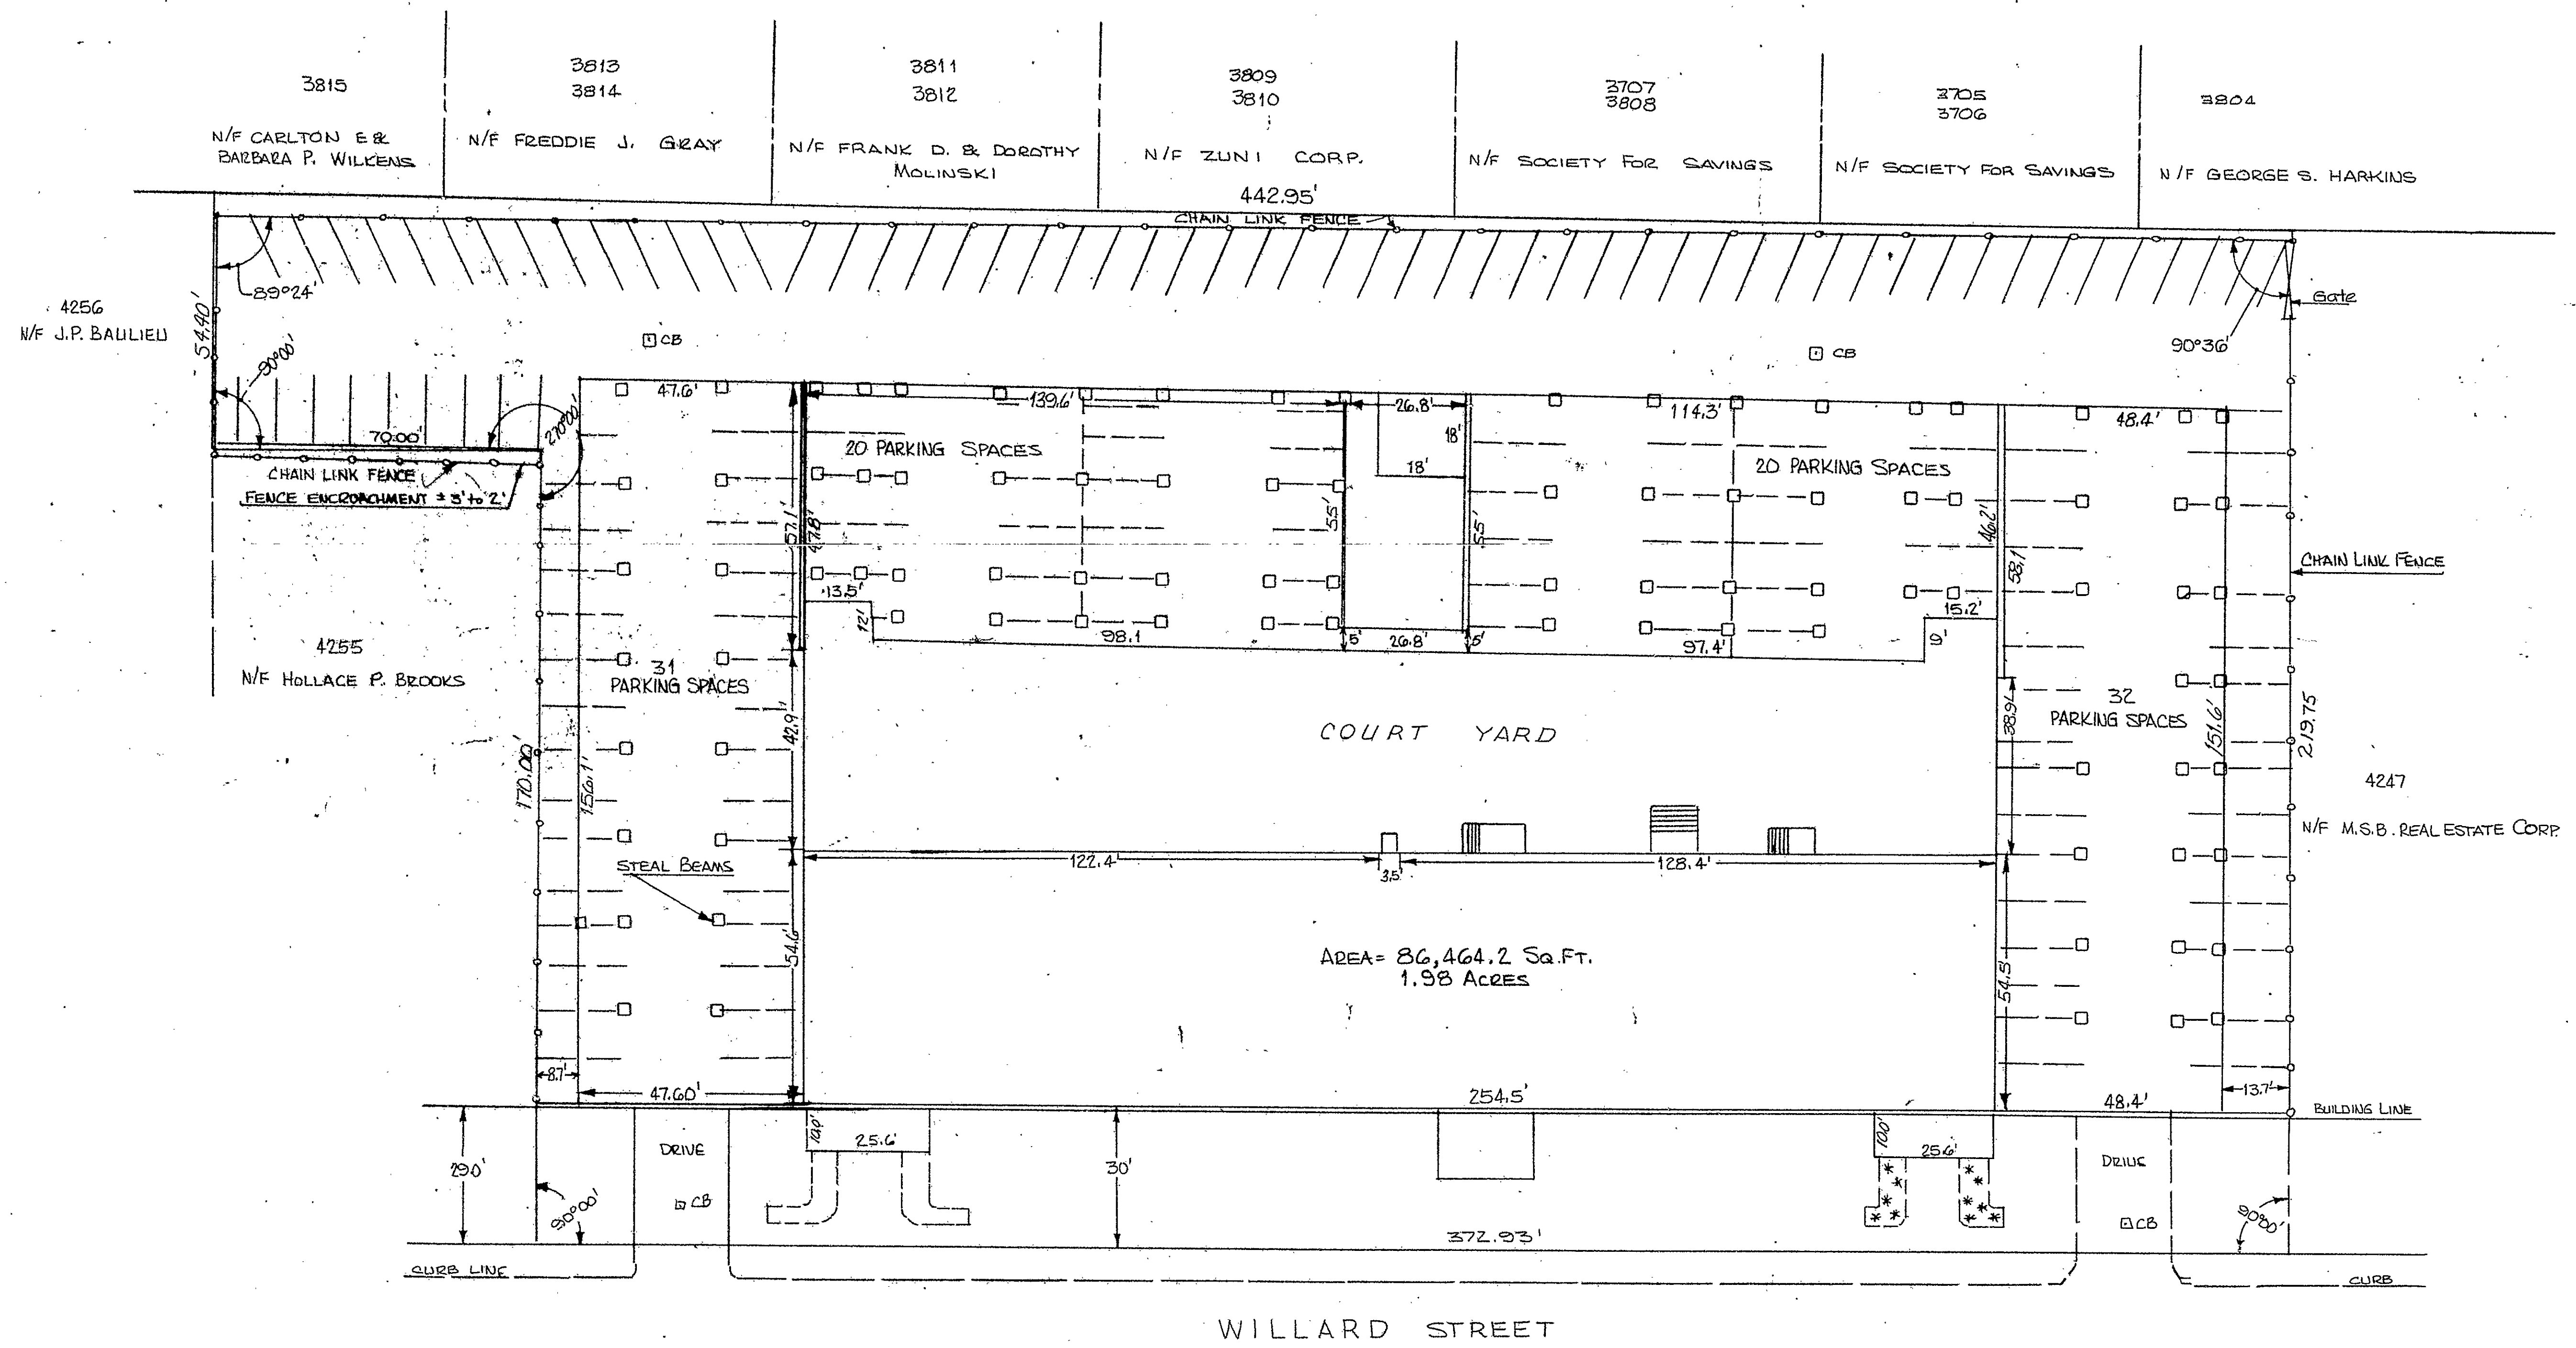

WILLARD STREET

□ = Locate Steel Beams

The portion of Willard Street shown on this plan is an established public street of the City of Hartford.
Nov. 13, 1979 *Surveyor's Seal*
C.S. Engineer

Paul H. Jaeger

PROPERTY OF SOCIETY FOR SAVINGS 34 ~ 50 WILLARD STREET TOWN OF HARTFORD, CONN.	I HEREBY CERTIFY THAT THIS MAP & SURVEY WERE PREPARED IN ACCORDANCE WITH THE STANDARDS OF CLASS A ₂ SURVEY AS DEFINED IN THE CODE OF PRACTICE FOR STANDARDS AND ACCURACY OF SURVEY & MAPS ADOPTED DECEMBER 10, 1975 AS AMENDED BY THE CONN. ASSOCIATION OF LAND SURVEYORS, INC.	ALCA SURVEY ASSOCIATES CARL H. JAEGER L.S. 7763 WETHERSFIELD, CONN. <i>Carl H. Jaeger</i> SCALE: 1" = 20' DATE: 11-1979	SHEET 1 OF 1
---	---	--	-----------------



1073

1073

1073

RECEIVED BY
Nov 9 2 11 PM '79
TOWN CLERK
1073