RECEIVED BY
Robert A. Sullivan
Nov 13 1 59 PM '79
TY CLERK
VOL ____ PAGE ____
4x8918

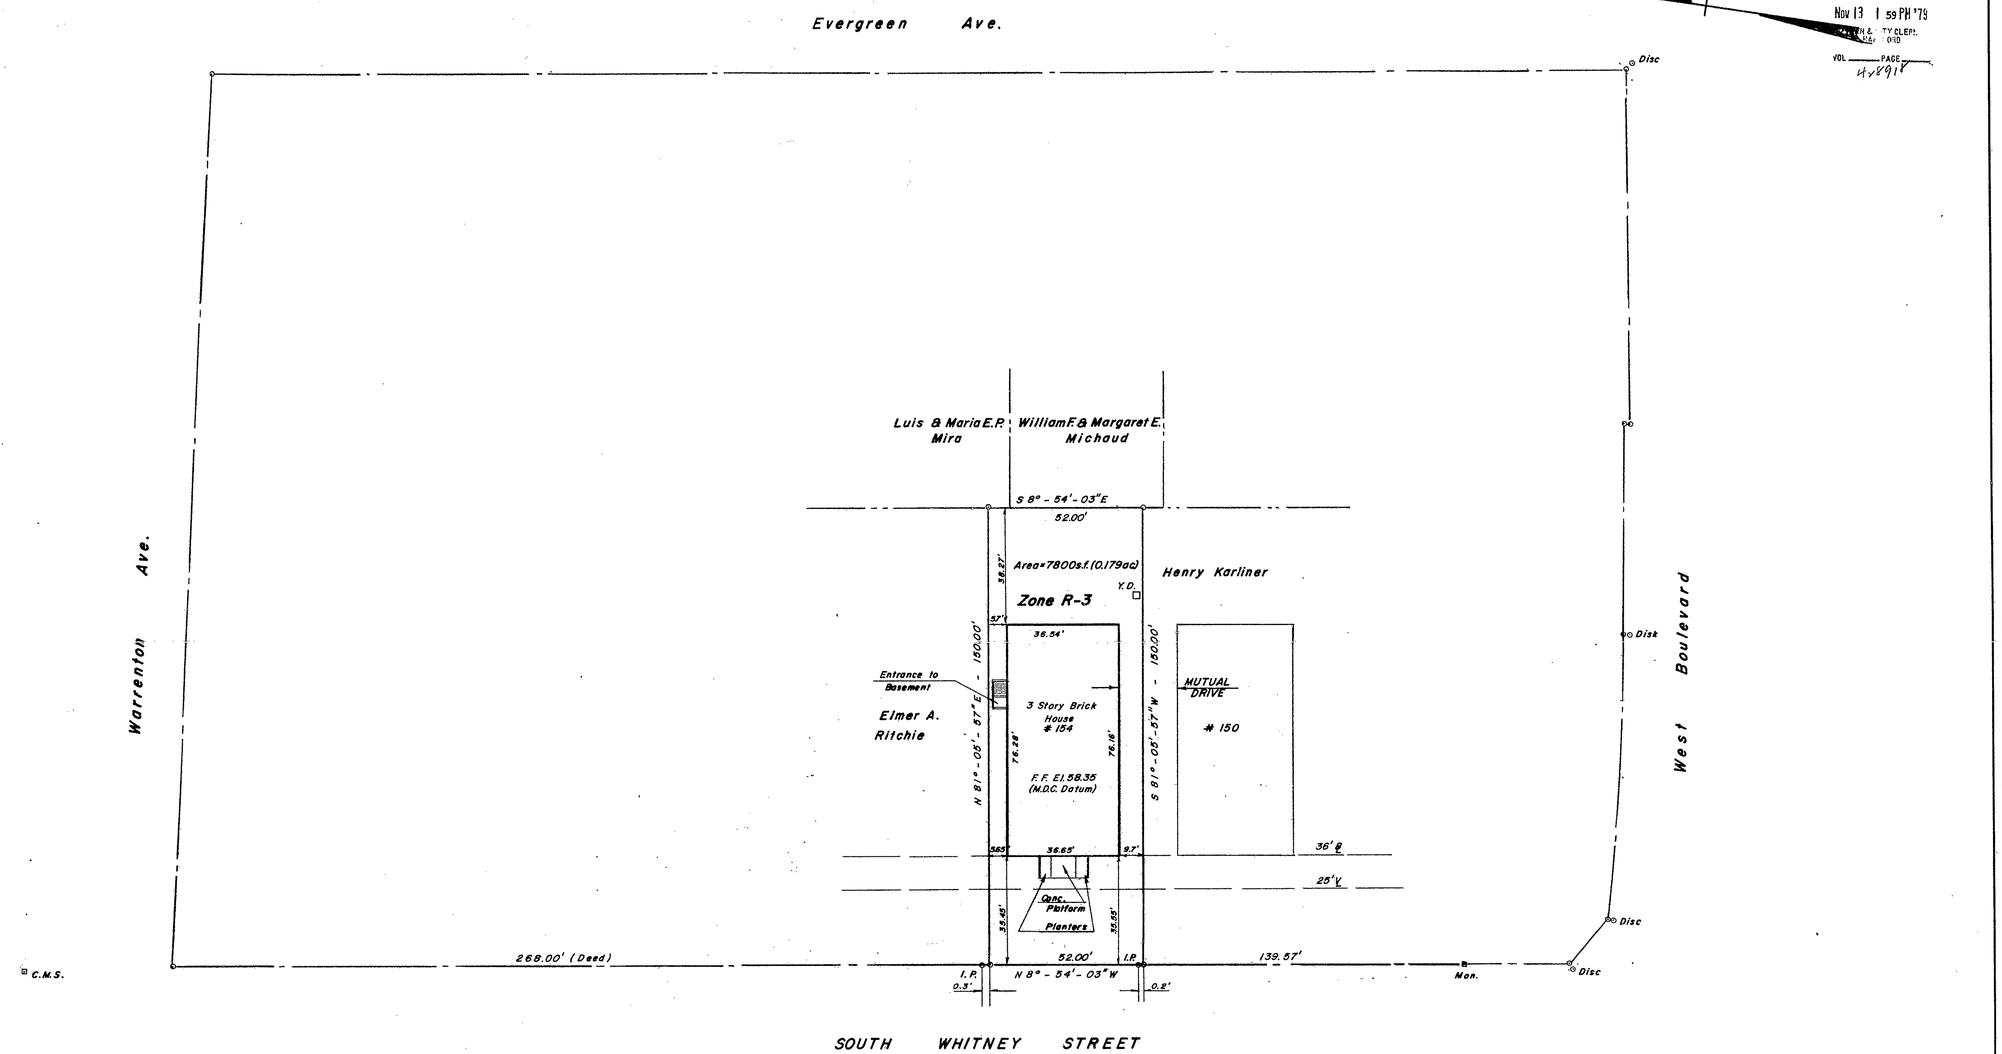

WHITNEY HEIGHTS CONDOMINIUM

154 South Whitney Street

HARTFORD, CONN.

The portions of South Whitney Street, West Boulevard, Evergreen Avenue and Warrenton Avenue shown on this plan are established public streets of the City of Hartford.

Nov. 13, 1979 — City Engineer

NOTE: All offsets for Building Location are perpendicular to reference lines.

I HEREBY CERTIFY THAT THIS MAP AND SURVEY WERE PREPARED IN ACCORDANCE WITH THE STANDARDS OF A CLASS A-2 SURVEY AS DEFINED IN THE CODE OF PRACTICE FOR STANDARDS OF ACCURACY OF SURVEYS AND MAPS, ADOPTED DECEMBER 10, 1975 AS AMENDED BY THE CONNECTICUT ASSOCIATION OF LAND SURVEYORS, INC.

SURVEYOR — 11-9-79 DATE — 3756 REGISTRATION NO.

IGOR VECHESLOFF
PROFESSIONAL ENGINEER & LAND SURVEYOR
51 LORRAINE STREET
HARTFORD, CONNECTICUT

SCALE 1" = 20'	DATE 11 - 9 - 79
	DRAWING NO. 1781

#55 #1075

1075