

1083

1 0 8 3 - 1

The portions of Whitman Court and Buckingham Street shown on this plan are established public streets of the City of Hartford.


James E. Hopper
City Engineer

Nov 13, 1979

ELEVATIONS

FIRST FLOOR =	110.53	110.54
2 nd FLOOR =	62.39	59.69
3 rd FLOOR =	71.88	71.84
BASEMENT =	83.17	83.39
	51.0 [±]	51.0 [±]


ALL ELEVATIONS ON M.O.C. DATUM
(BM T-9 ELEV. 58.85)

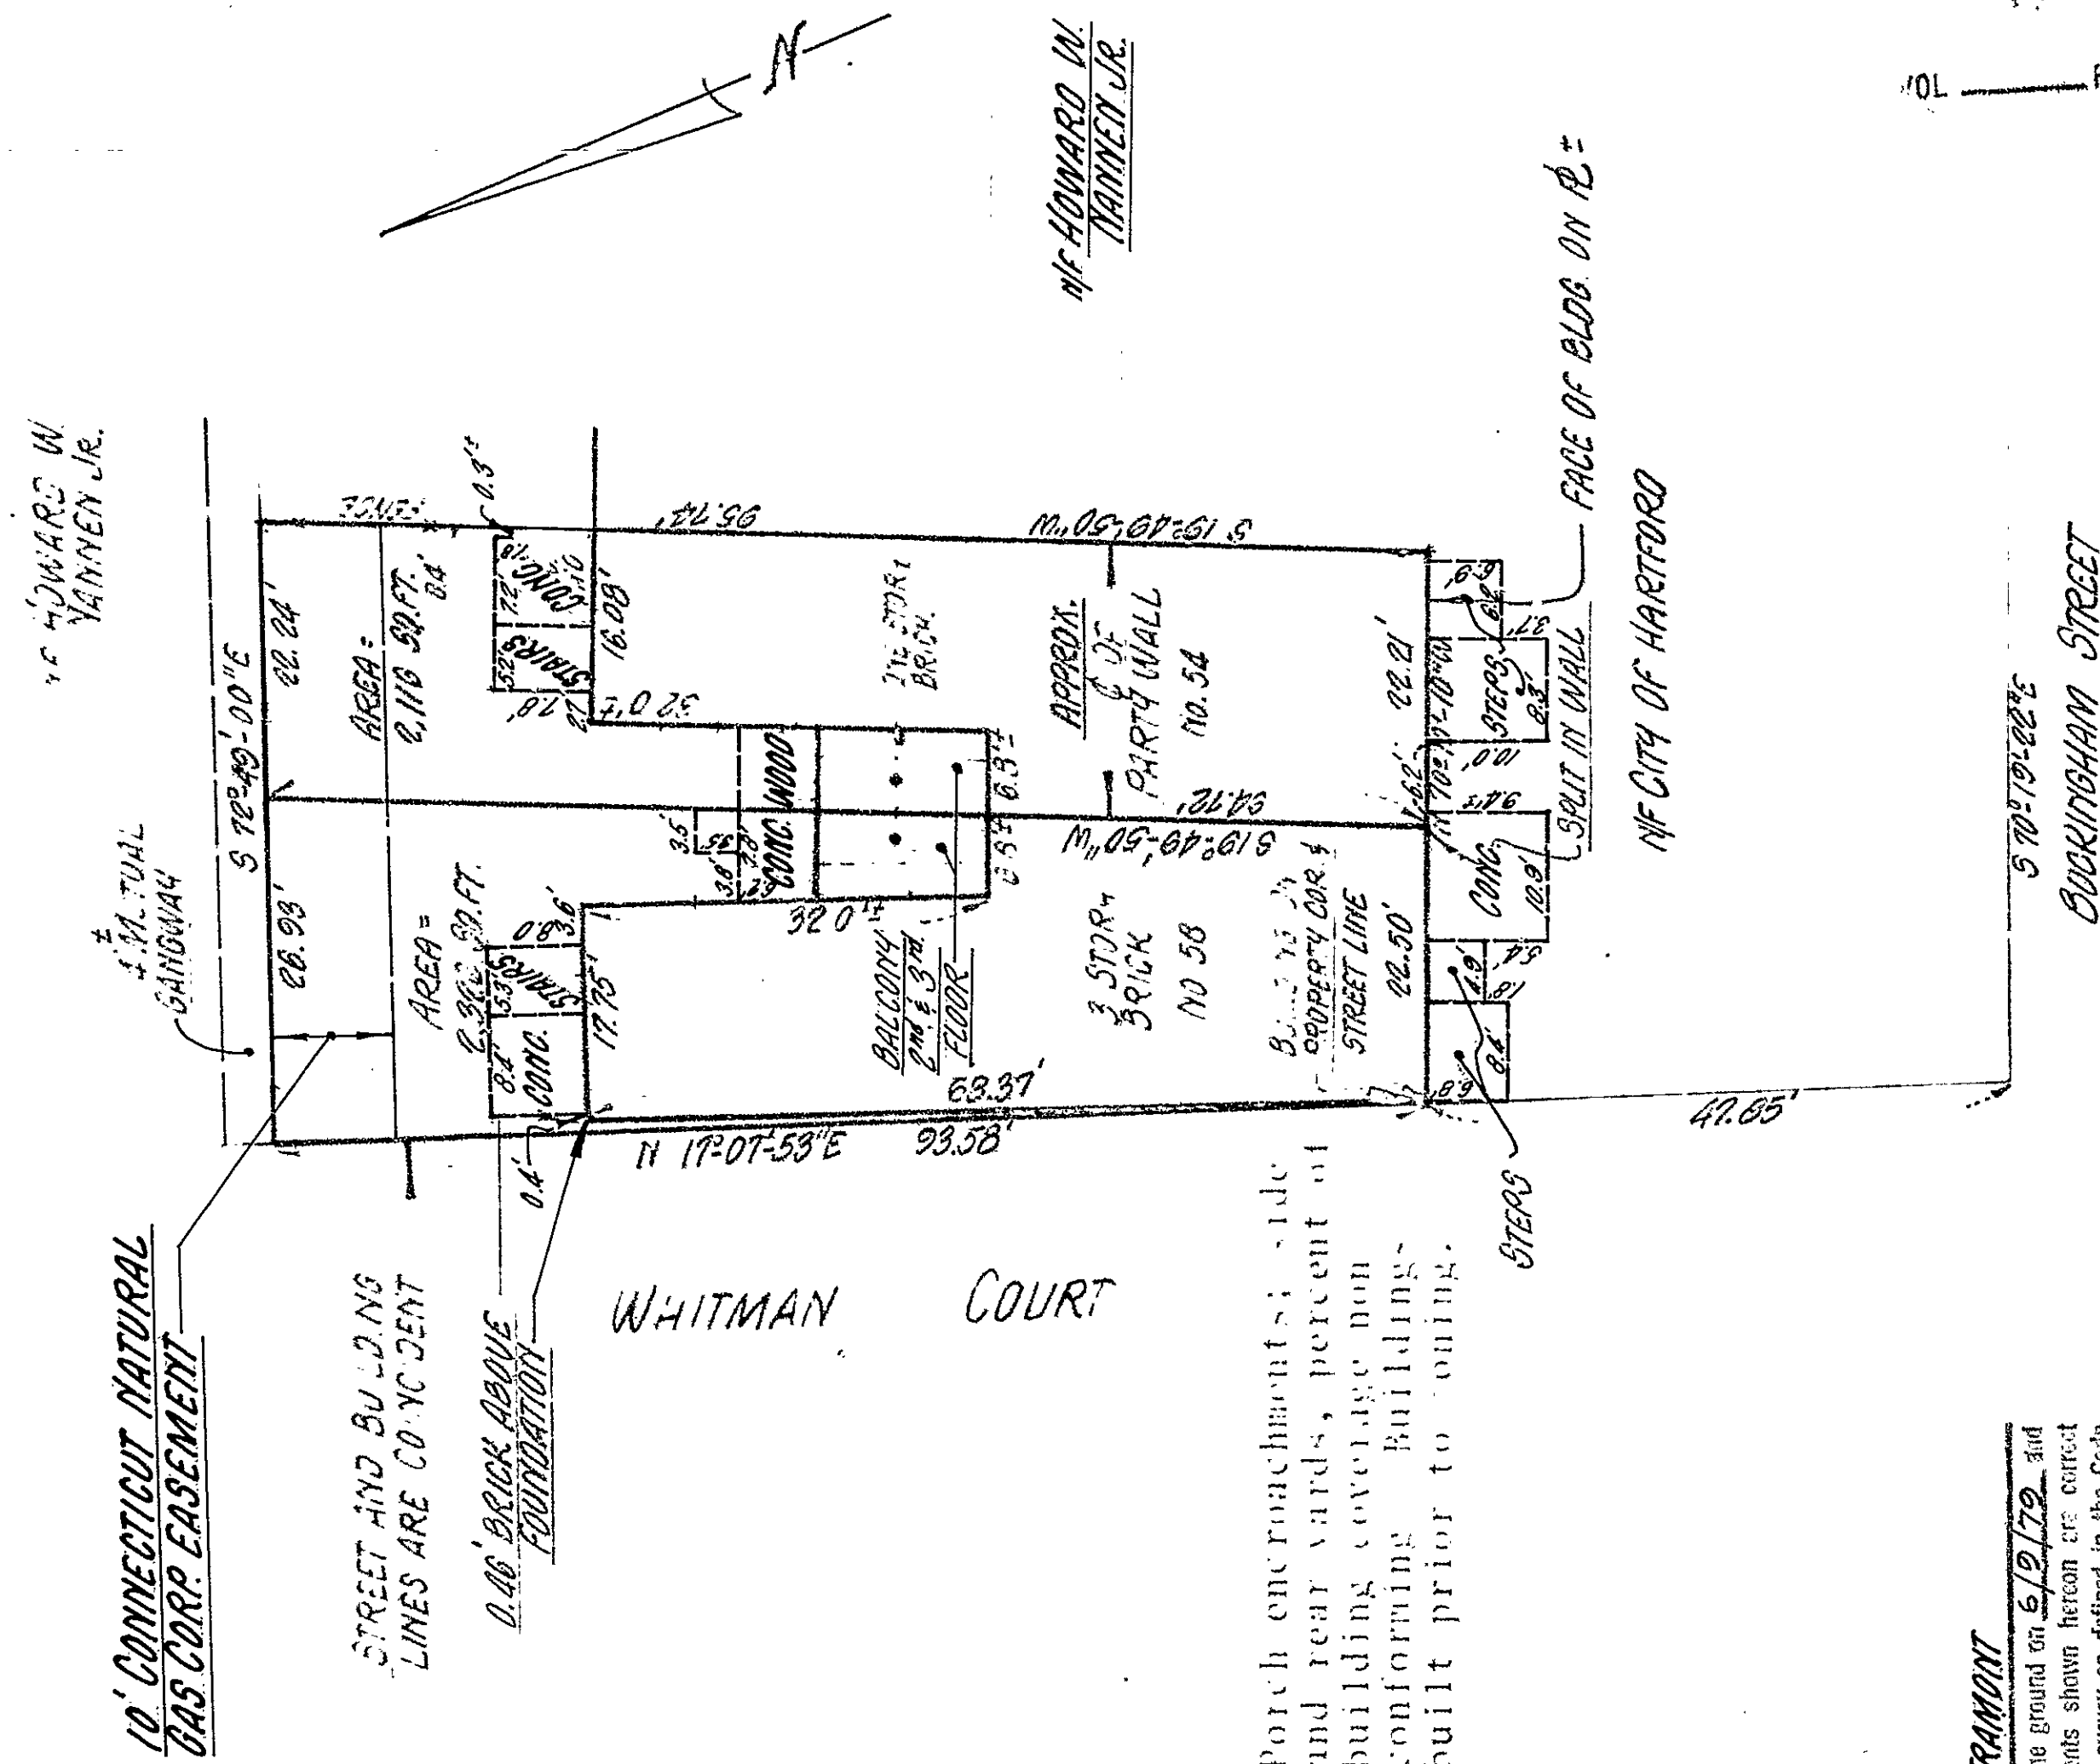

NOTE: Porch encroachments; side and rear yards, percent of building coverage non-conforming. Buildings built prior to zoning.

THOMAS J. TRAMONT

By John H. Miller

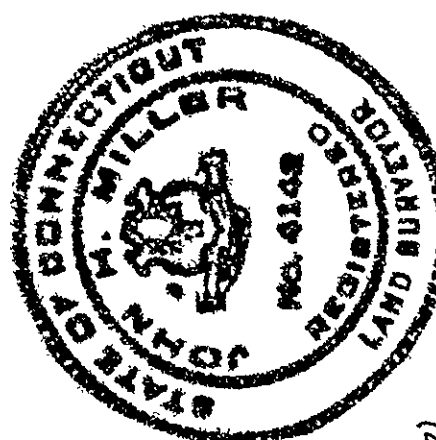

REVISED 11/9/79
REVISED 11/7/79 (UPDATED)

REVISED 11/6/79
RECEIVED 11/7/79 (UPDATED)

CLOSE, JENSEN & MILLER
CONSULTING ENGINEERS, LAND PLANNERS & SURVEYORS
449 SILAS DEANE HIGHWAY WETHERSFIELD, CONNECTICUT

BUCKINGHAM CONDOMINIUM

THOMAS J. TRAMONT

54-58 BUCKINGHAM STREET

HARTFORD,
CONNECTICUT

SCALE 1" = 20'

SHEET 1 OF 1

3791 M

48

1083