PROPERTY OF
JEFF LINDEPT
6 - 8 ATWOOD STREET

HARTFORD CONNECTICUT
SCALE: 1" = 20' NOVEMBER 8, 1979

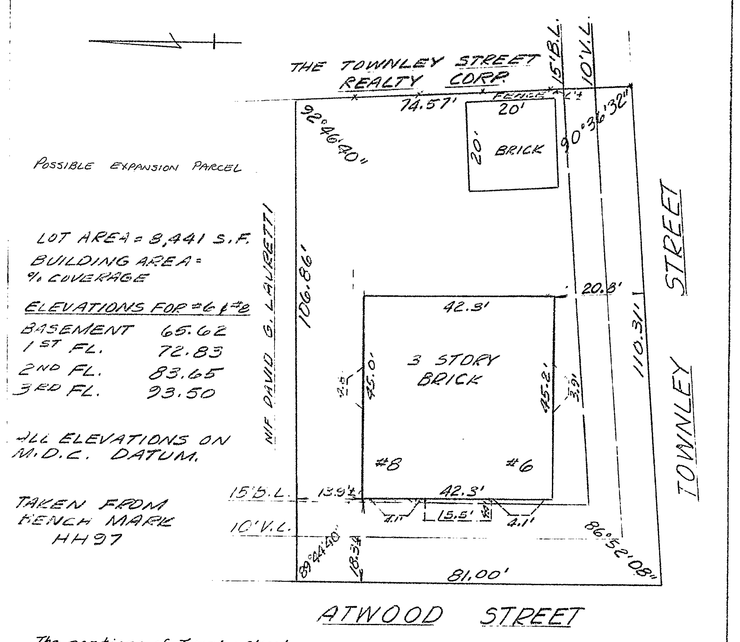


The portions of Townley Street and Atwood Street shown on this plan are established public streets of the City of Hartford.

Nov. 13, 1979 George E. Heffner
City Engineer

STATE OF CONNECTICUT
JOHN H. MILLER
No. 4142
REGISTERED
LAND SURVEYOR

I hereby certify that the ...
... A2 ...
...

CLOSE, JENSEN & MILLER
Civil Engineers & Surveyors
By John H. Miller

RECEIVED BY
Robert A. Sullivan
NOV 13 8 35 AM '79
TO ...

EASI FILE CORP. IRVINE, CA
1083
EFH 74

1083-2

4 APPS