


RECEIVED BY
Robert J. Sullivan
Nov 13 2 21 PM '79
TOWN & COUNTY
HARTFORD
VOL. _____ PAGE _____
42896+27

N/F DAVID L. ABRAHAMSON

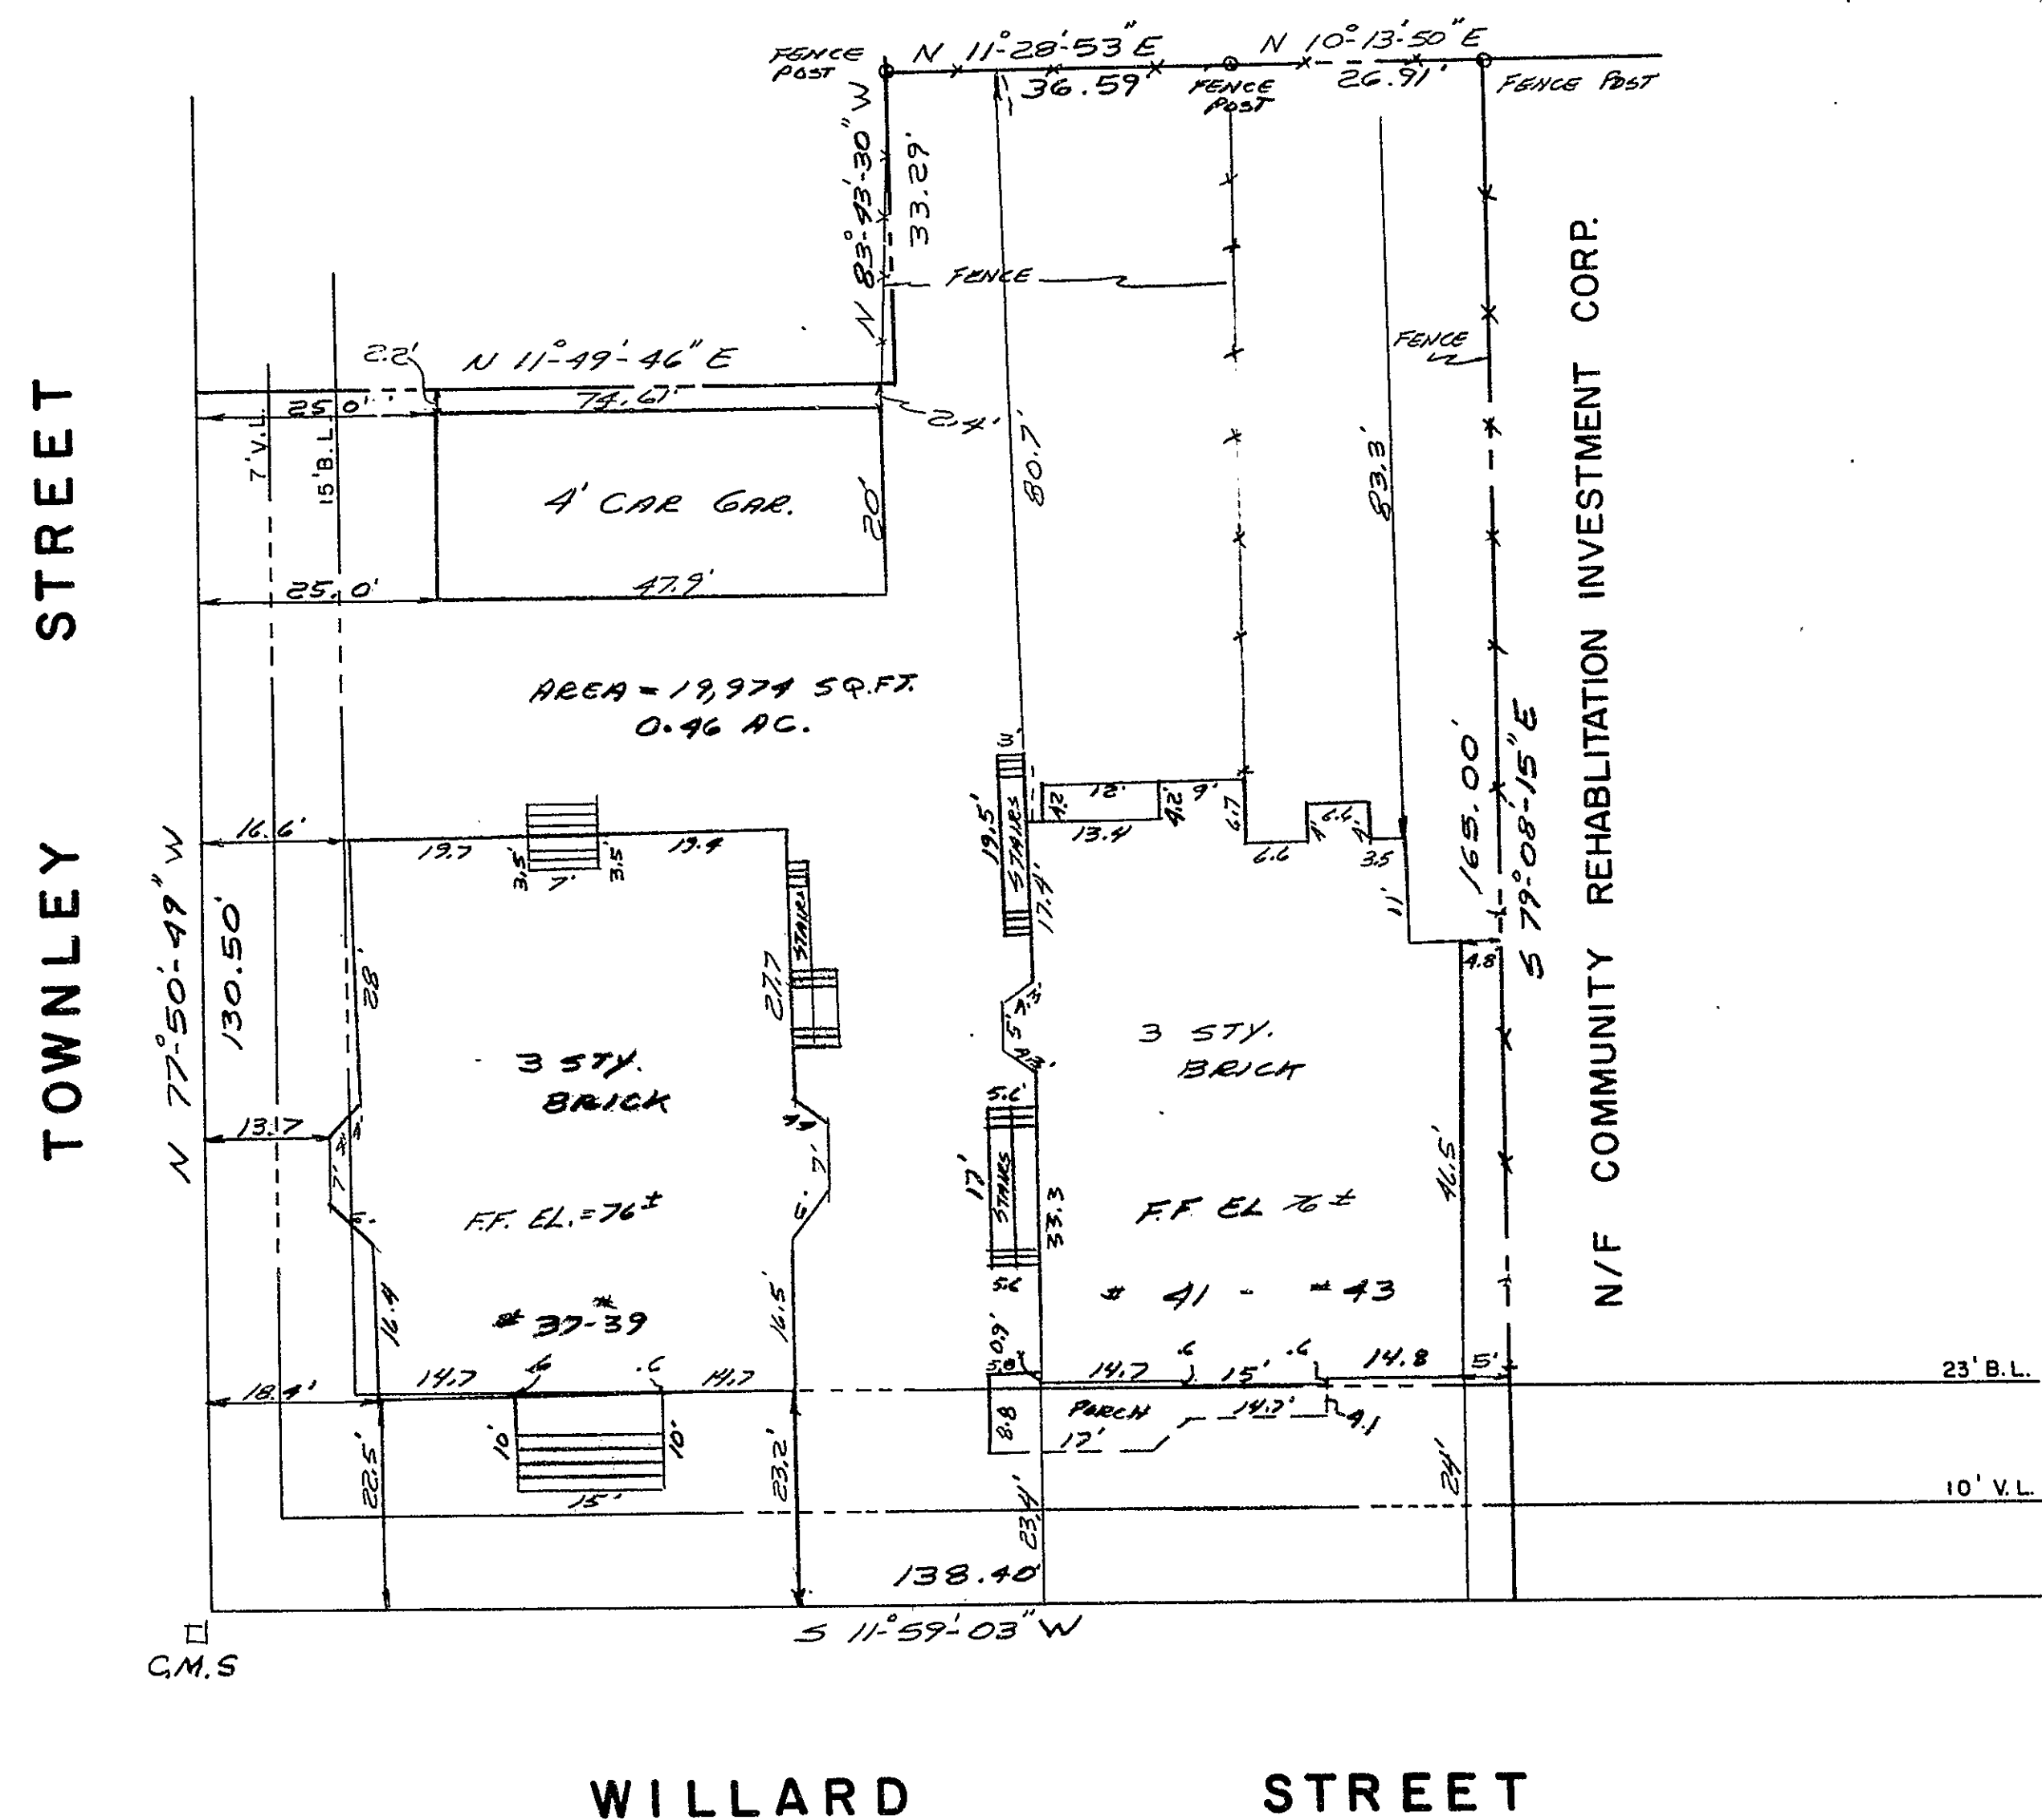

NOTE:
ALL OFFSET DISTANCES ARE
PERPENDICULAR TO THE
STREET LINES OR PROPERTY
LINES
MDC DATUM USED
ZONE RO-2

The portions of Townley Street
and Willard Street shown on this
plan are established public streets
of the City of Hartford
Nov. 13, 1979 *George E. Flynn*
City Engineer

I HEREBY CERTIFY THAT THIS MAP AND SURVEY
WERE PREPARED IN ACCORDANCE WITH THE
STANDARDS OF A CLASS A-2 SURVEY AS DEFINED
IN THE CODE OF PRACTICE FOR STANDARDS OF
ACCURACY OF SURVEYS AND MAPS, ADOPTED
DECEMBER 10, 1975 AS AMENDED BY THE
CONNECTICUT ASSOCIATION OF LAND SURVEYORS INC.

Peter D. Flynn

	PROPERTY MAP OF		
	WILLARD AT TOWNLEY - A CONDO.		
	37,39,41&43 WILLARD ST. HARTFORD CONNECTICUT		
	Date 11/9/79	drawn by CC	job no. 79172
	scale 1"=20'	checked by PDF	sheet no. 1 of 1
F A HENKIN & ASSOCIATES 101 Millbrook (Hartford) Hartford, CT 06105			

FF 47

