1085-1

EASI FILE CORP. IRVINE CA. EFM 34
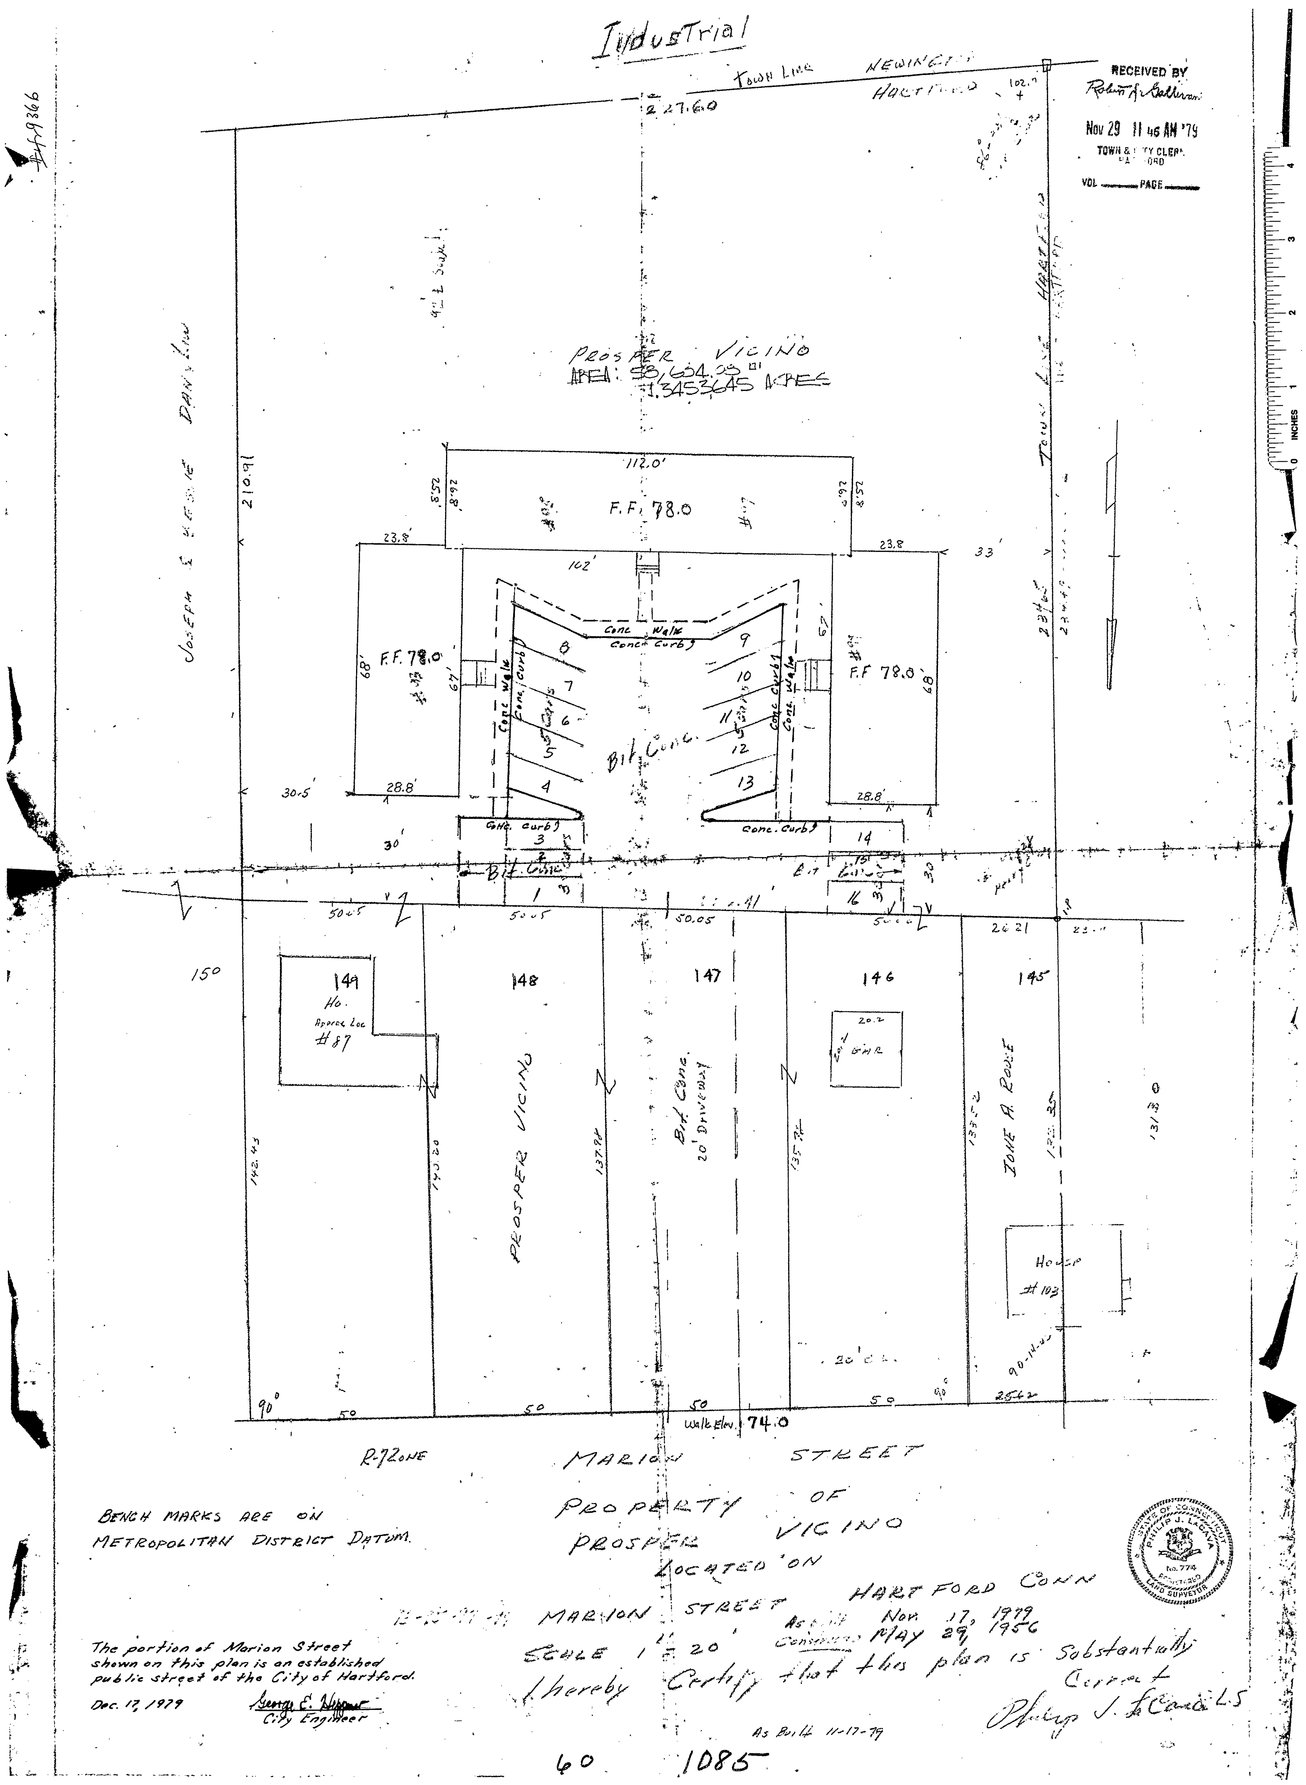
1085