


RECEIVED BY
JAN 14 10 22 AM '80
TOTAL
VOL

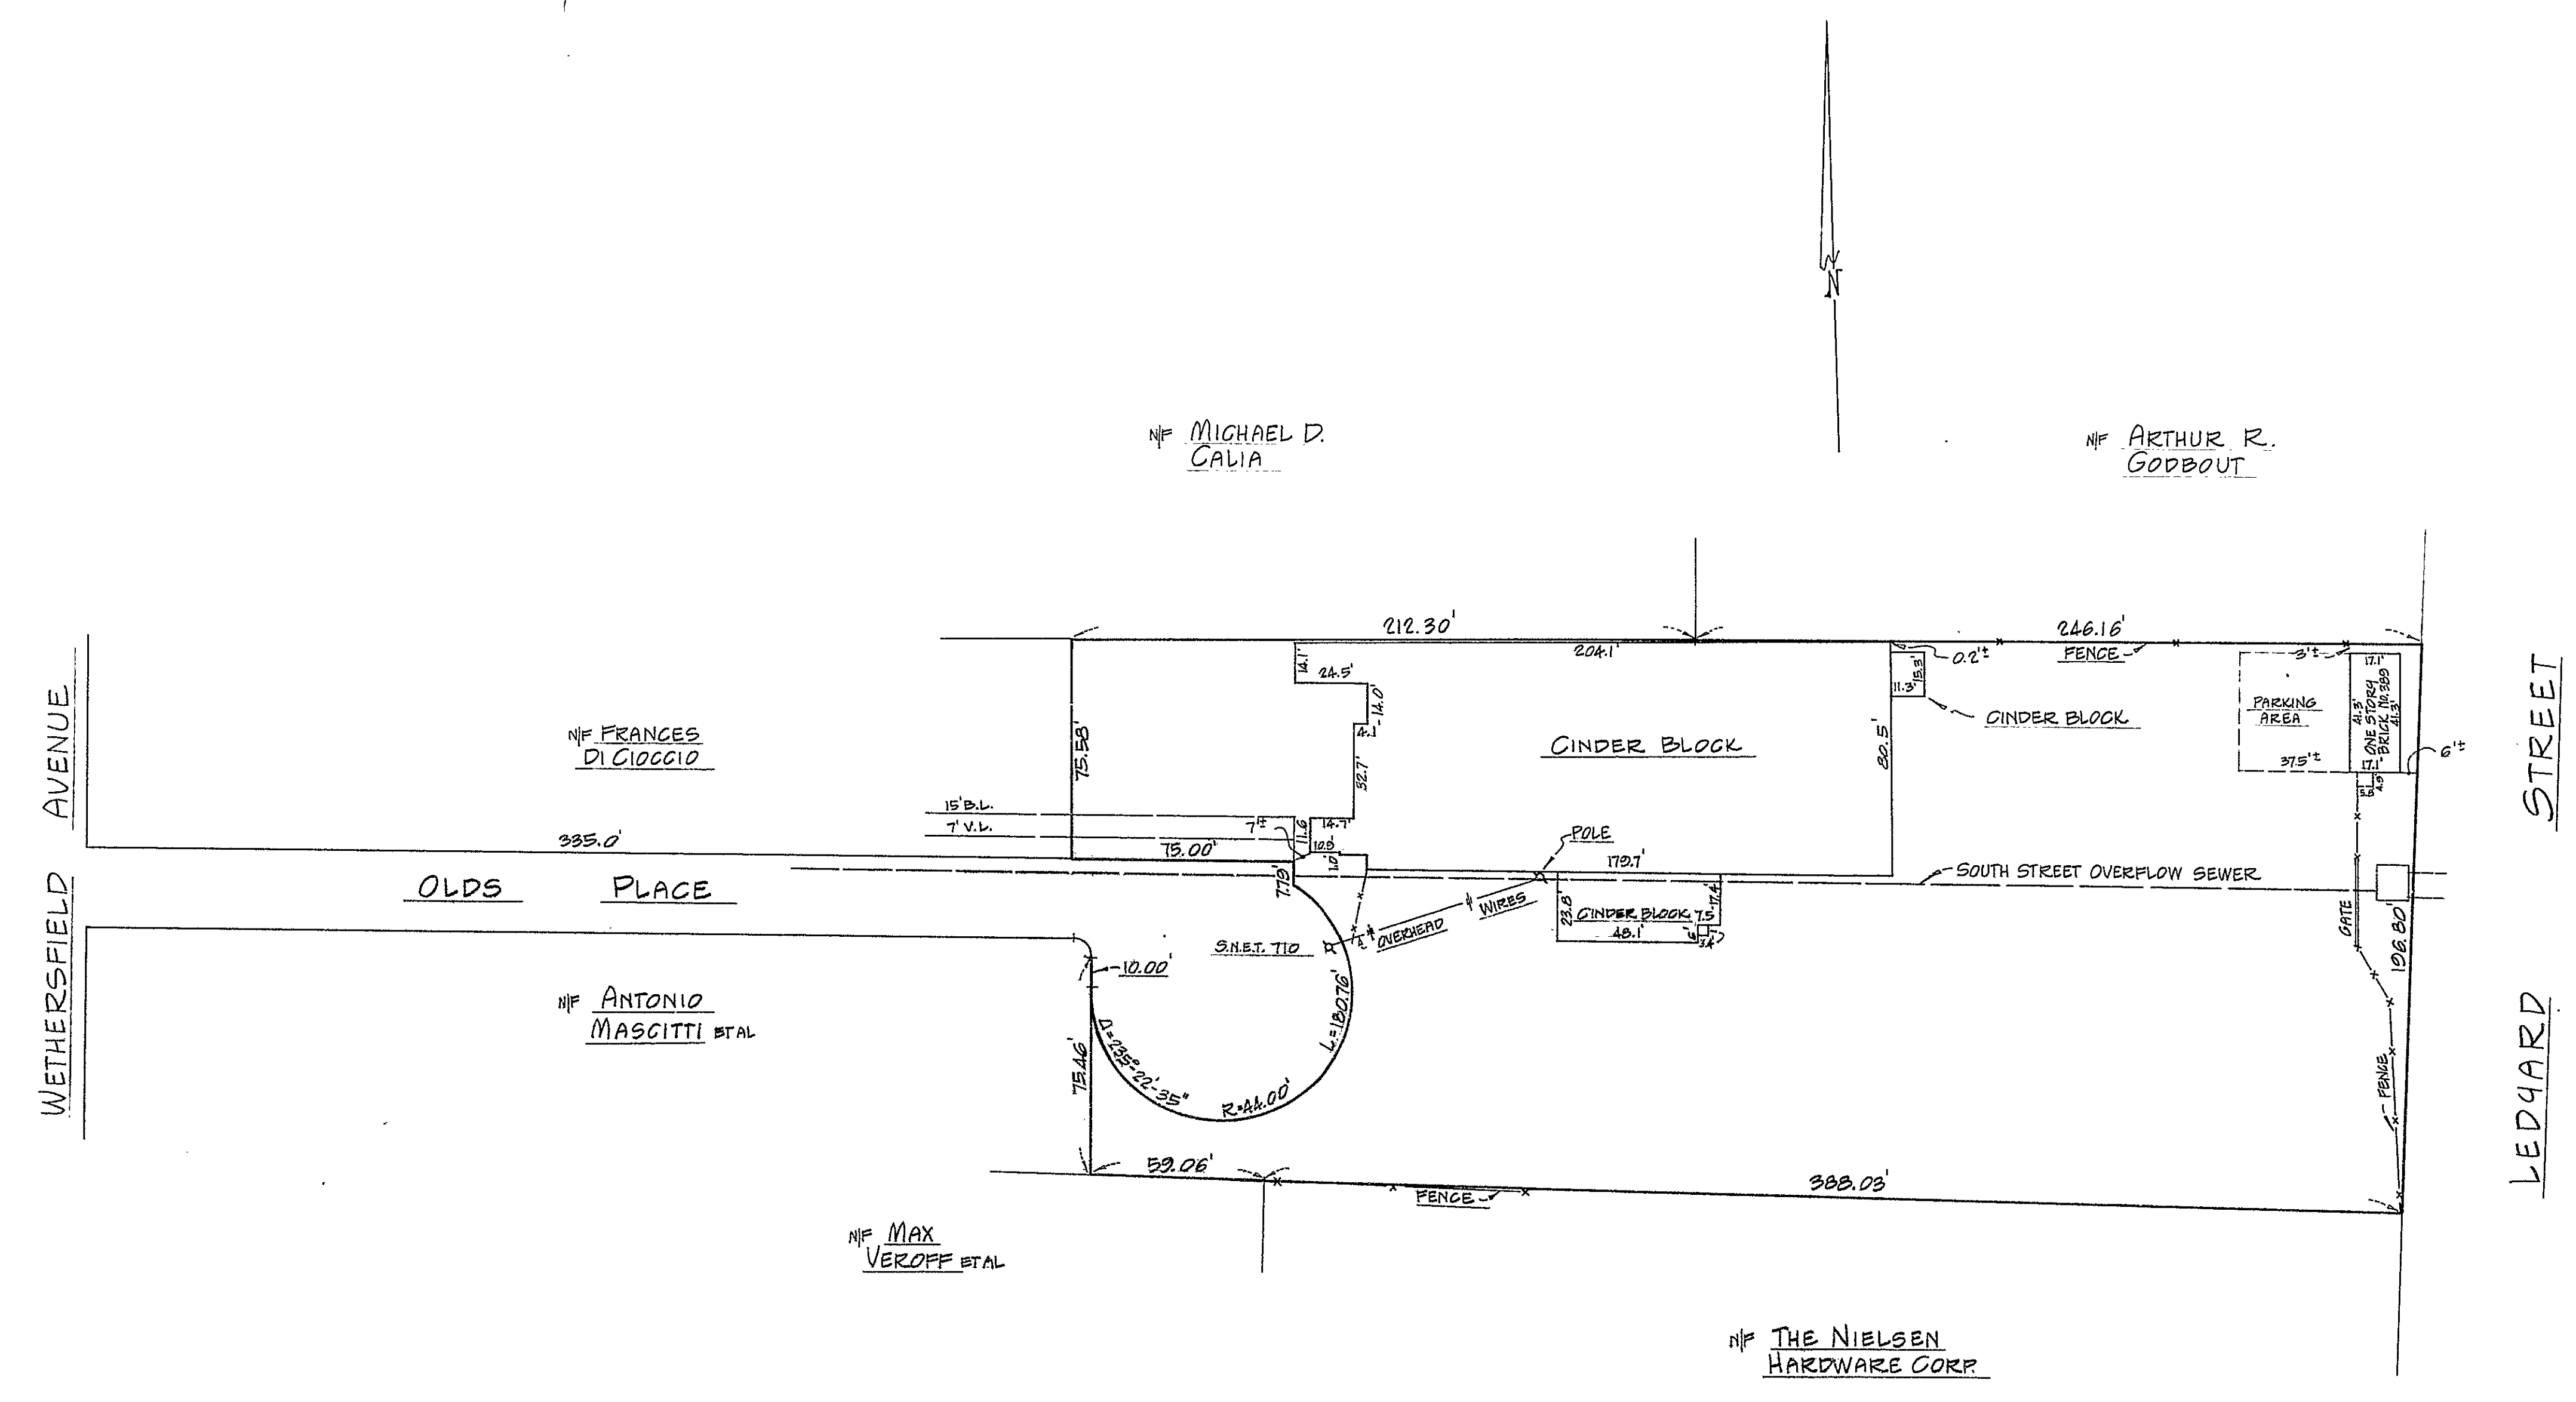


The portions of Wethersfield Avenue, Olds Place and Ledyard Street shown on this plan are established public streets of the City of Hartford.
Jan. 21, 1980

I hereby certify to
CONNECTICUT MUTUAL LIFE INSURANCE COMPANY,
FIRST AMERICAN TITLE INSURANCE COMPANY,
PLASTICRETE BLOCK & SUPPLY CORPORATION
that this map, which shows physical conditions existing at this date, is substantially correct in accordance with the standards of a Class 'D' survey and that zoning regulations are not violated other than those depicted hereon.
CLOSE, JENSEN & MILLER
Civil Engineers & Surveyors
By John H. Miller

Designed	 Close, Jensen & Miller Consulting Engineers, Land Planners & Surveyors 449 Silas Deane Highway Wethersfield, Connecticut 06109	MORTGAGE SURVEY PROPERTY OF PLASTICRETE BLOCK & SUPPLY CORPORATION 389 LEDYARD STREET OLDS PLACE HARTFORD CONNECTICUT		Sheet No.	
Drawn R.B.D.				Of	
Checked J.H.M.				File No.	
Date JAN. 1, 1980					
Scale 1"=40'					

No.	Date	Description
Revisions		

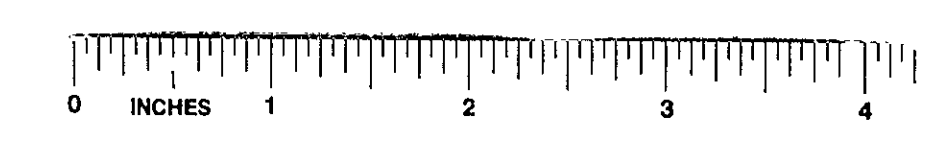

1087