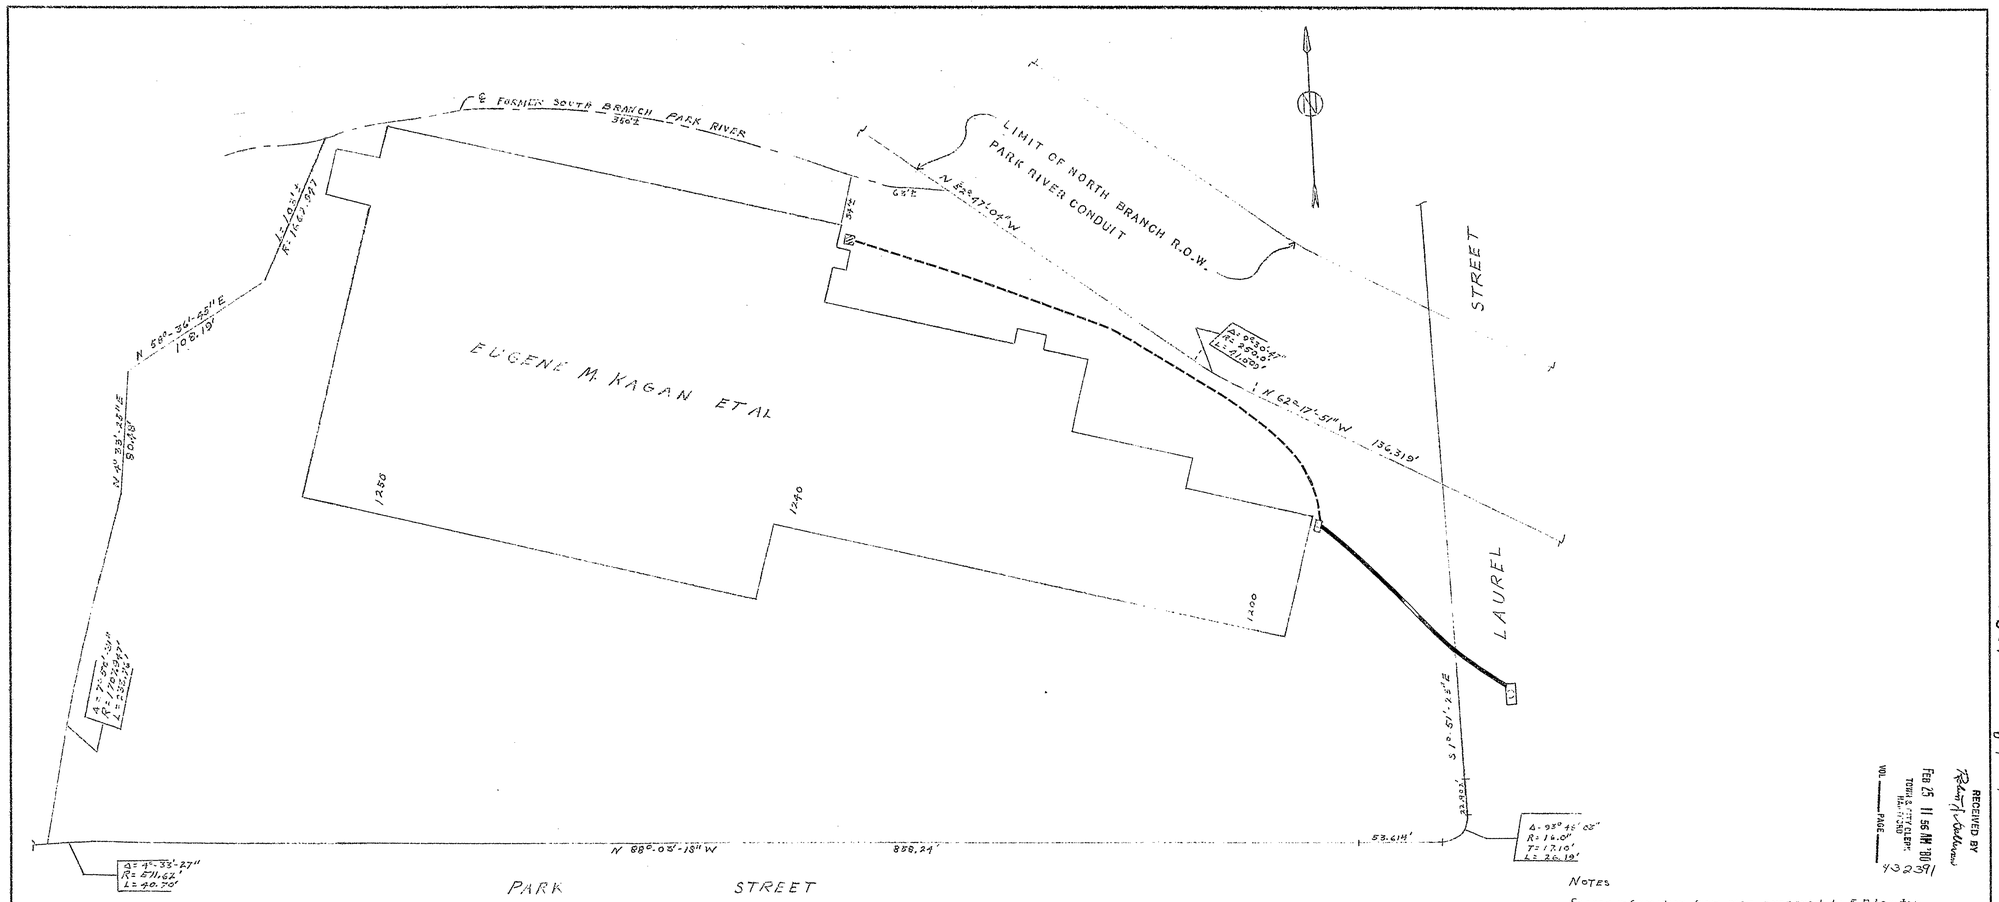


LEGEND

- TRANSFORMER
- SWITCH
- 6-CONDUIT
- 2-CONDUIT
- MANHOLE

Notes

Survey information from map prepared by E.P. Lawton R.E. & L.S. entitled "Greater Hartford Flood Commission Map showing Rights of Way and Riparian Rights acquired from The Billings & Spencer Co. for proposed conduit extensions - North & South Branches of the Park River Hartford, Conn. Dated October 1962.

Survey information from map prepared by Close, Jensen & Miller entitled "Property of Irving Eisenbaum, etal Park Street-Laurel Street Hartford, Conn" Dated September 1968

The portions of Park Street and Laurel Street shown on this plan are established public streets of the City of Hartford.

Feb 27, 1980

City Engineer

THE UNDERSIGNED UTILITY COMPANIES CERTIFY THIS MAP TO BE SUBSTANTIALLY CORRECT AND IN ACCORDANCE WITH CLASS D OF THE CONNECTICUT STANDARDS, 1975

THE HARTFORD ELECTRIC LIGHT COMPANY

BY Donald F. Polonski

| NO. | DATE | DESCRIPTION | BY |
|---|---|---|---|
| | | | |

REVISIONS

**THE HARTFORD ELECTRIC LIGHT CO.**

SKETCH SHOWING FACILITIES OF THE HARTFORD ELECTRIC LIGHT CO. ON THE PROPERTY OF EUGENE M. KAGAN, IRVING EISENBAUM AND FRANK BESSONI AT 1200-1250 PARK ST., HARTFORD, CONN.

DRAWN BY D.F.P. APPROVED BY
SCALE 1" = 40'
DATE 1-14-80 NO. 003H0003

RECEIVED BY Robert J. Cadieux
Feb 25 11 56 AM '80
TOWN & CITY CLERK'S OFFICE HARTFORD
VOL. PAGE
432391

EASTERN CORP. IRVING CO.
1090
EPK 14

1090 # 69