



RECEIVED BY
Feb 25 2 56 PM '80
TOWN OF
VOL. PAGE
1344

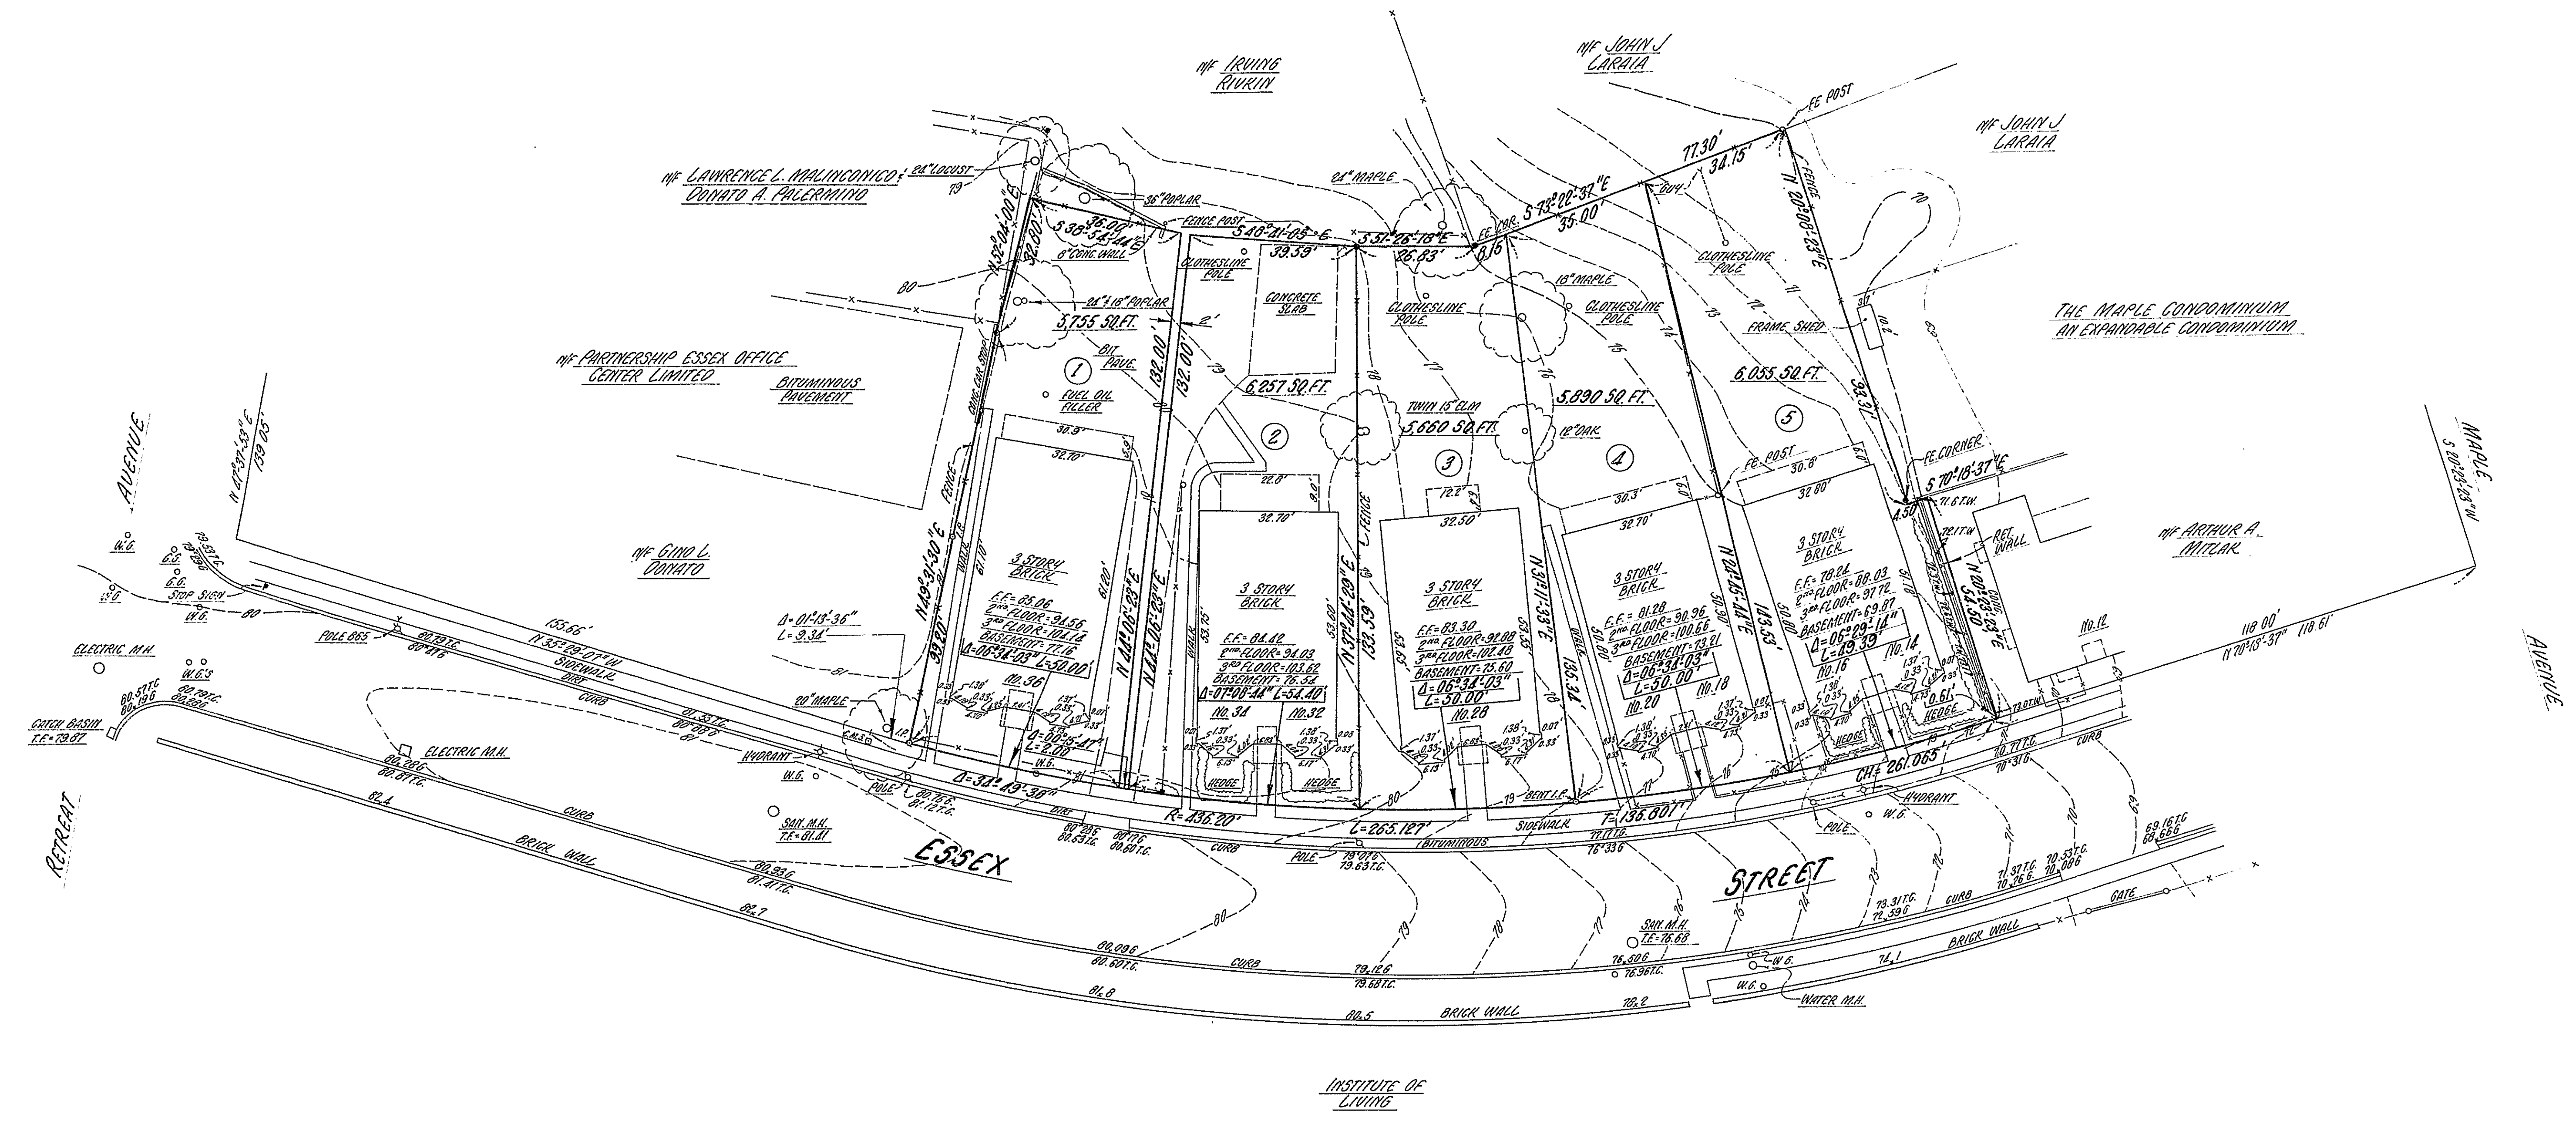

The portions of Retreat Avenue, Essex Street and Maple Avenue shown on this plan are established public streets of the City of Hartford.
Feb 26, 1980
City Engineer

Designed
Drawn R.B.B.
Checked J.H.M.
Date Feb. 1980
Scale 1"=20'


Close, Jensen & Miller
Consulting Engineers, Land Planners & Surveyors
449 Silas Deane Highway
Wethersfield, Connecticut 06109

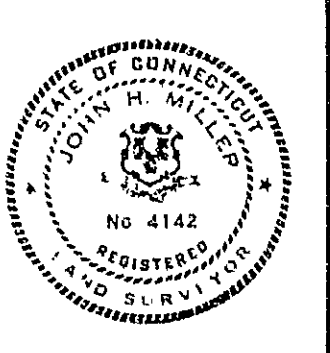

"THE ESSEX CONDOMINIUM"
ESSEX STREET
HARTFORD, CONNECTICUT

LEGEND
T.M. = ELEVATION ON TOP OF WALL
E.G. = GAS GATE
W.G. = WATER GATE
--- = FENCE LINE
T.C. = ELEVATION ON TOP OF CURB
G. = ELEVATION IN GUTTER
① = PARCEL NUMBERS

Sheet No.	
1	
Of 1	
File No.	
No.	Date
Description	
Revisions	

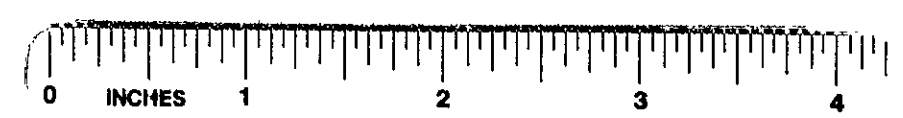

1092

174

1092