


RECEIVED BY
Mar 10 3 05 PM '80
TOL
VOL PAGE

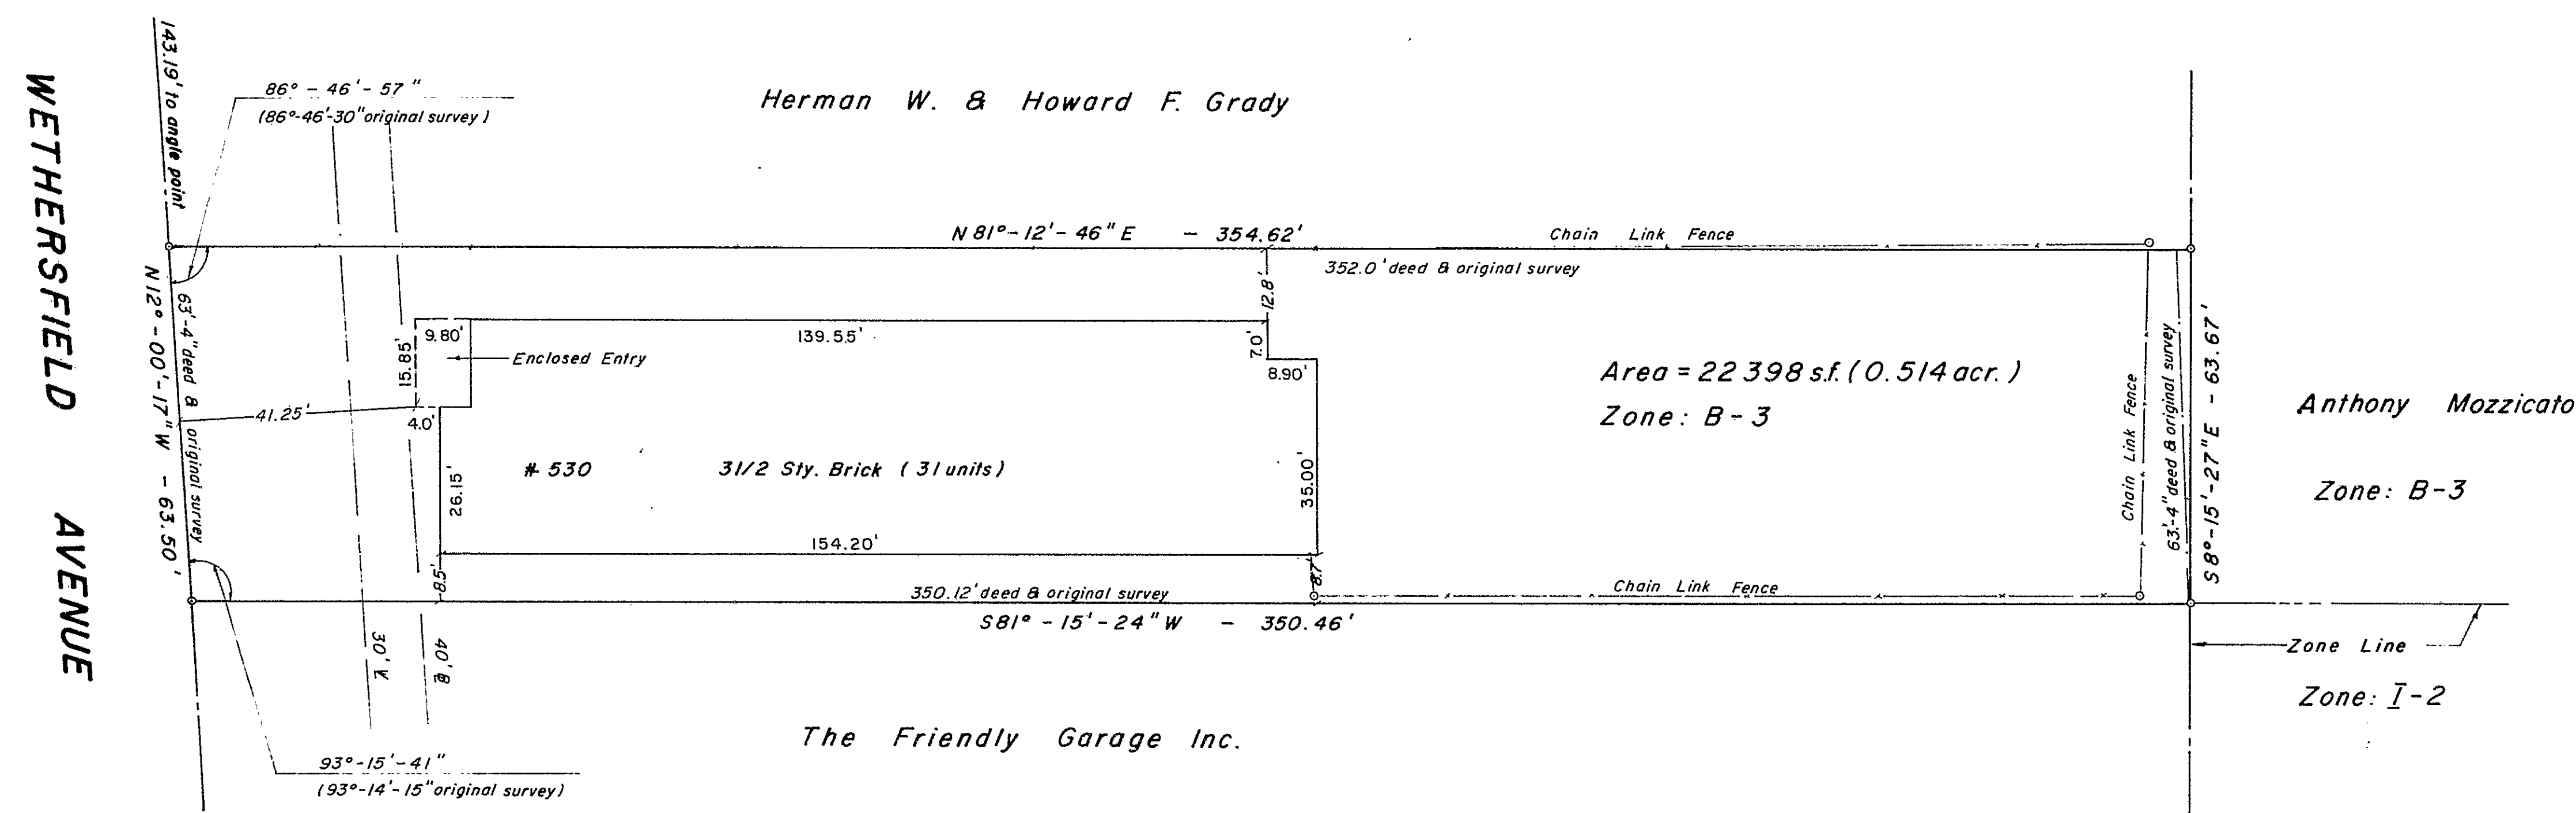

The portion of Wethersfield Avenue shown on this plan is an established public street of the City of Hartford.

Mar. 14, 1980

George E. Hyman
City Engineer

NOTE: Perimeter as shown (revised from original survey & deed information) is in accordance with map entitled 'Map of Lands East Side of Wethersfield Avenue - Nos. 510 to 554 & Ledyard St. Hartford, Conn. Scale: 1"=20' Date: Jan. 24, 1974 Daybook #010416 by Department of Public Works Bureau of Engineering Services City of Hartford Certified by F.T. D'Onofrio, L.S.'

I HEREBY CERTIFY THAT THIS MAP AND SURVEY WERE PREPARED IN ACCORDANCE WITH THE STANDARDS OF A CLASS A-2 SURVEY AS DEFINED IN THE CODE OF PRACTICE FOR STANDARDS OF ACCURACY OF SURVEYS AND MAPS, ADOPTED DECEMBER 10, 1975 AS AMENDED BY THE CONNECTICUT ASSOCIATION OF LAND SURVEYORS, INC.



3-6-80 3756
DATE REGISTRATION NO.

SURVEY MAP
Property of
AETNA APARTMENTS
COOPERATIVE CORPORATION
530 WETHERSFIELD AVENUE
HARTFORD, CONNECTICUT

IGOR VECHESLOFF
PROFESSIONAL ENGINEER & LAND SURVEYOR
51 LORRAINE STREET
HARTFORD, CONNECTICUT
SCALE 1" = 20' DATE 3-6-80
DRAWING NO. 1050

0 INCHES 1 2 3 4

1094

73