

1100

1100-1


RECEIVED BY

Robert A. Belliveau.

1963-1964

1000

val PAGE

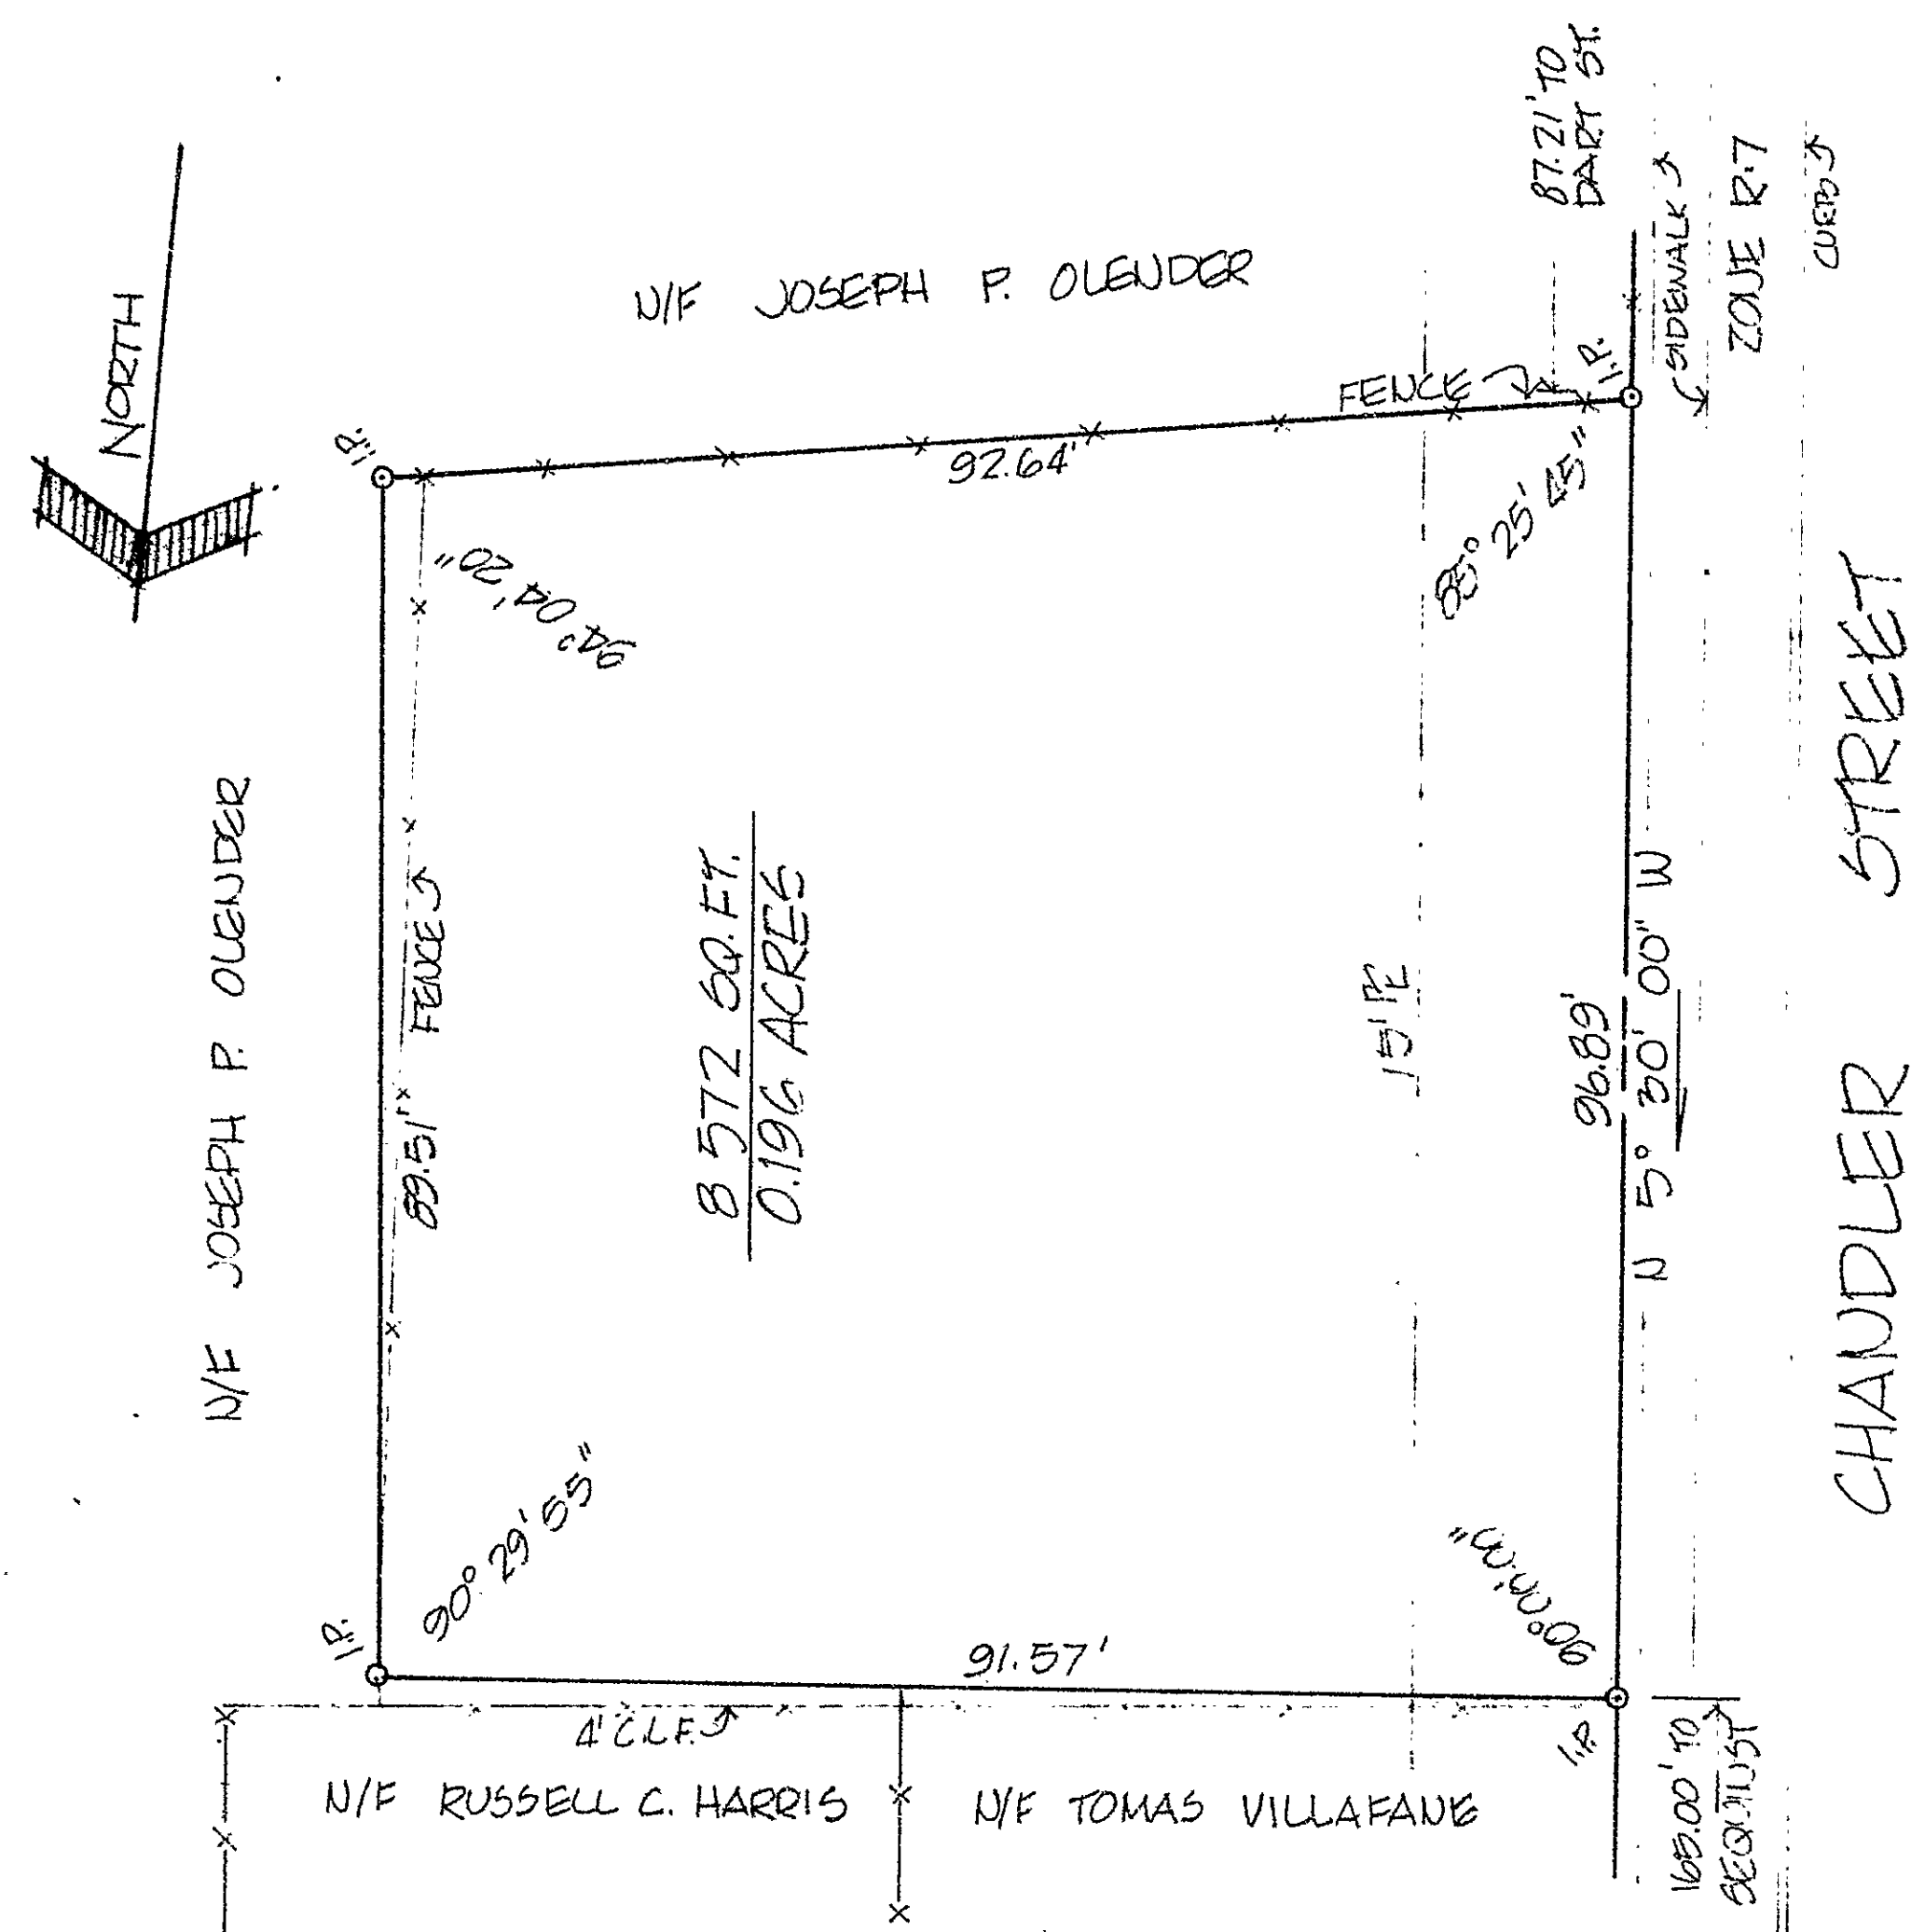

SURVEY  
PROPERTY TO BE  
CONVEYED TO

RAOUL & JOYCE HEBERT

CHAUDLER STREET  
HARTFORD, CONN.  
DECEMBER 1979 11/1/20

I HEREBY CERTIFY THIS MAP TO BE SUBSTANTIALLY CORRECT WITHIN THE STANDARDS OF A CLASS A-2 SURVEY.

John J. Lawrence 125  
JOHN J. LAWRENCE DR. PEKS

*The portion of Chandler Street shown on this plan is an established public street of the City of Hartford.*

Feb. 15, 1980

166

1100

