


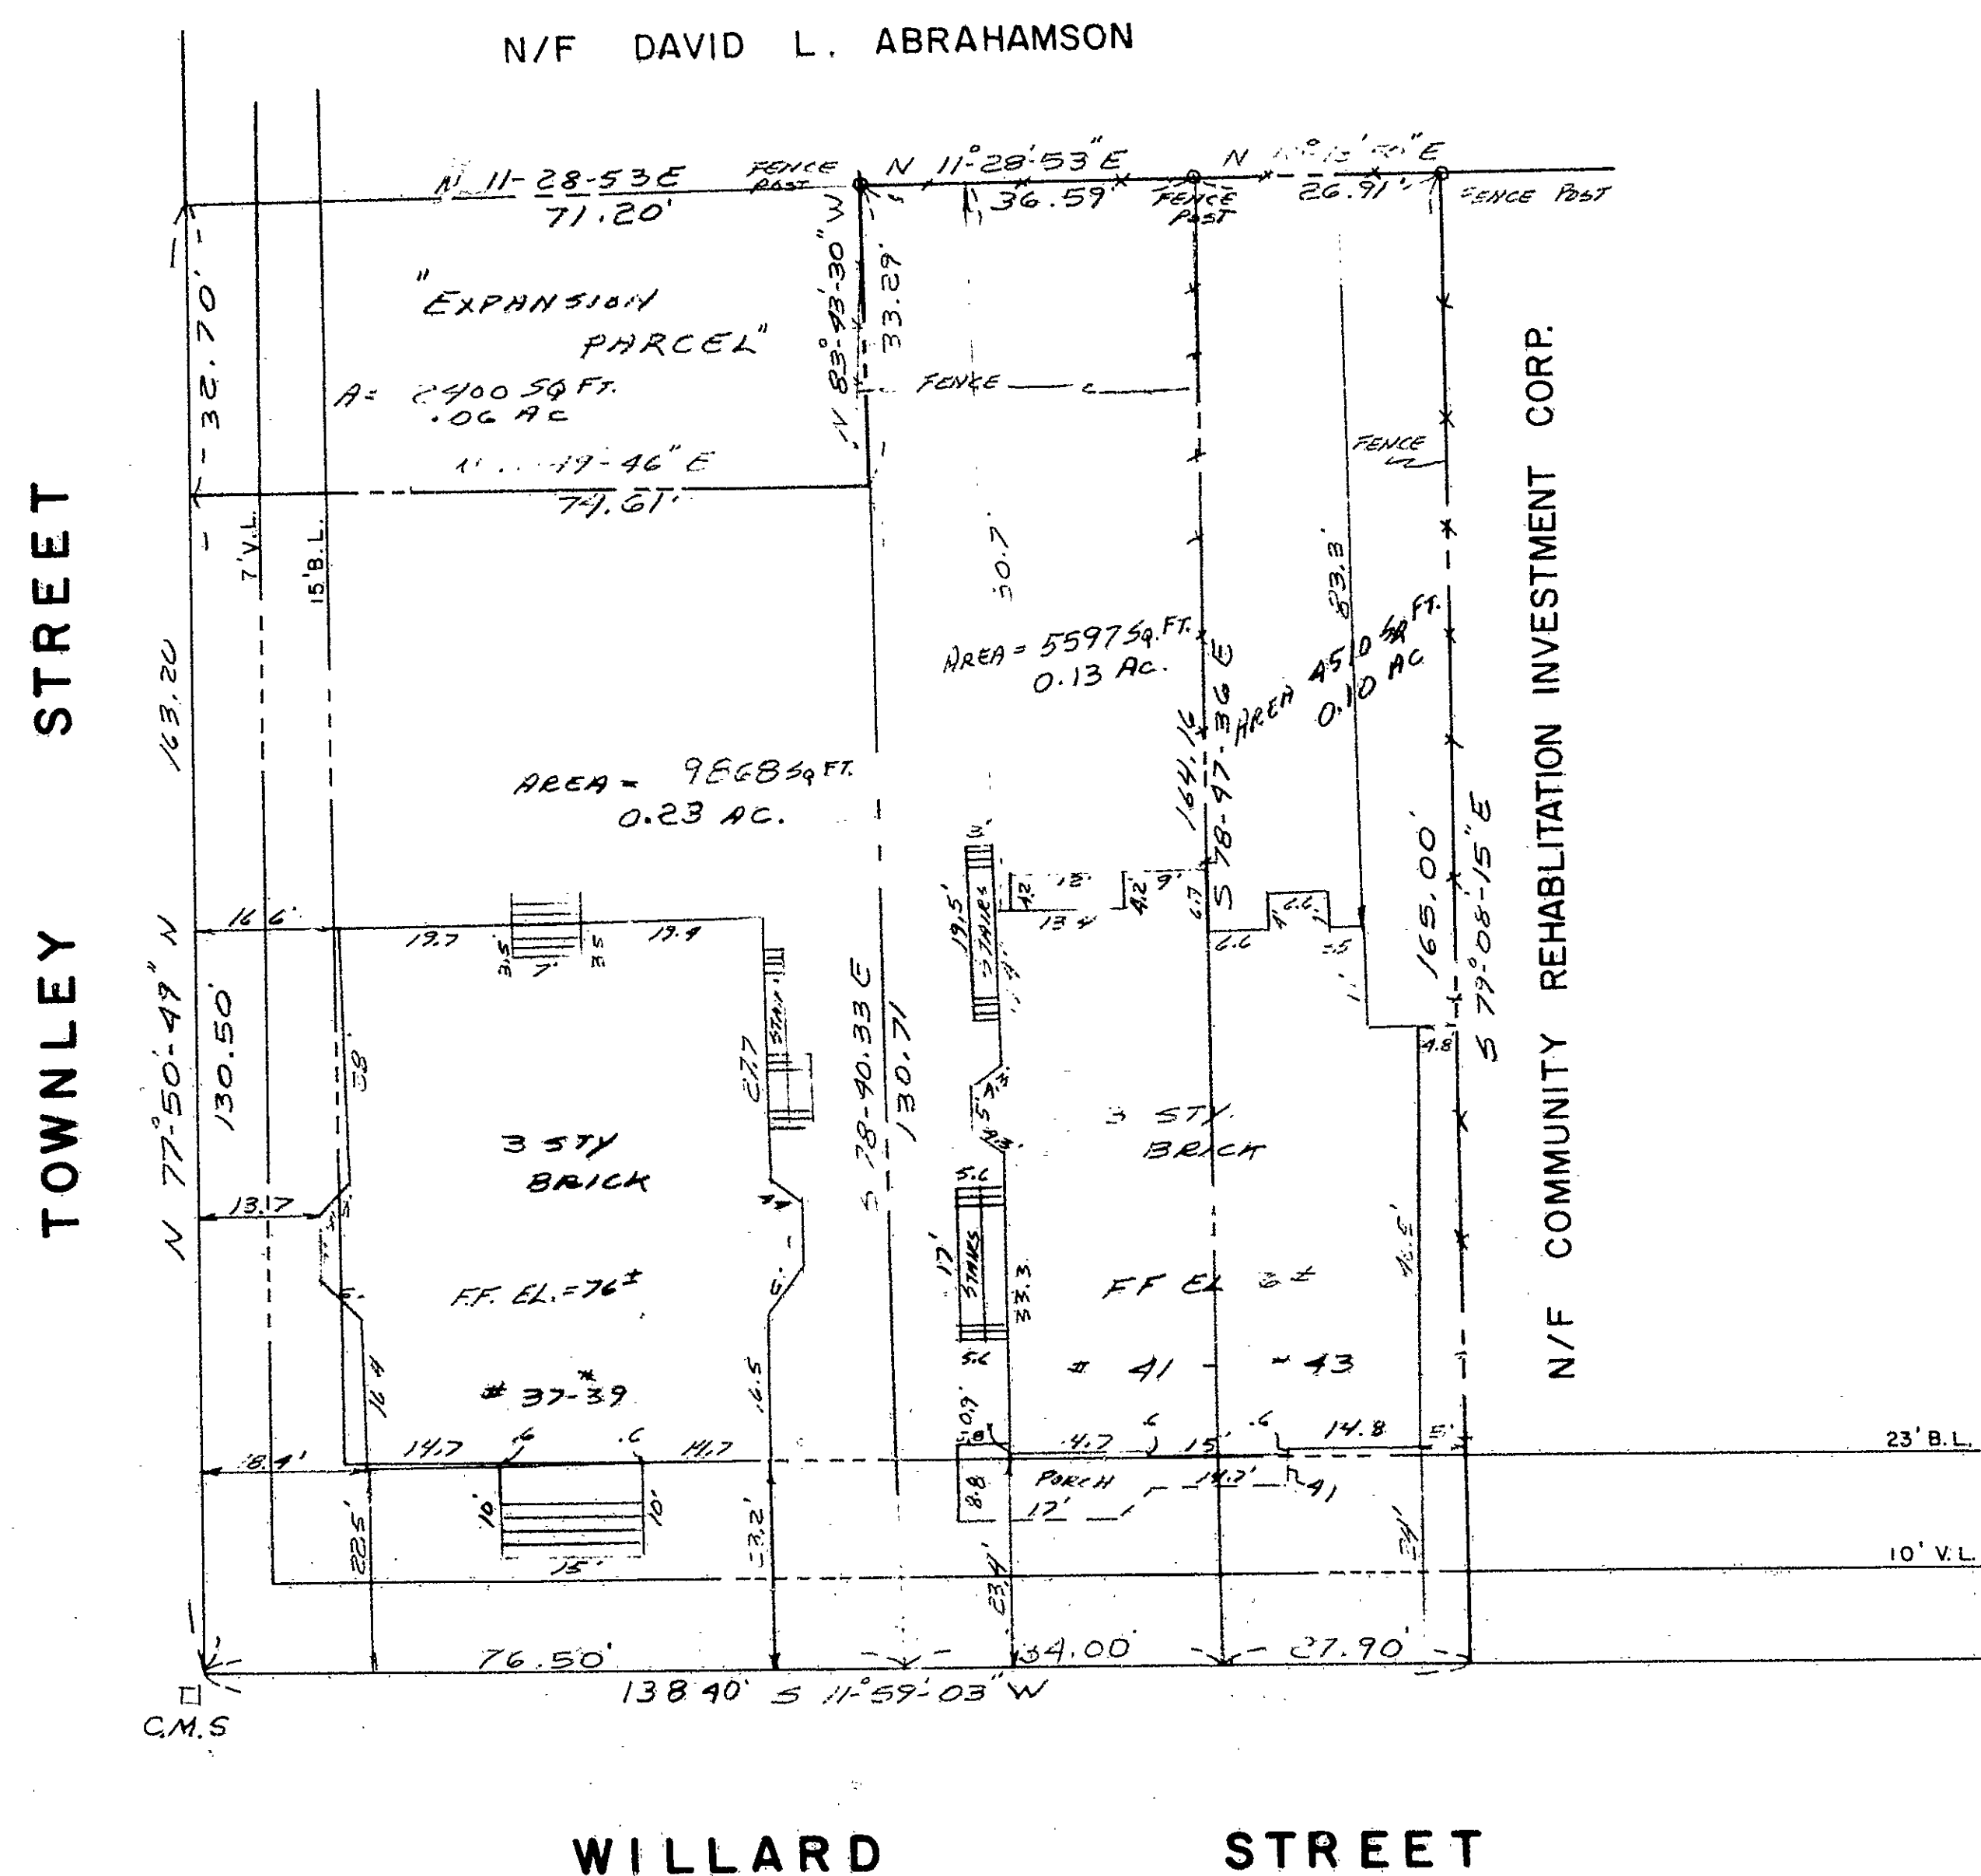

NOTE:
ALL OFFSET DISTANCES ARE
PERPENDICULAR TO THE
STREET LINES OR PROPERTY
LINES
MPC DATUM USED
ZONE RO-2

The portions of Townley Street and
Willard Street shown on this plan are
established public streets of
the City of Hartford.

April 25, 1980

George C. Hoffman
City Engineer

I HEREBY CERTIFY THAT THIS MAP AND SURVEY
WERE PREPARED IN ACCORDANCE WITH THE
STANDARDS OF A CLASS A-2 SURVEY AS DEFINED
IN THE CODE OF PRACTICE FOR STANDARDS OF
ACCURACY OF SURVEYS AND MAPS, ADOPTED
DECEMBER 10, 1975 AS AMENDED BY THE
CONNECTICUT ASSOCIATION OF LAND SURVEYORS INC.

Peter D. Flynn

REV 4-18-80

PROPERTY MAP OF			
WILLARD PLACE - AN			
EXPANDABLE CONDOMINIUM			
37.39, 41.84, 43 WILLARD ST.			
HARTFORD CONNECTICUT			
date: 11/9/79	drawn by: CC	job no: 79172	
scale: 1"=20'	checked by: PDF	sheet no: 1 of 1	
F A HESKETH & ASSOCIATES • ENGINEERS			
101 Millbrook Common Bloomfield, CT 06005 • SURVEYORS			



1102

82