

1104-1

RECEIVED BY
Robert A. Sullivan

APR 14 3 52 PM '80

TOWN OF HARTFORD
PLAT 150

VOL. _____ PAGE _____

4/3/80

N/F CITY OF HARTFORD


Street Line

Conc. Curb

4' Chain Link Fence

MORRIS STREET

WETHERSFIELD AVENUE

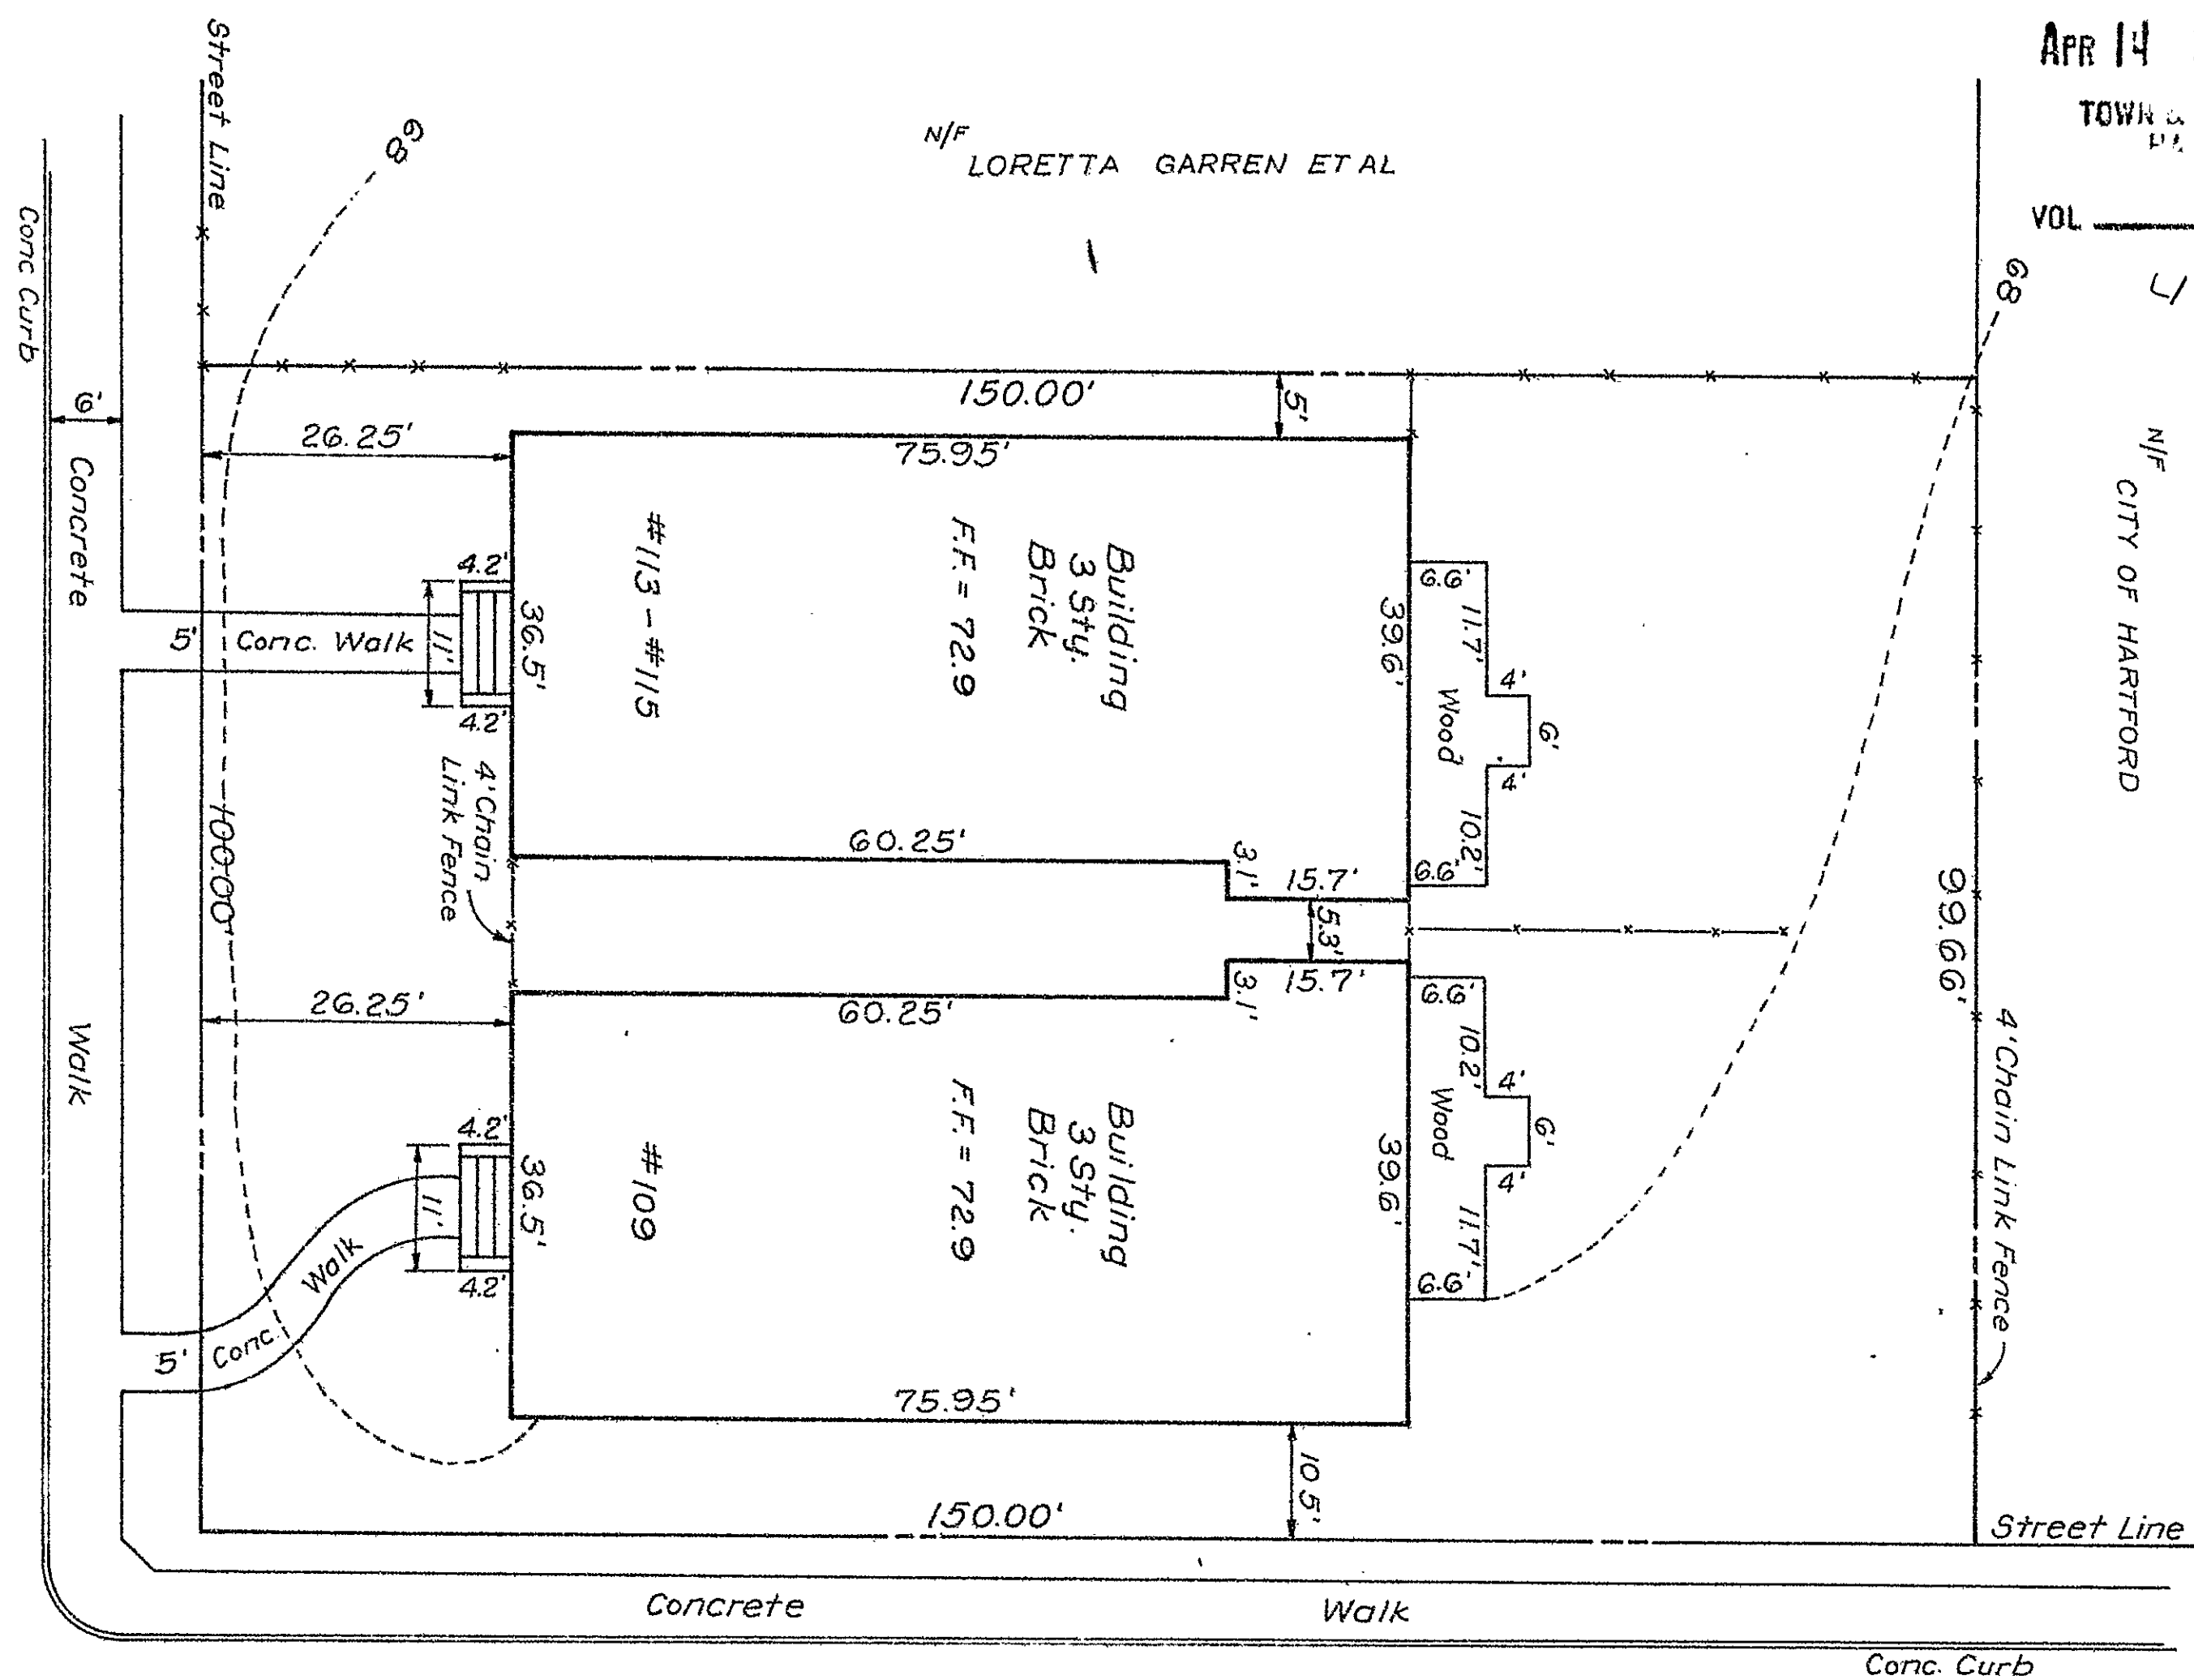

WETHERSFIELD AVENUE

WETHERSFIELD AVENUE

PROPERTY OF

PETER DUNN

109-115 WETHERSFIELD AVENUE
HARTFORD, CONNECTICUT

SCALE 1" = 20' MARCH 1980

Note:
Exterior Building Dimensions
Given Are Taken At The Basement
Level.
The Portions of Wethersfield Avenue
and Morris Street shown on this plan
are established public streets of the
City of Hartford.
Apr. 16, 1980
George S. Luzzi
City Engineer

PREPARED BY
JAMES J. LUZZI
CONSULTING ENGINEER & LAND SURVEYOR
412 WEST AVON ROAD
AVON, CONNECTICUT

Certified Substantially Correct

James J. Luzzi

~~2004~~ 1104

80-19 B

1104
EAST FILE COMP. IRVINE, CA
EPM 34