

Selborne G. &
Susan K. Brown

Edward D. Powers


Society for Savings

Deal T. Aseltine Jr.

Zone R-2
Area = 35 577s.f. (0.817ac.)

American Heart Association
of Greater Hartford, Inc.

ATWOOD CONDOMINIUMS HARTFORD, CONN.

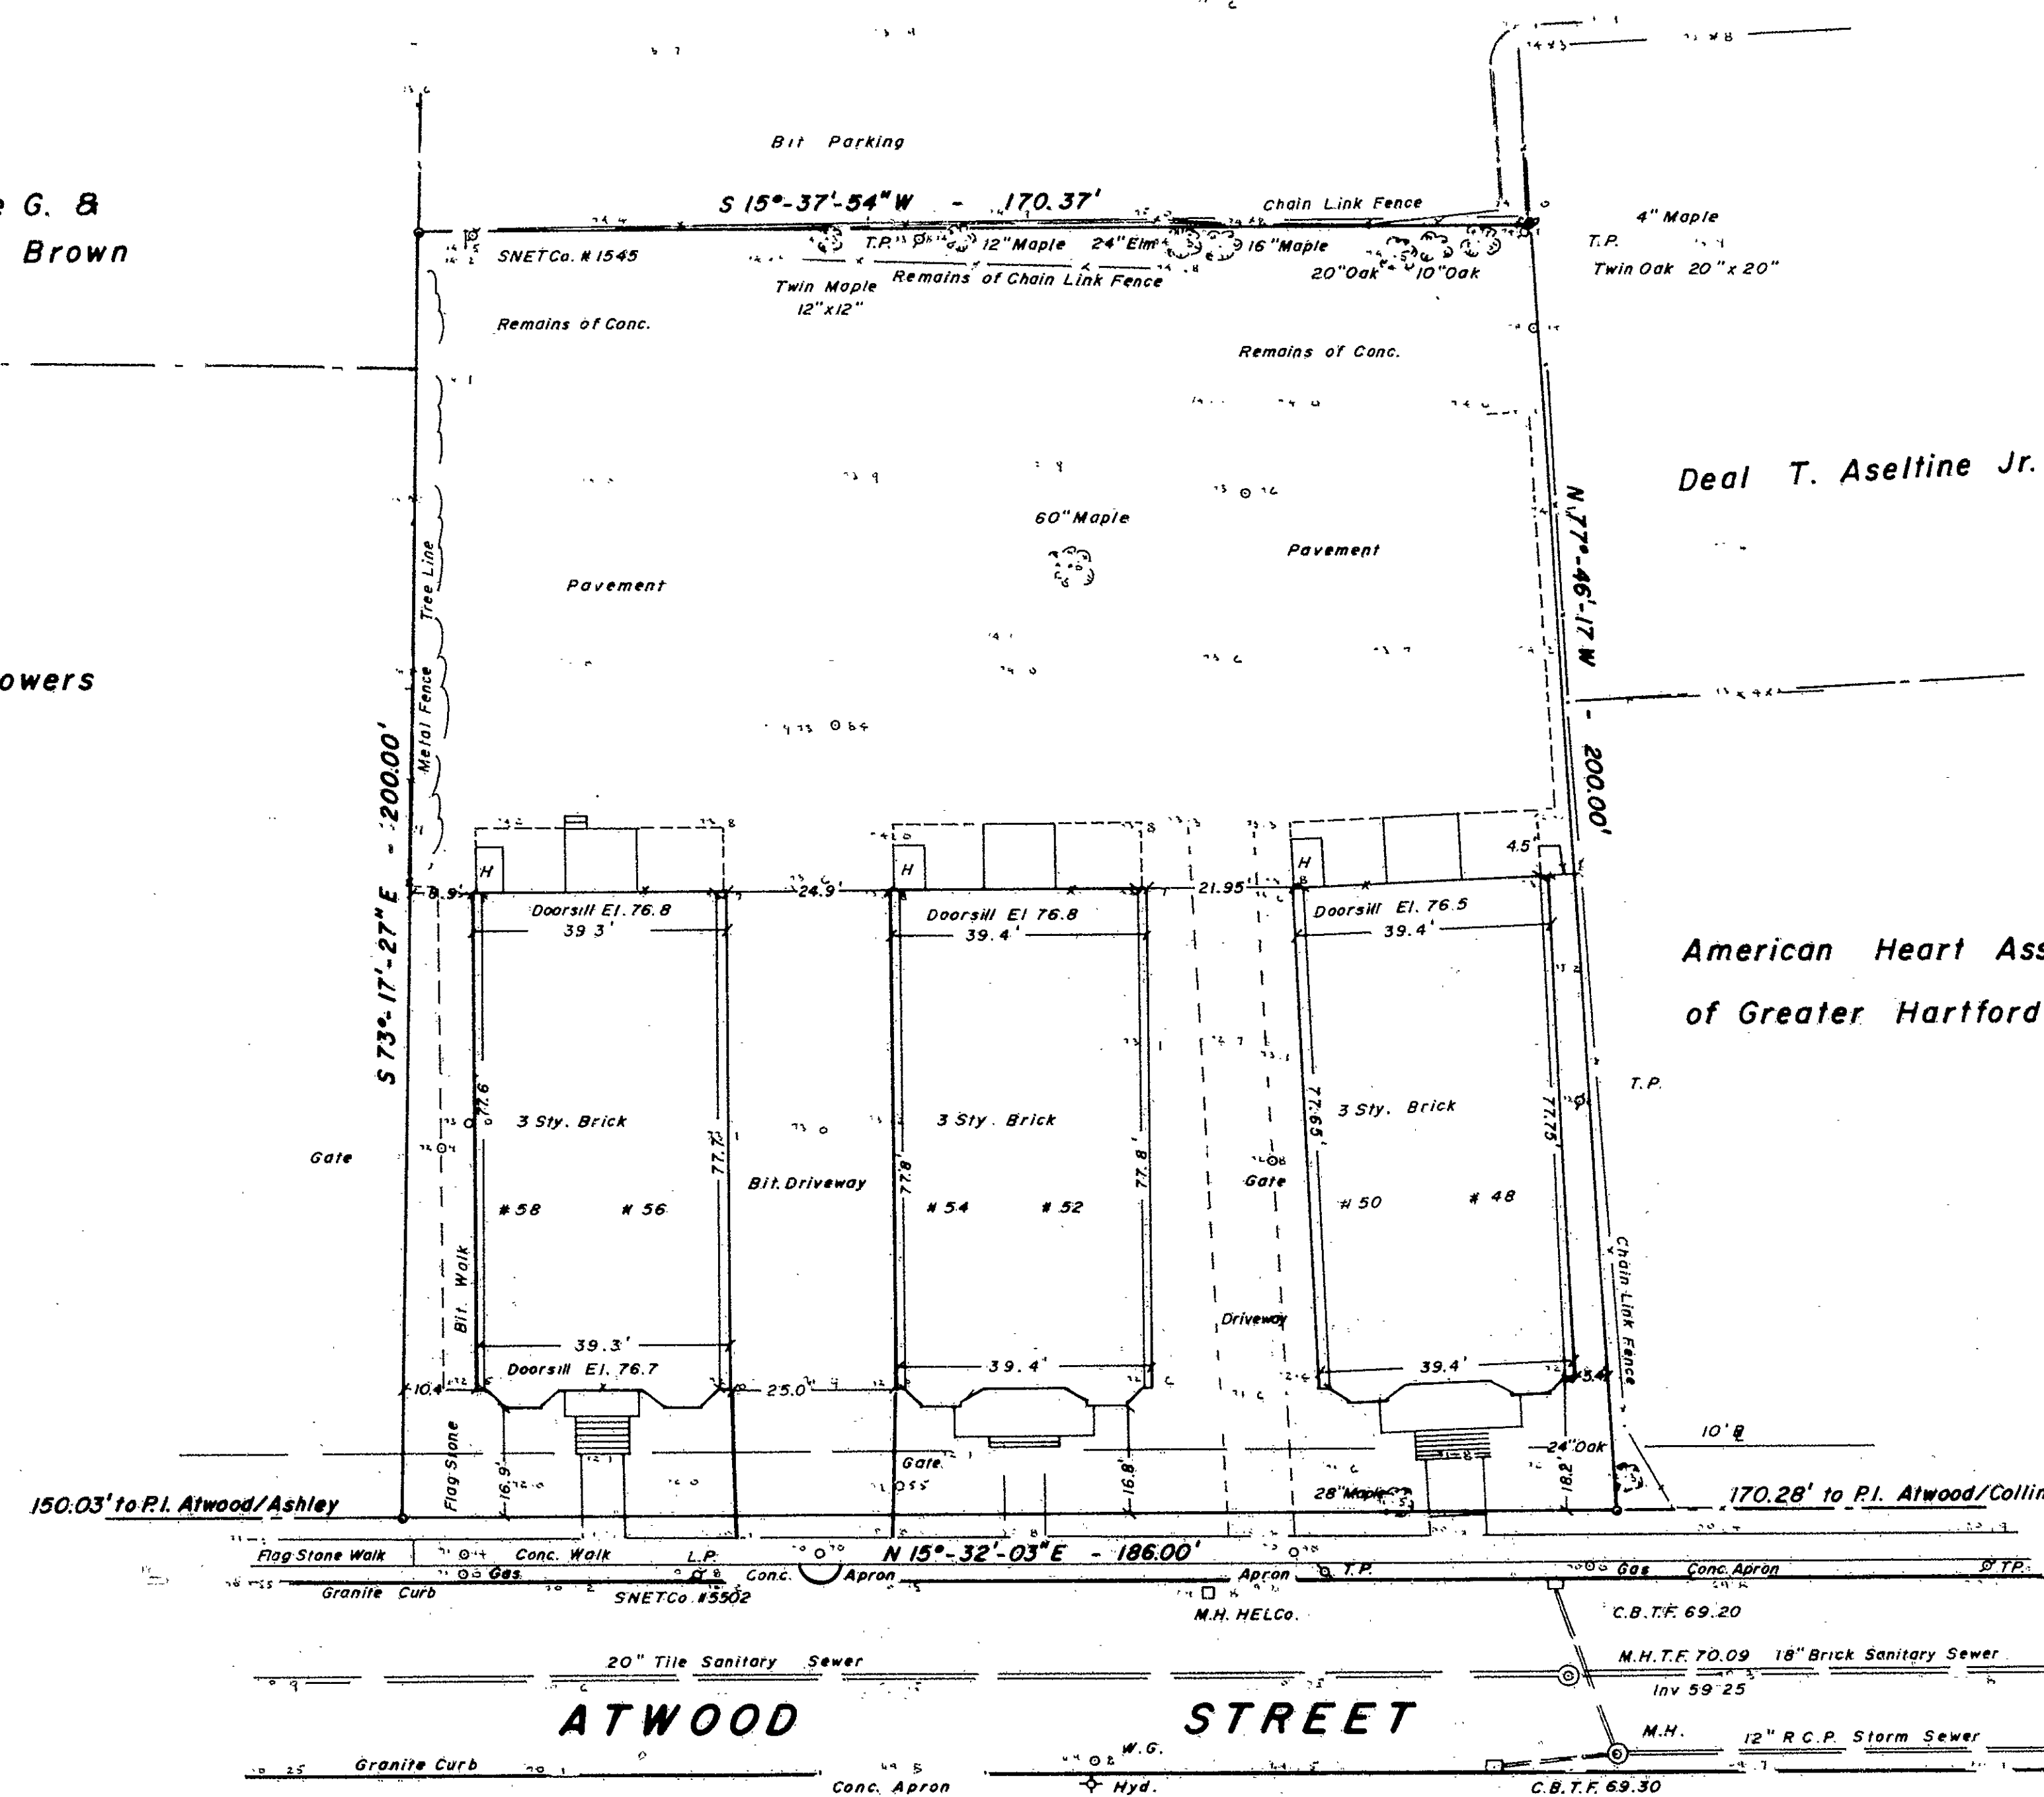

NOTE:
Elevation based on MDC Datum
Mon. HH-97 El. 71.44

The portion of Atwood Street shown
on this plan is an established public
street of the City of Hartford.

Aug. 20, 1980
[Signature]
City Engineer

I HEREBY CERTIFY THAT THIS MAP AND SURVEY WERE PREPARED IN ACCORDANCE
WITH THE STANDARDS OF A CLASS A-2 SURVEYING MAPS, ADOPTED
PRACTICE FOR STANDARDS OF ACCURACY OF SURVEYING MAPS, ADOPTED
DECEMBER 10, 1975 AS AMENDED BY THE ASSOCIATION OF LAND
SURVEYORS, INC.

IGOR VECHESSLOFF
PROFESSIONAL ENGINEER & LAND SURVEYOR
51 LORRAINE STREET
HARTFORD, CONNECTICUT
SCALE 1" = 20'
DATE 8-11-80
DRAWING NO. 1836

