RECEIVED BY
Robert J. Anderson
Aug 21 2 40 PM '80
TOWN & CITY CLERK'S RECORD
VOL. ____ PAGE ____
438549

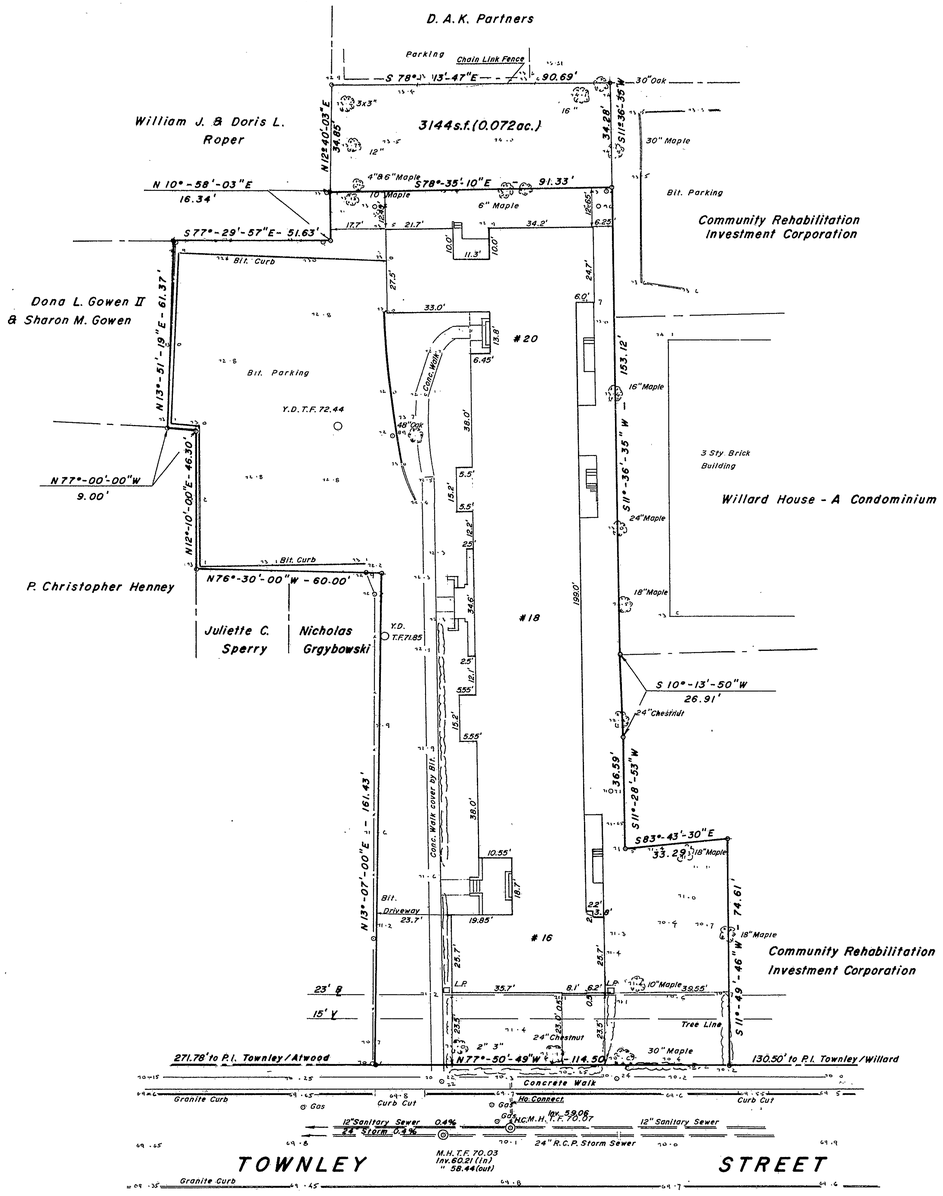

Zone RO-2

Area = 32 033 s.f. (0.735 ac.)

THE TOWNLEY STREET CONDOMINIUMS

HARTFORD, CONN.

The portion of Townley Street shown on this plan is an established public street of the City of Hartford.

August 22, 1980

City Engineer

NOTE:

Elevation based on M.D.C. Datum
Mon. HH-97 Elev. 71.44

I HEREBY CERTIFY THAT THIS MAP AND SURVEY WERE PREPARED IN ACCORDANCE WITH THE STANDARDS OF A CLASS A-2 SURVEY AS DEFINED IN THE CODE OF PRACTICE FOR STANDARDS OF ACCURACY OF SURVEYS AND MAPS, ADOPTED DECEMBER 10, 1975 AS AMENDED BY THE CONNECTICUT ASSOCIATION OF LAND SURVEYORS, INC.

SURVEYOR — DATE 8-11-80 — REGISTRATION NO. 3756

IGOR VECHESLOFF
PROFESSIONAL ENGINEER & LAND SURVEYOR
51 LORRAINE STREET
HARTFORD, CONNECTICUT

SCALE 1" = 20'	DATE 8-11-80
	DRAWING NO. 1835

1112

LOG FILE CORP. HARTFORD, CT.
EFF. 14